


SEE NOTE ON SHEET 447

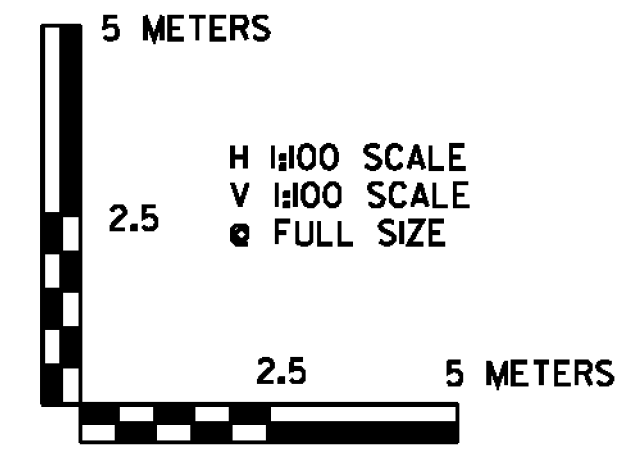

PROJECT NAME: BENNINGTON	PLOT DATE: 1/26/2010
PROJECT NUMBER: NH 019-(154)	DRAWN BY: STANTEC
FILE NAME: ...plot_files\zd307c4xs.7SB.ptf	CHECKED BY: GARY SANTY
DESIGN SUPERVISOR: GREG EDWARDS	SHEET 455 OF 468
DESIGNED BY: MARC FOISY	
US 7 SB CROSS SECTION SBX-09	

1/26/2010 4:58:52 PM v:\1953\getlive\19530002\transportation\drawings\comfr\001_4\plot_files\zd307c4xs_7SB.ptf