



SB 10+120

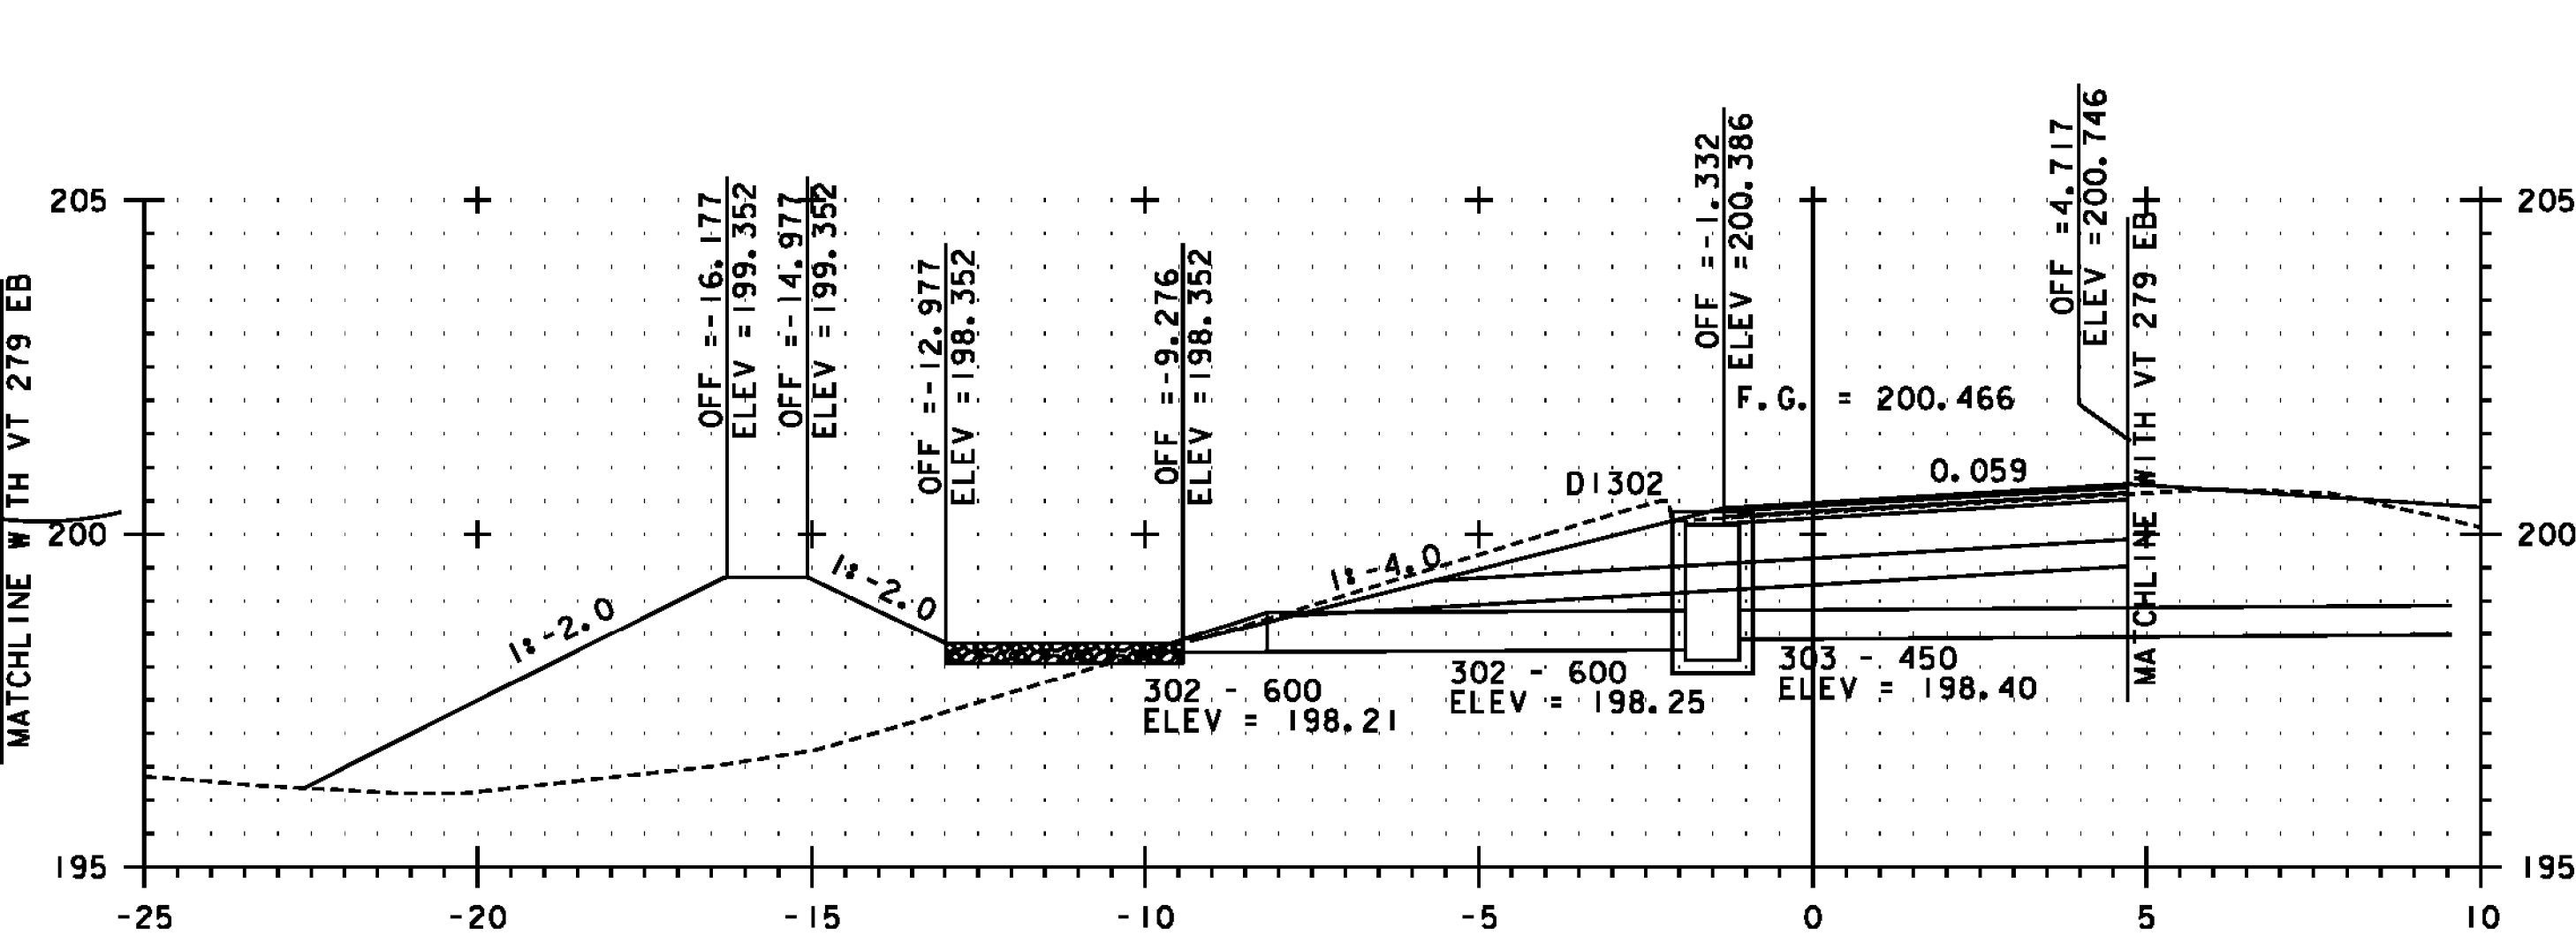


SB 10+140

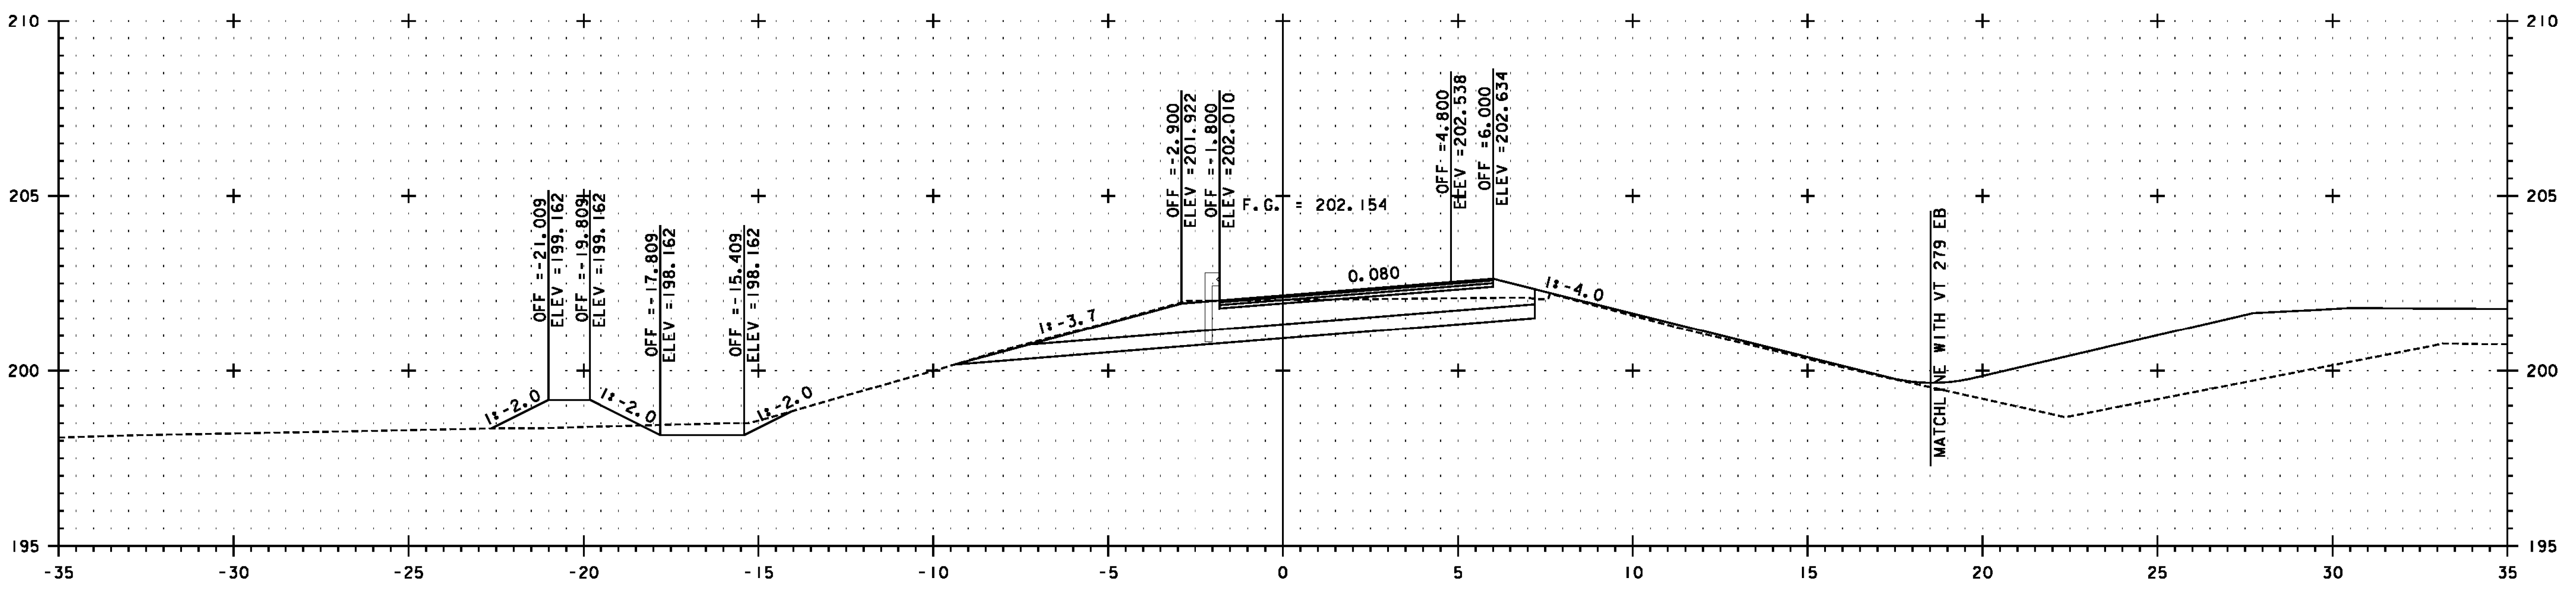

SB 10+100

SEE NOTE ON SHEET 447

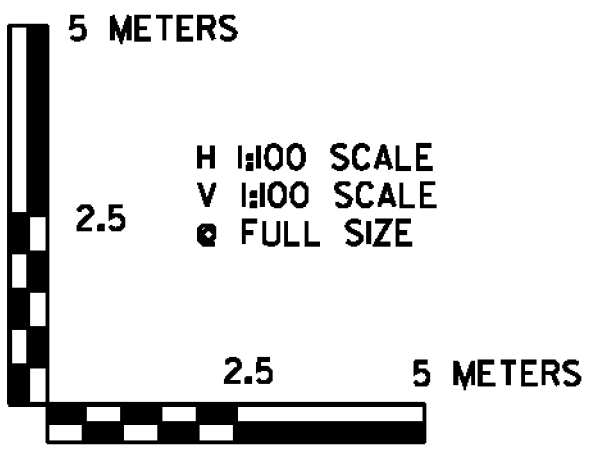

PROJECT NAME:	BENNINGTON	FILE NAME:	...plot_files\zd307c4xs.7SB.ptf	PLOT DATE:	1/26/2010
PROJECT NUMBER:	NH 019-(154)	DESIGN SUPERVISOR:	GREG EDWARDS	DRAWN BY:	STANTEC
		DESIGNED BY:	MARC FOISY	CHECKED BY:	GARY SANTY
			US 7 SB CROSS SECTION SBX-10	SHEET	456 OF 468

1/26/2010 4:58:53 PM v:\1953\getlive\1953\0002\tr\anspor\rotation\dr\cm\ng\comfr\c01_4\plot_files\zd307c4xs_7SB.ptf