




SB 10+600

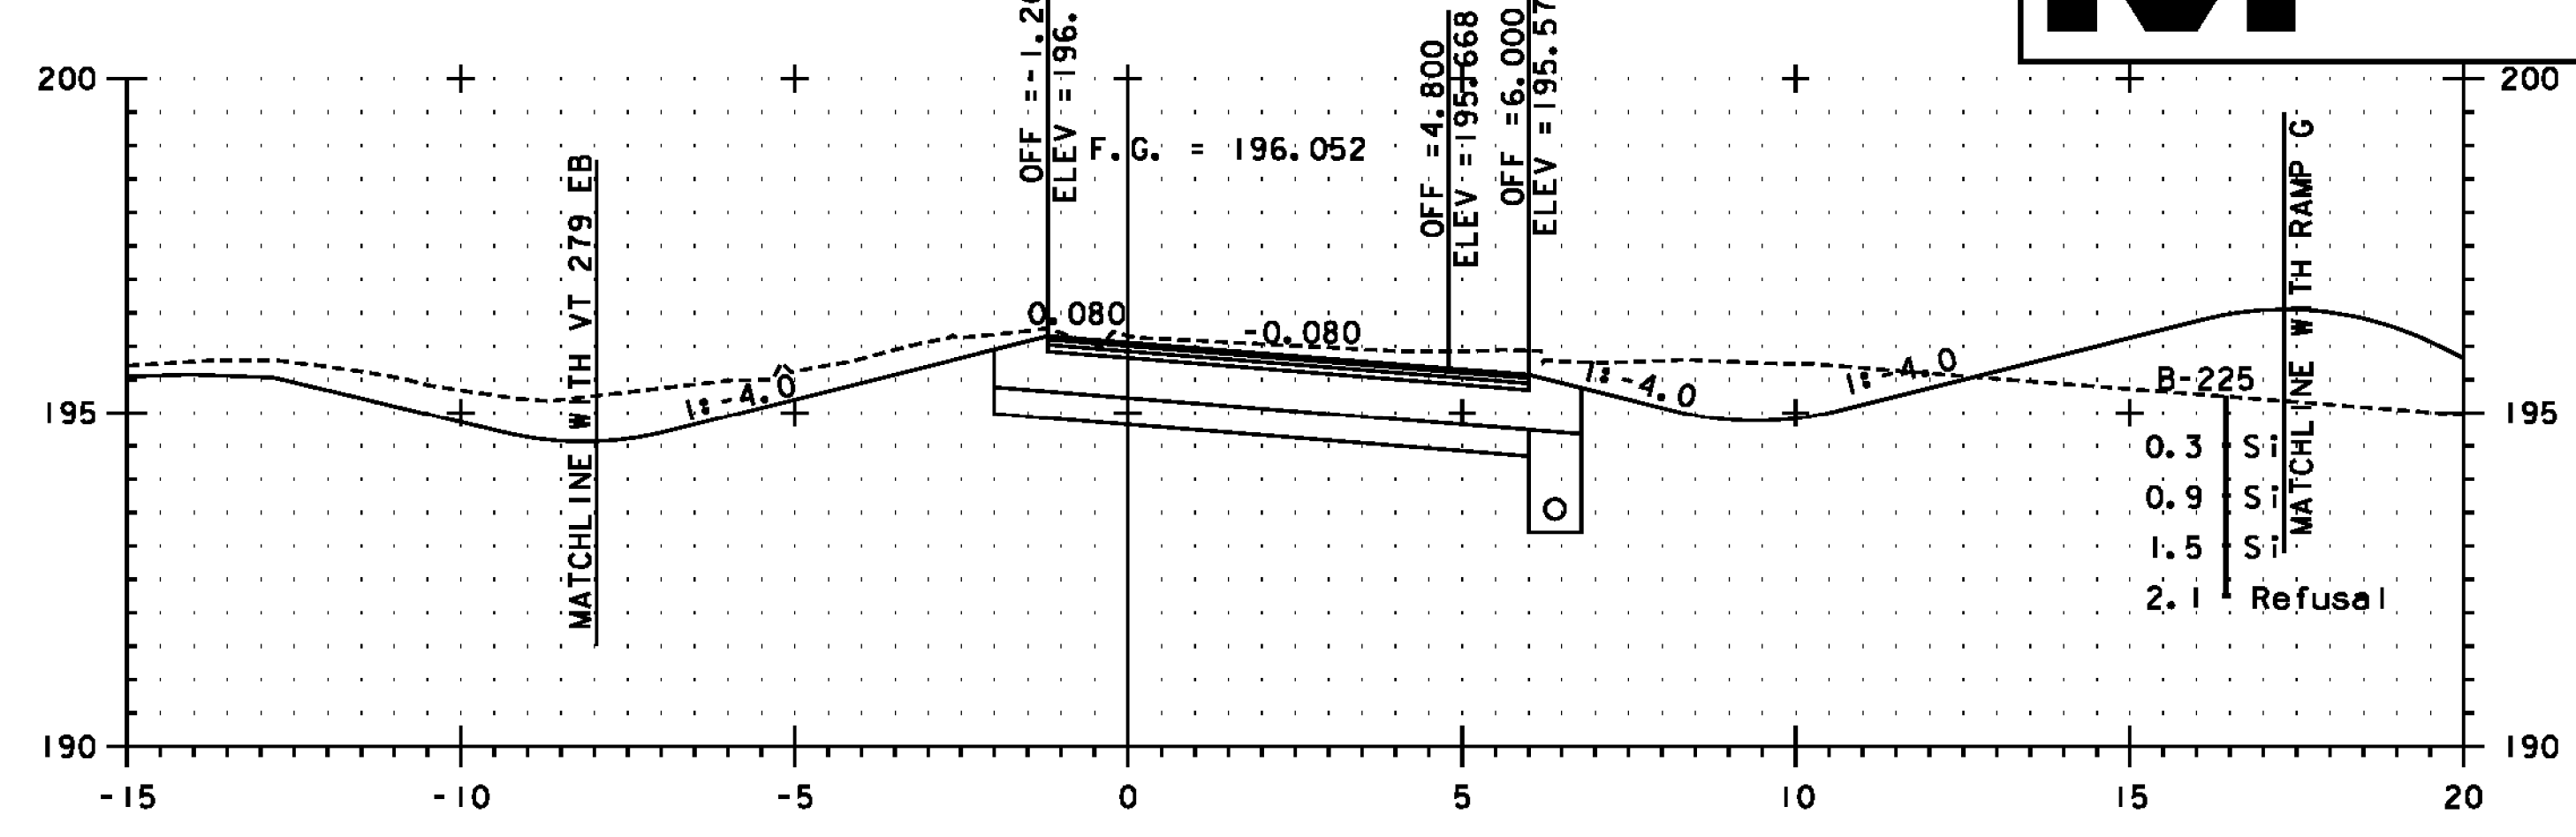


SB 10+660

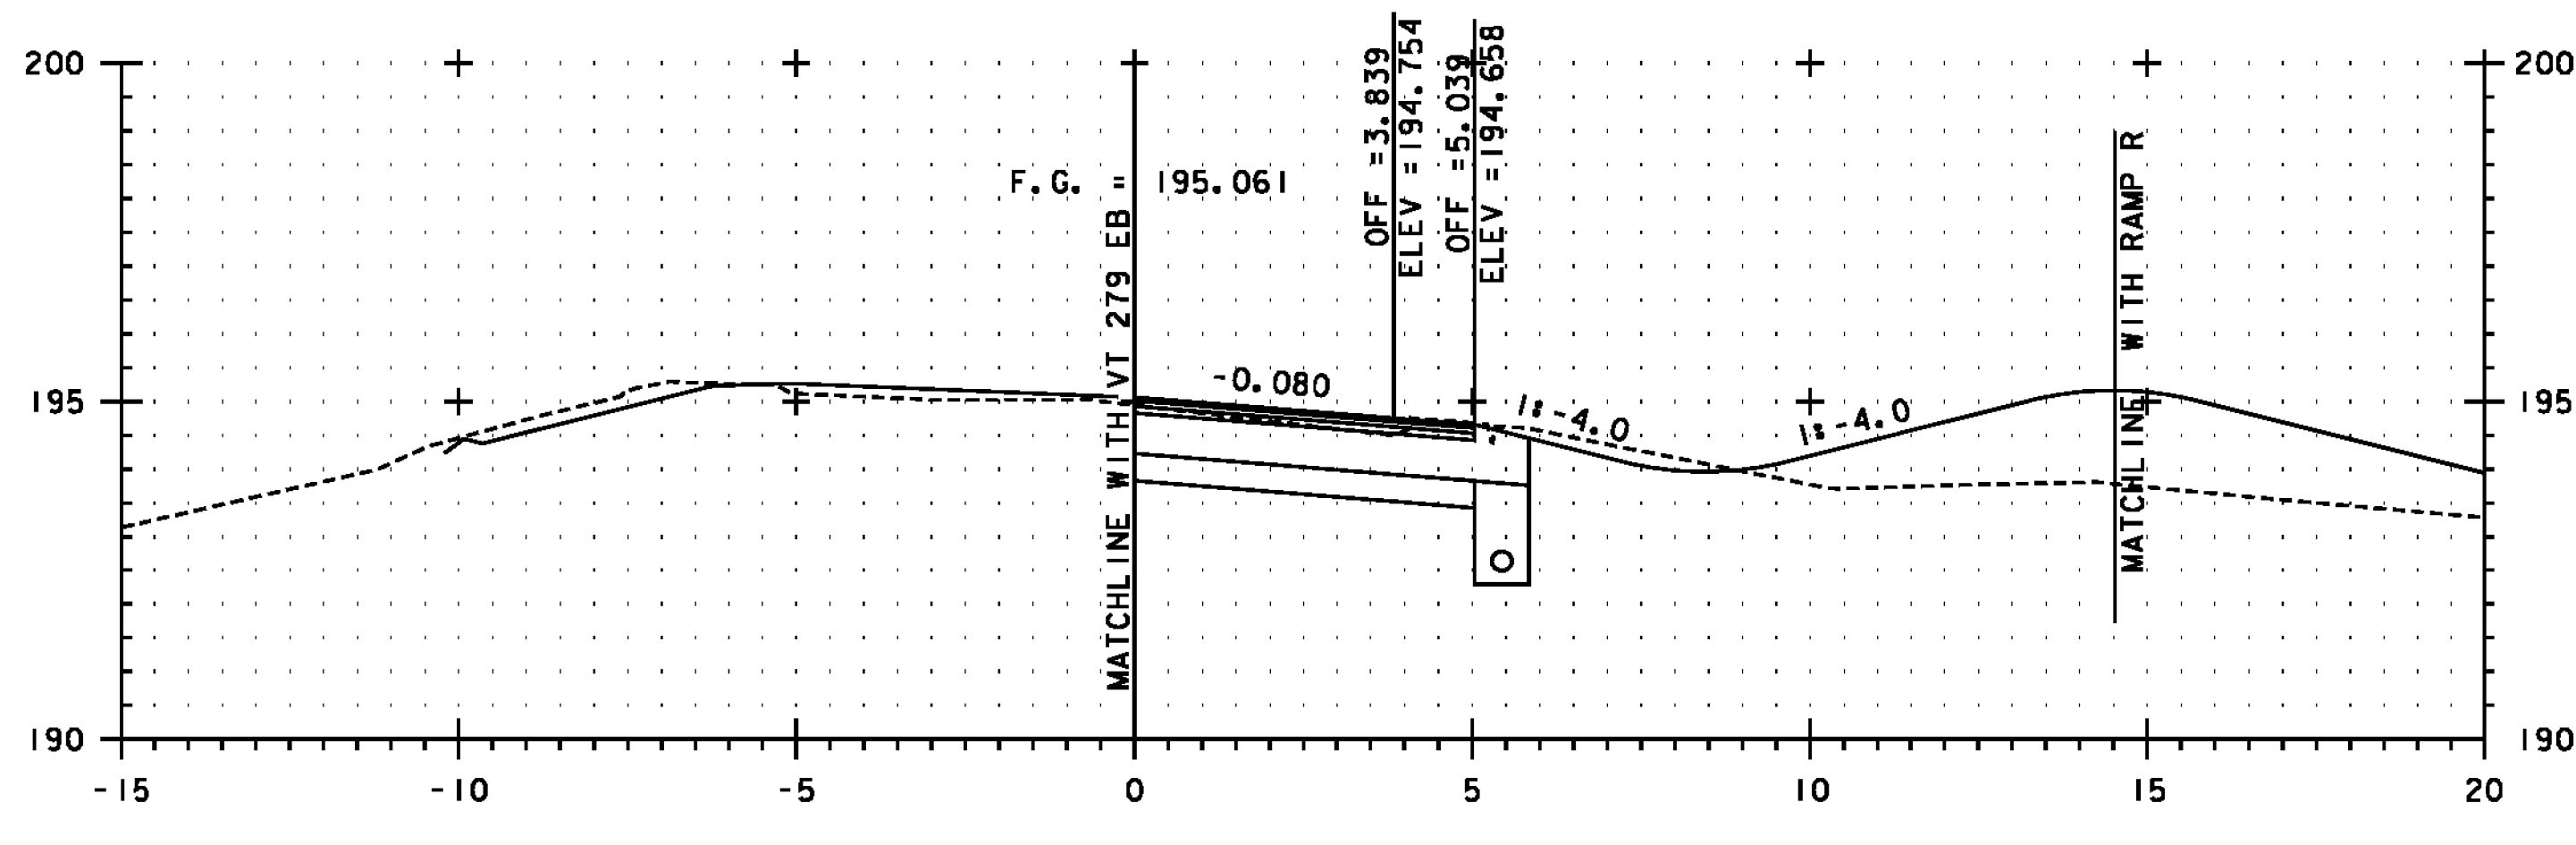


SB 10+580

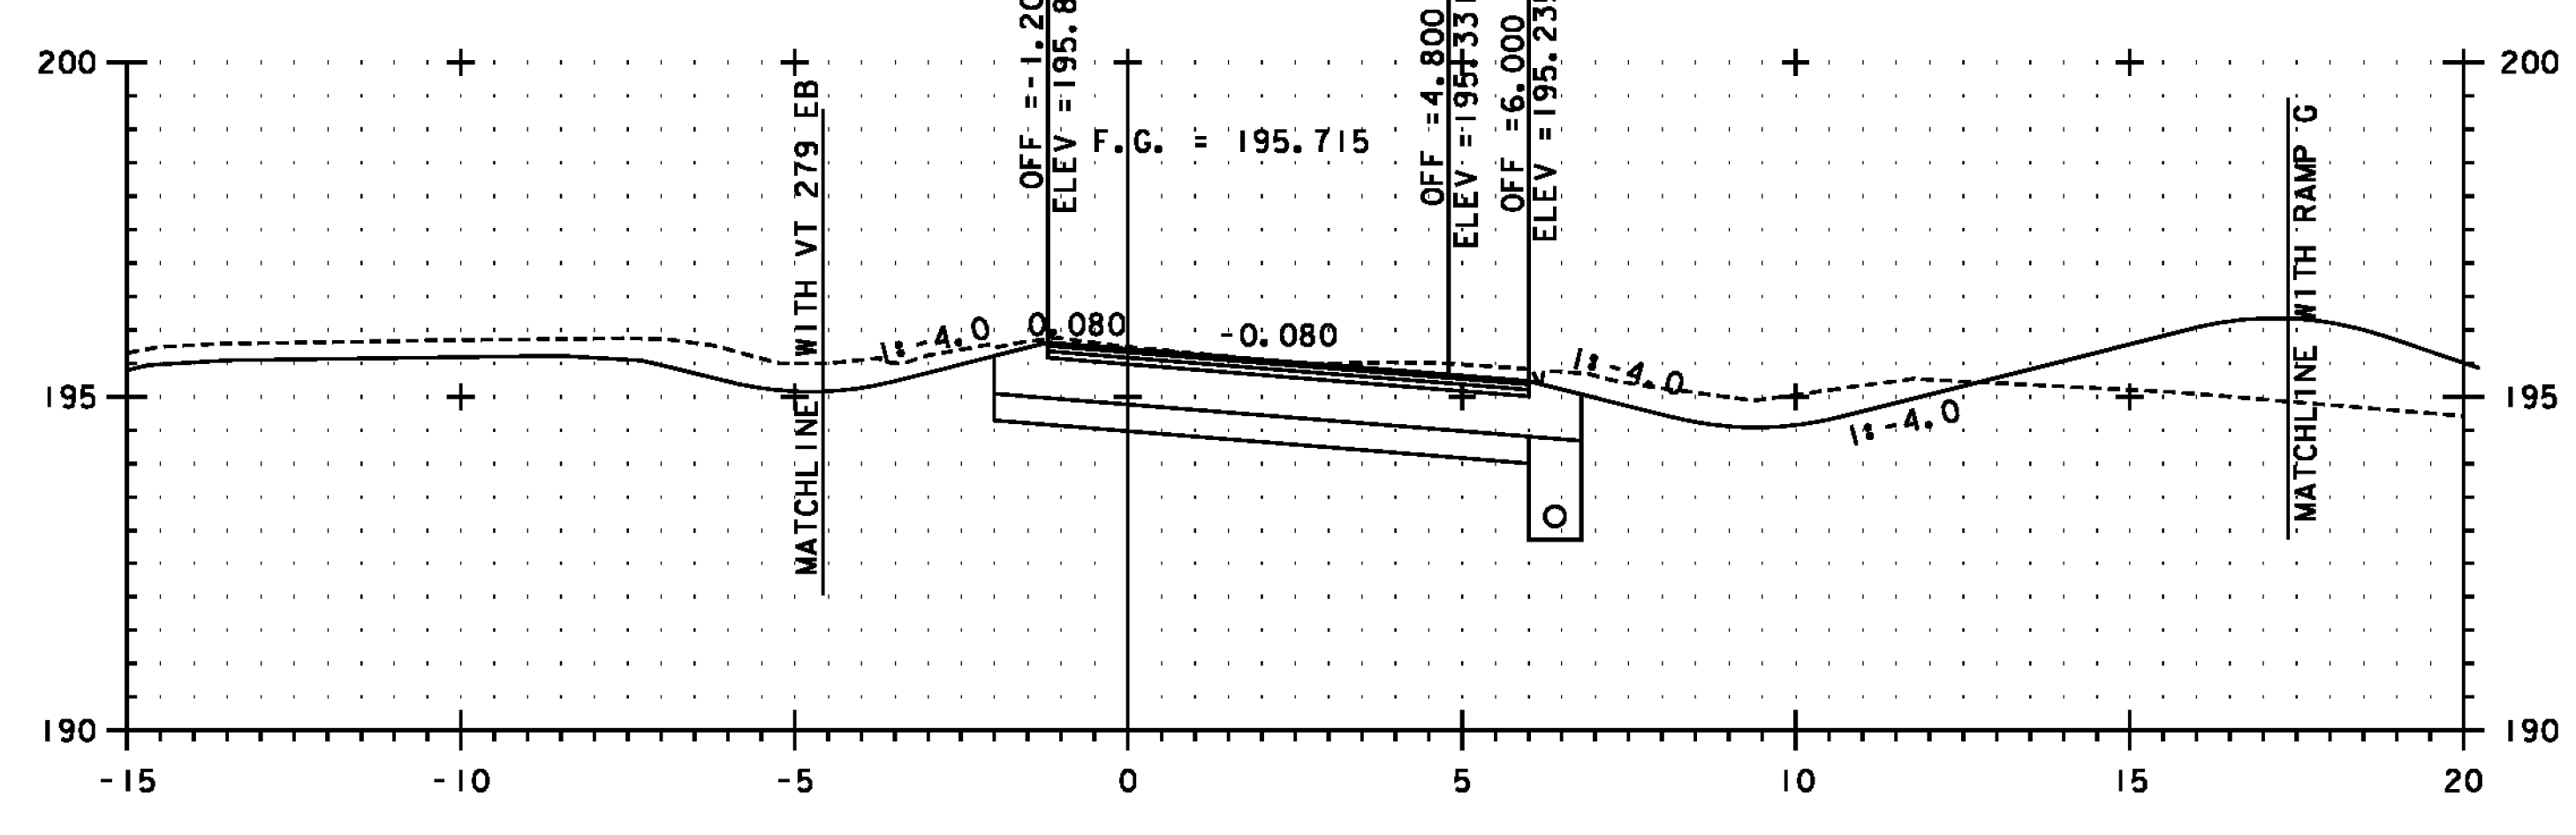


SB 10+640

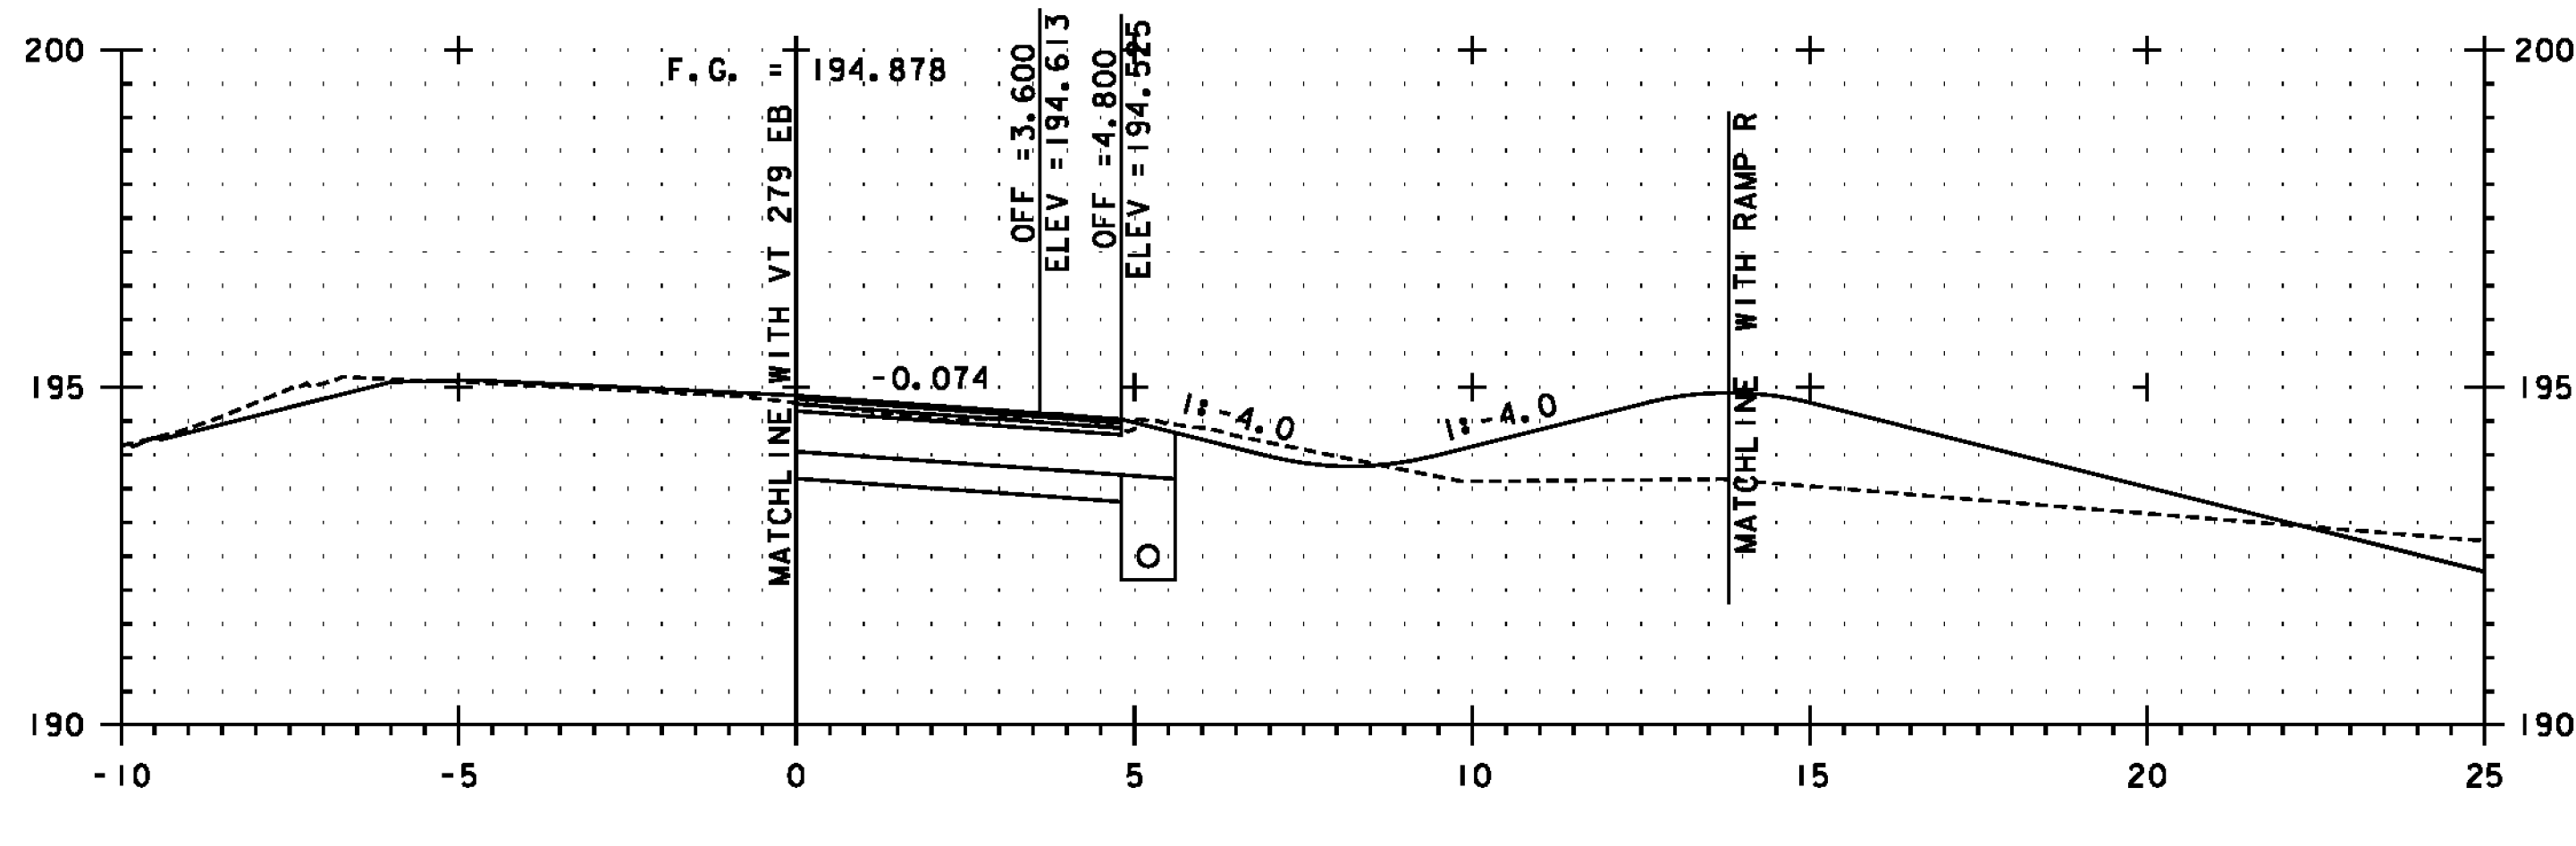

SB 10+567.592 = EB 10+567.592

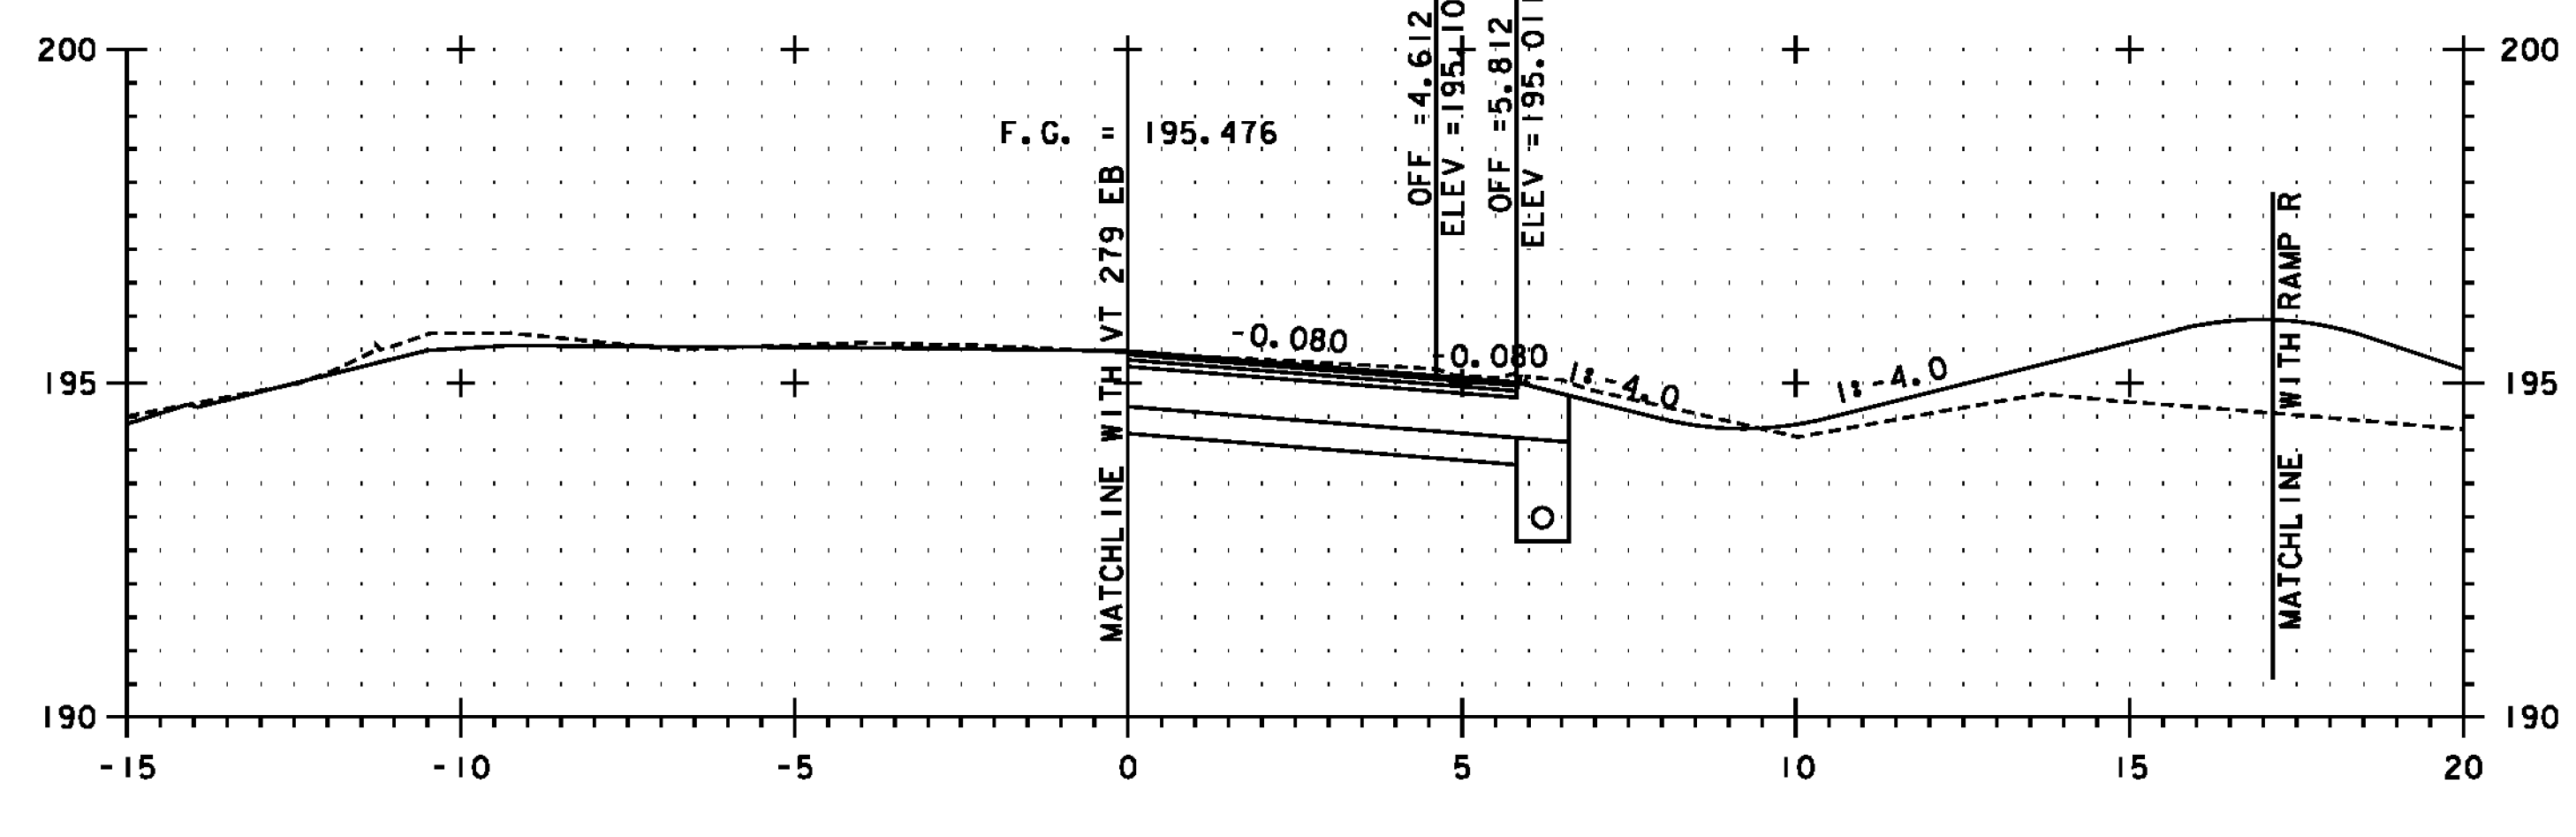

SB 10+620

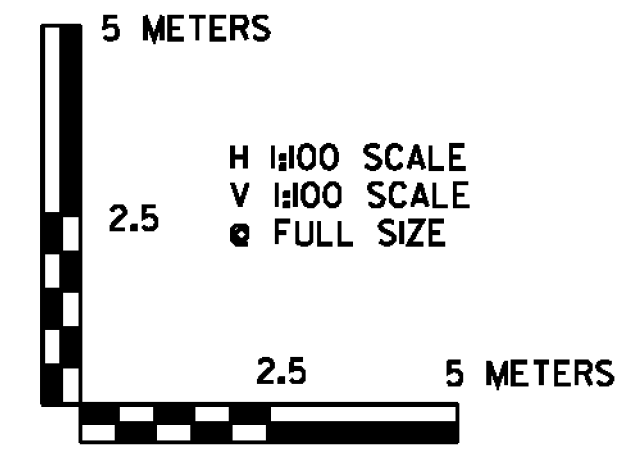

SEE NOTE ON SHEET 447



PROJECT NAME:	BENNINGTON
PROJECT NUMBER:	NH 019-(K54)
FILE NAME:	...plot_files\zd307c4xs.7SB.ptf
DESIGN SUPERVISOR:	GREG EDWARDS
DESIGNED BY:	MARC FOISY
US 7 SB CROSS SECTION	SBX-12
PLOT DATE:	1/26/2010
DRAWN BY:	STANTEC
CHECKED BY:	GARY SANTY
SHEET	458 OF 468

1/26/2010 4:58:55 PM v:\1953\getlive\19530002\tr\anspor\ref\10\dr\w\ng\com\tr\c01_4\plot_files\zd307c4xs_7SB.ptf