



SB 10+920

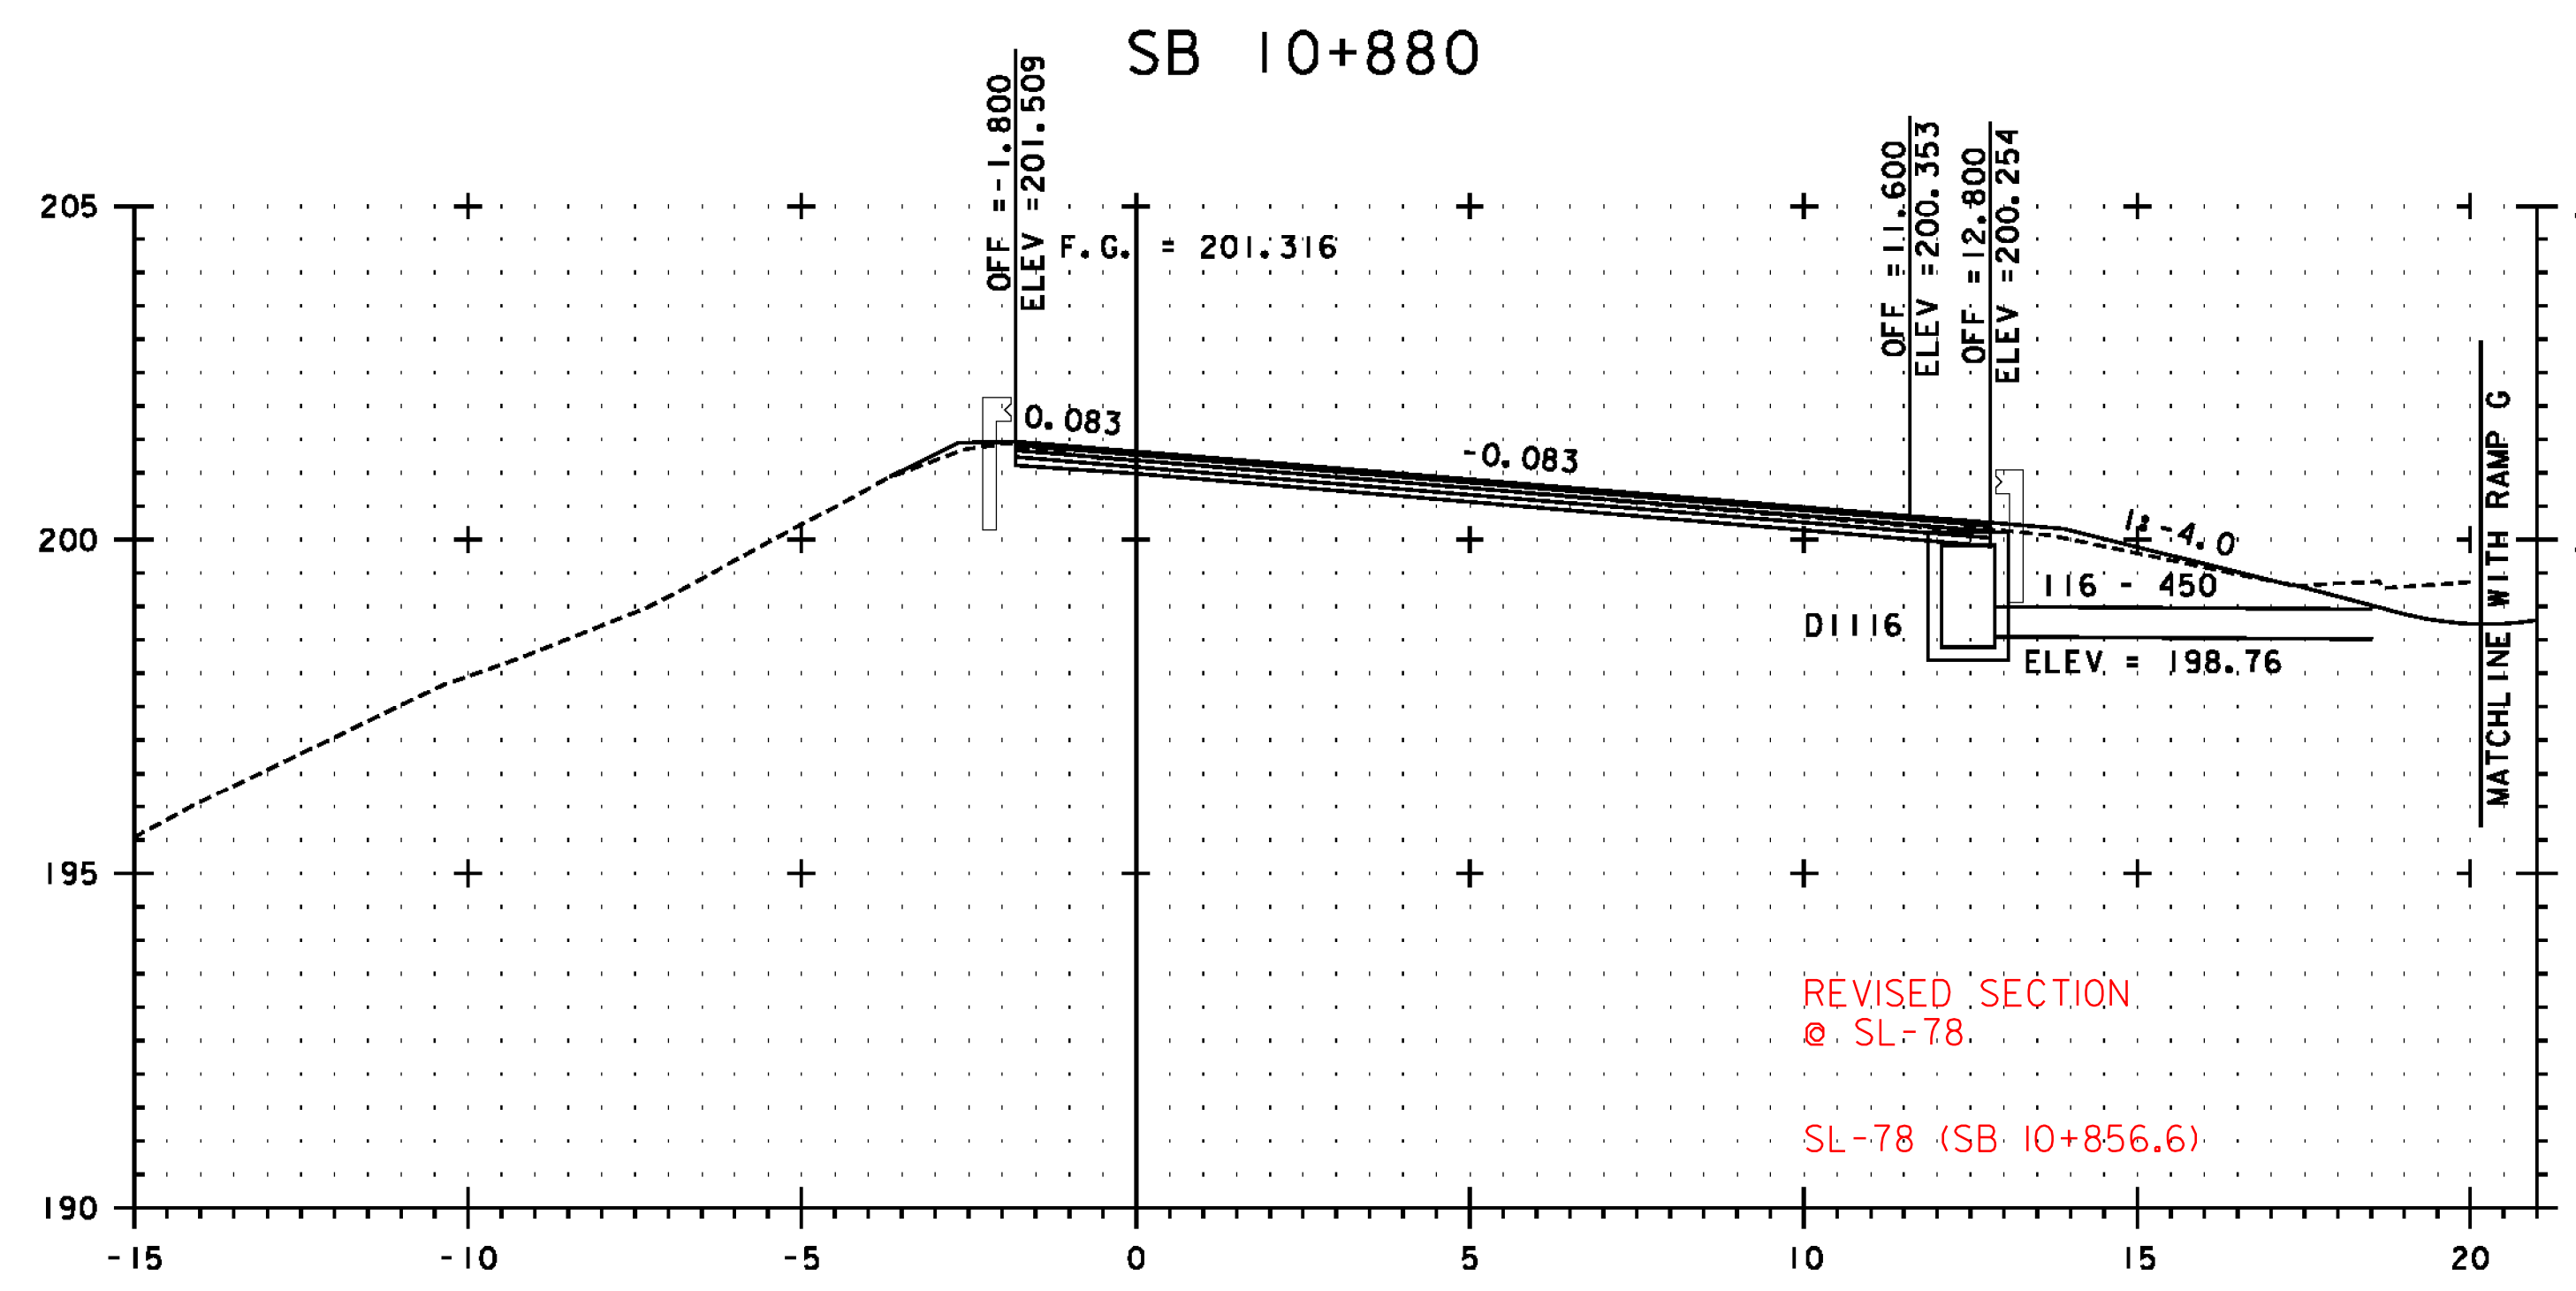


SB 10+860

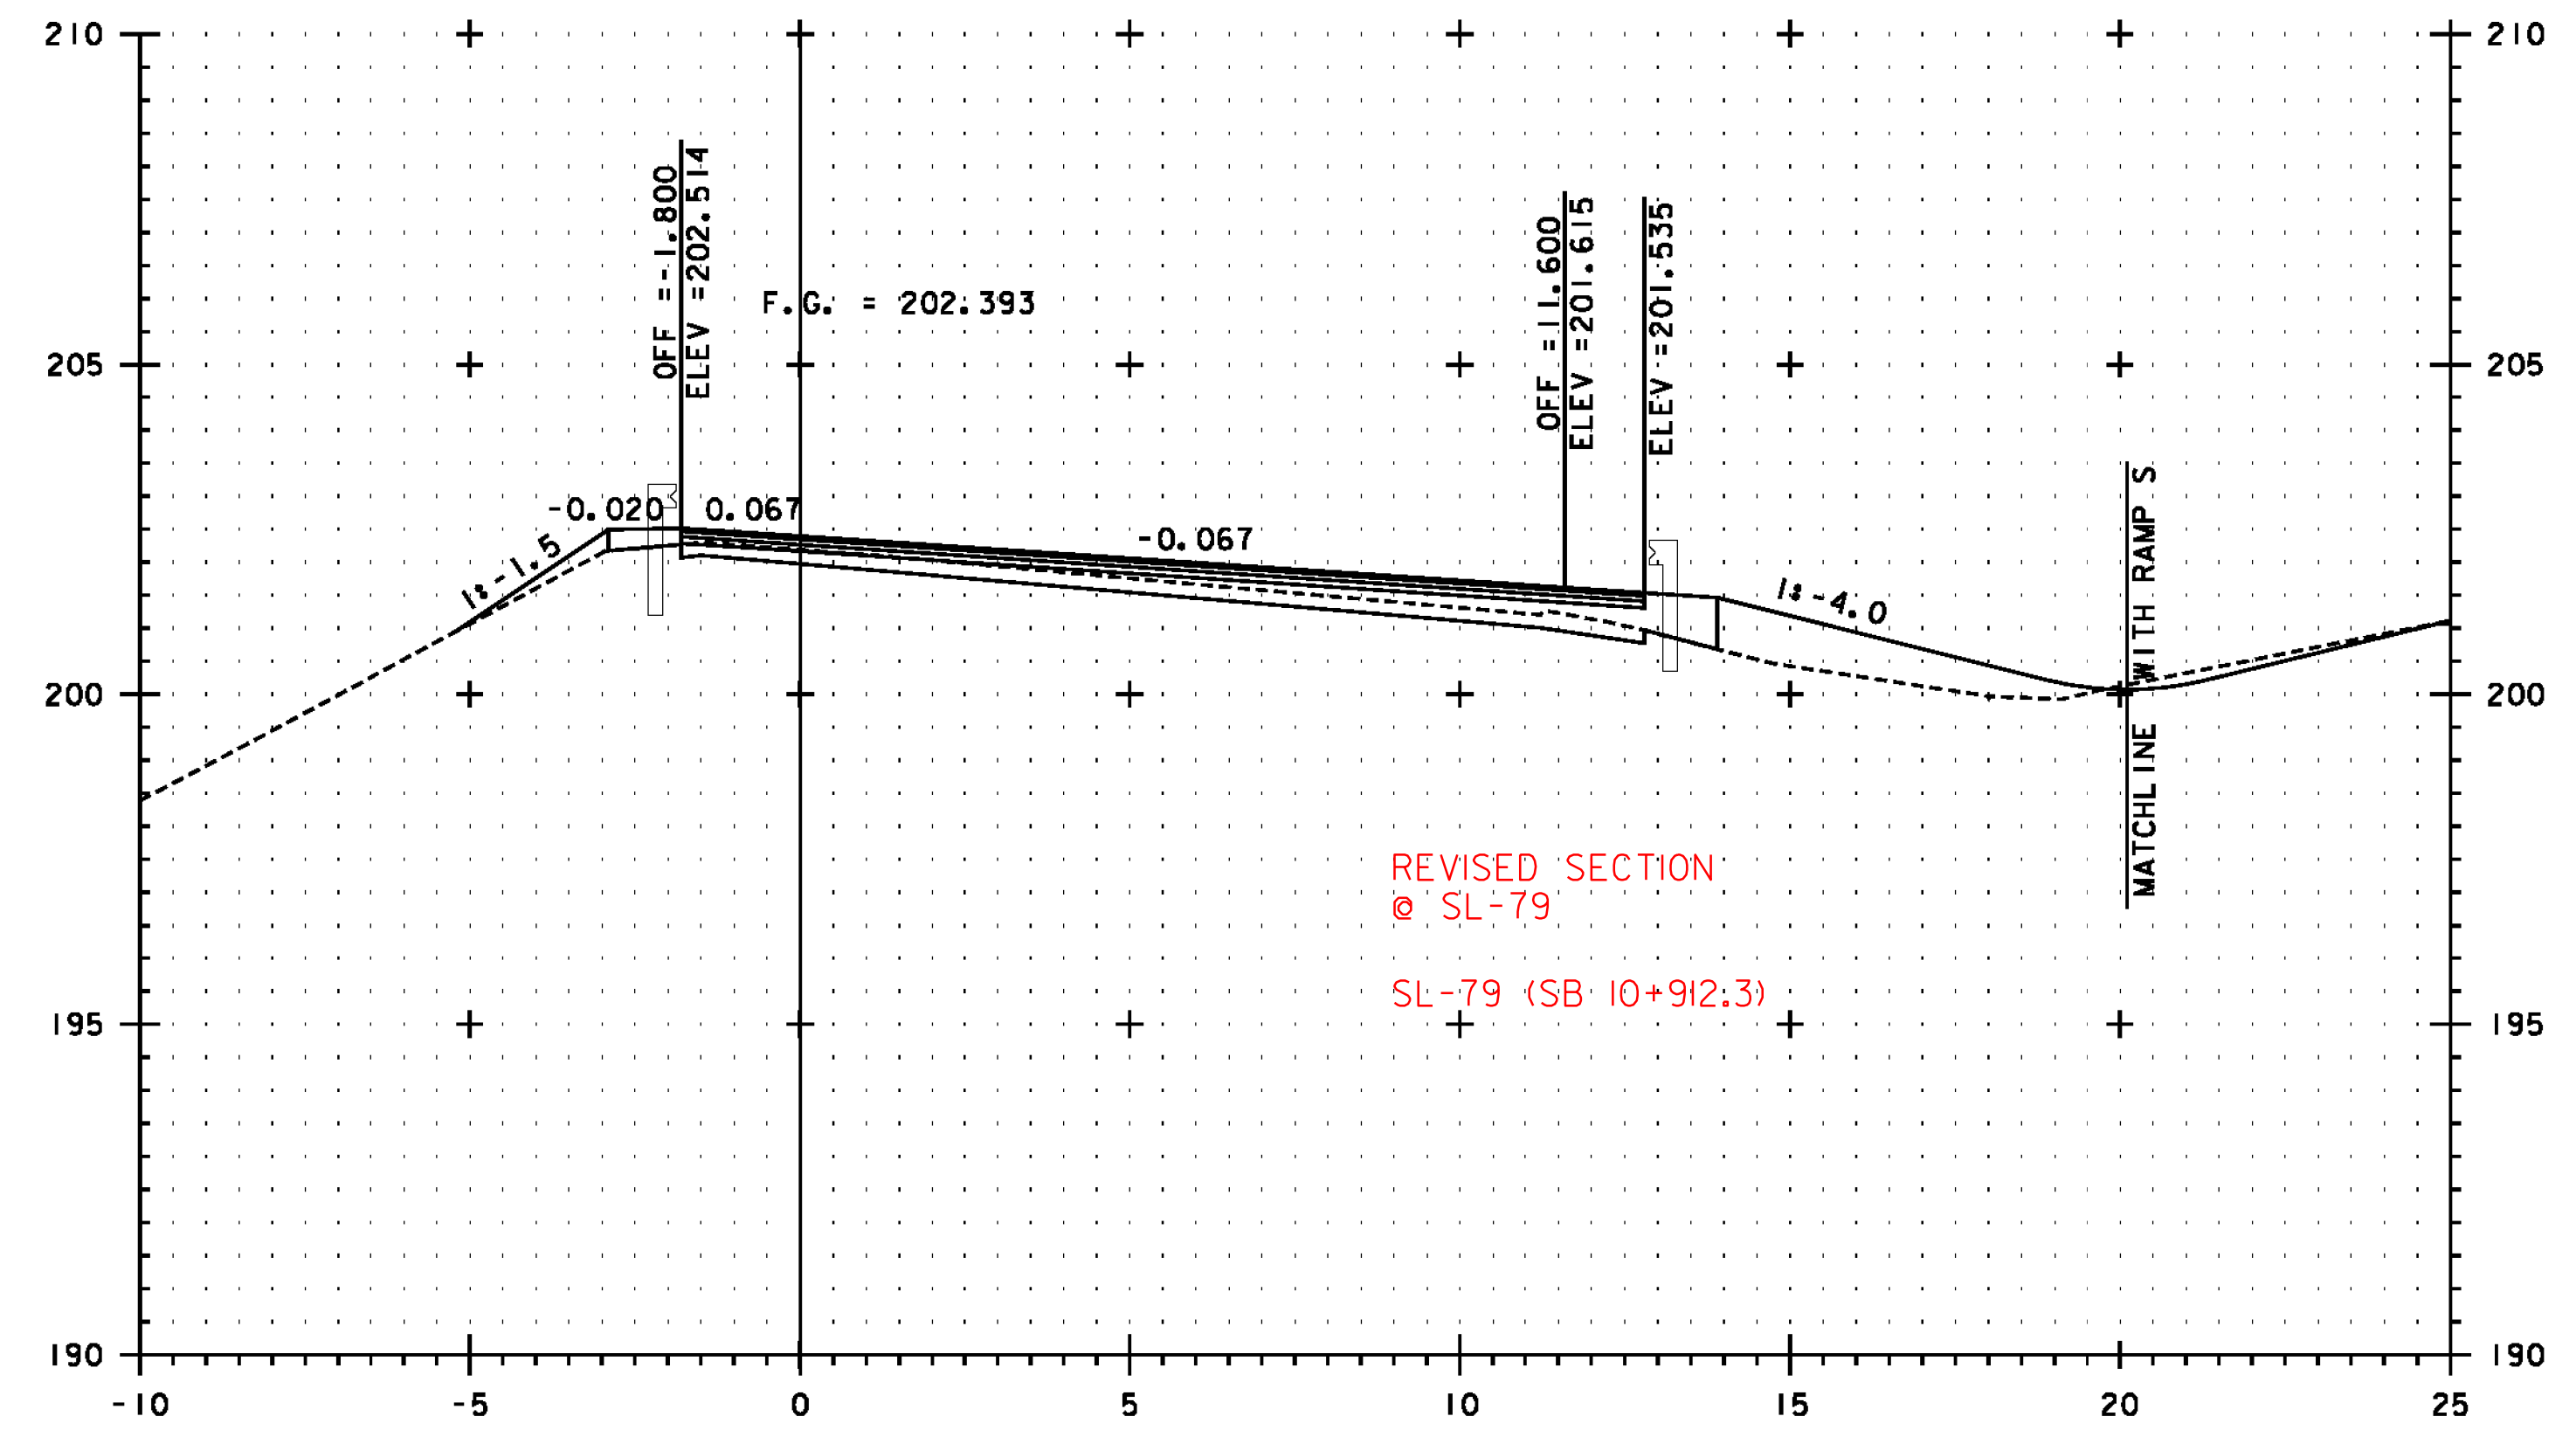

SB 10+900

SEE NOTE ON SHEET 447

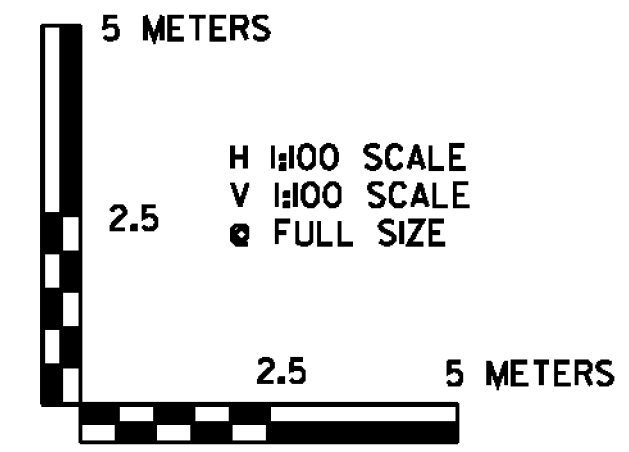

| | | | | | |
|-----------------|--------------|--------------------|---------------------------------|-------------|------------|
| PROJECT NAME: | BENNINGTON | FILE NAME: | ...plot_files\zd307c4xs.7SB.ptf | PLOT DATE: | 1/26/2010 |
| PROJECT NUMBER: | NH 019-(154) | DESIGN SUPERVISOR: | GREG EDWARDS | DRAWN BY: | STANTEC |
| | | DESIGNED BY: | MARC FOISY | CHECKED BY: | GARY SANTY |
| | | | US 7 SB CROSS SECTION SBX-16 | SHEET | 462 OF 468 |

1/26/2010 4:59:00 PM v:\1953\getlive\1953\0002\tr\anspor\getlive\dr\cwg\mg\confr\cst\4\plot_files\zd307c4xs.7SB.ptf