




SB 10+960

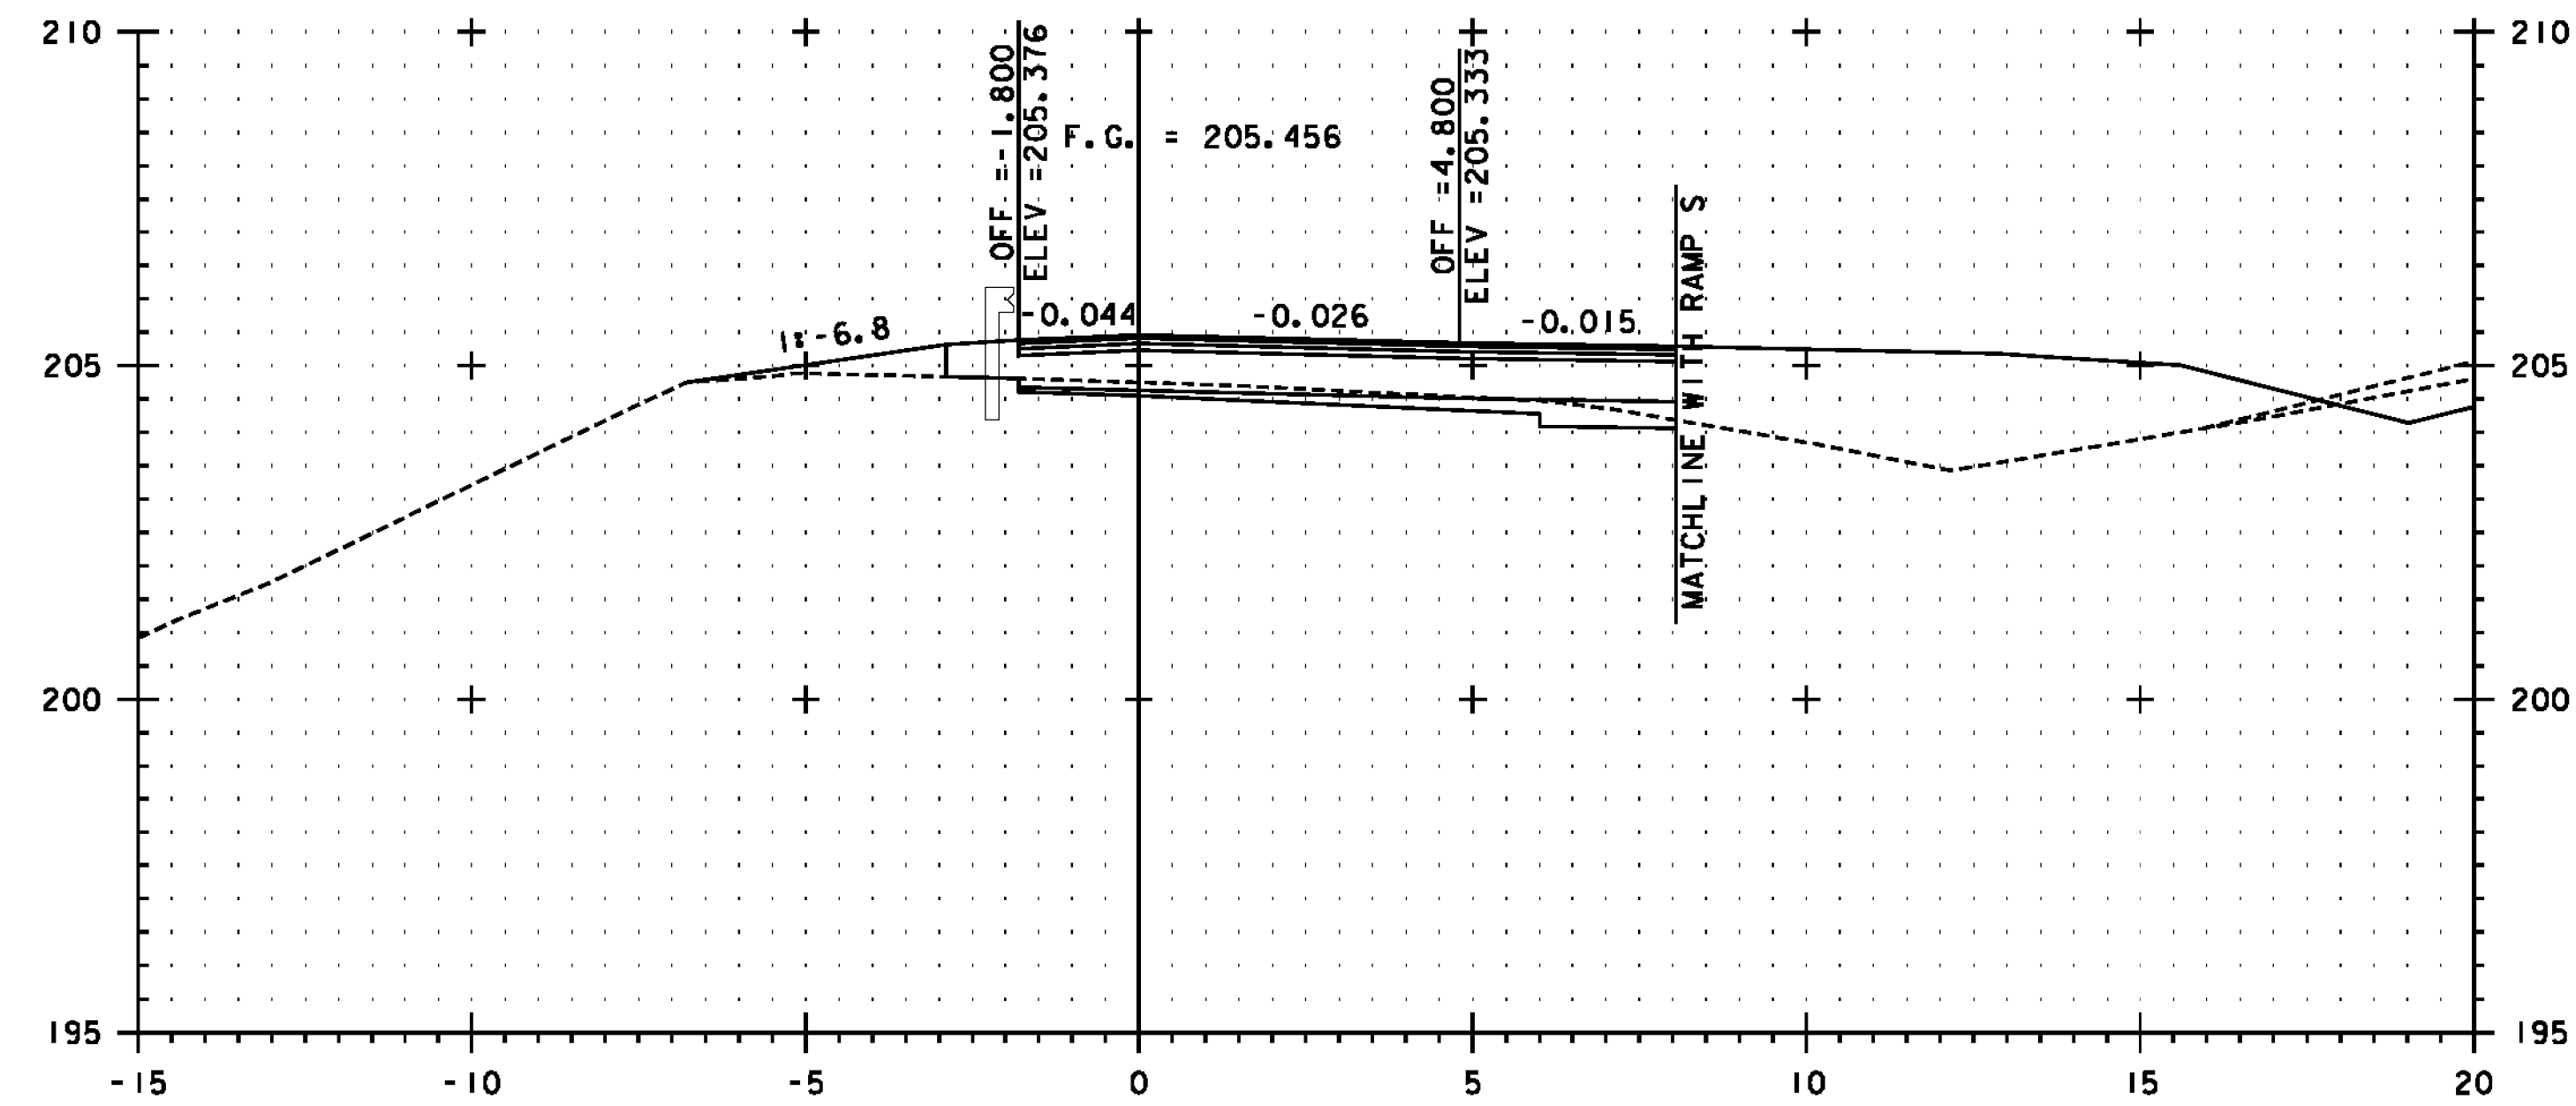

SB 11+000

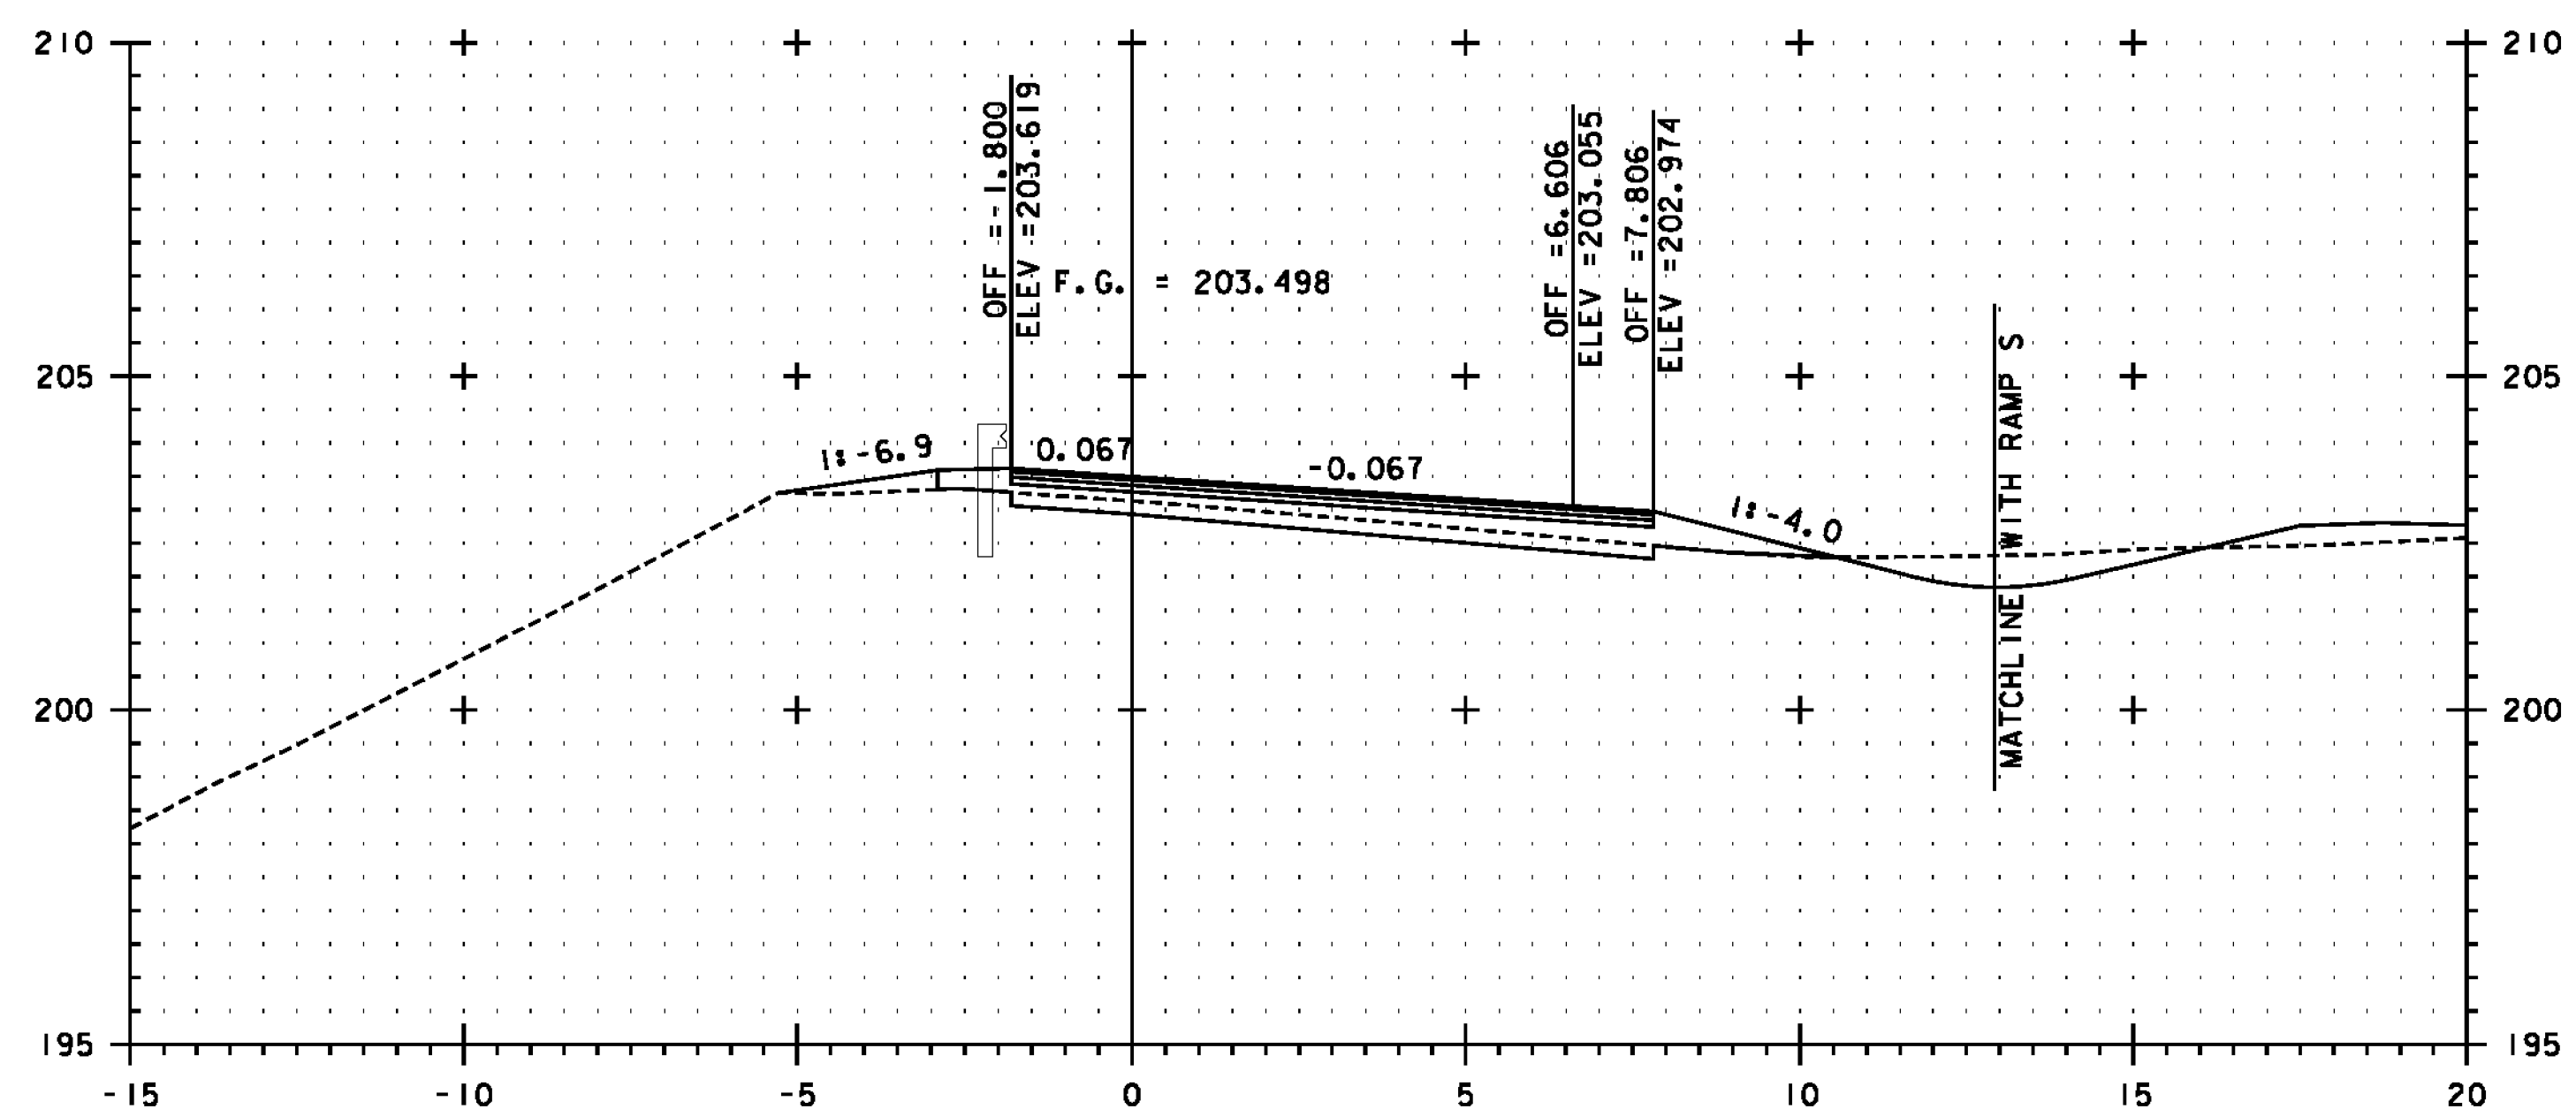


SB 10+940

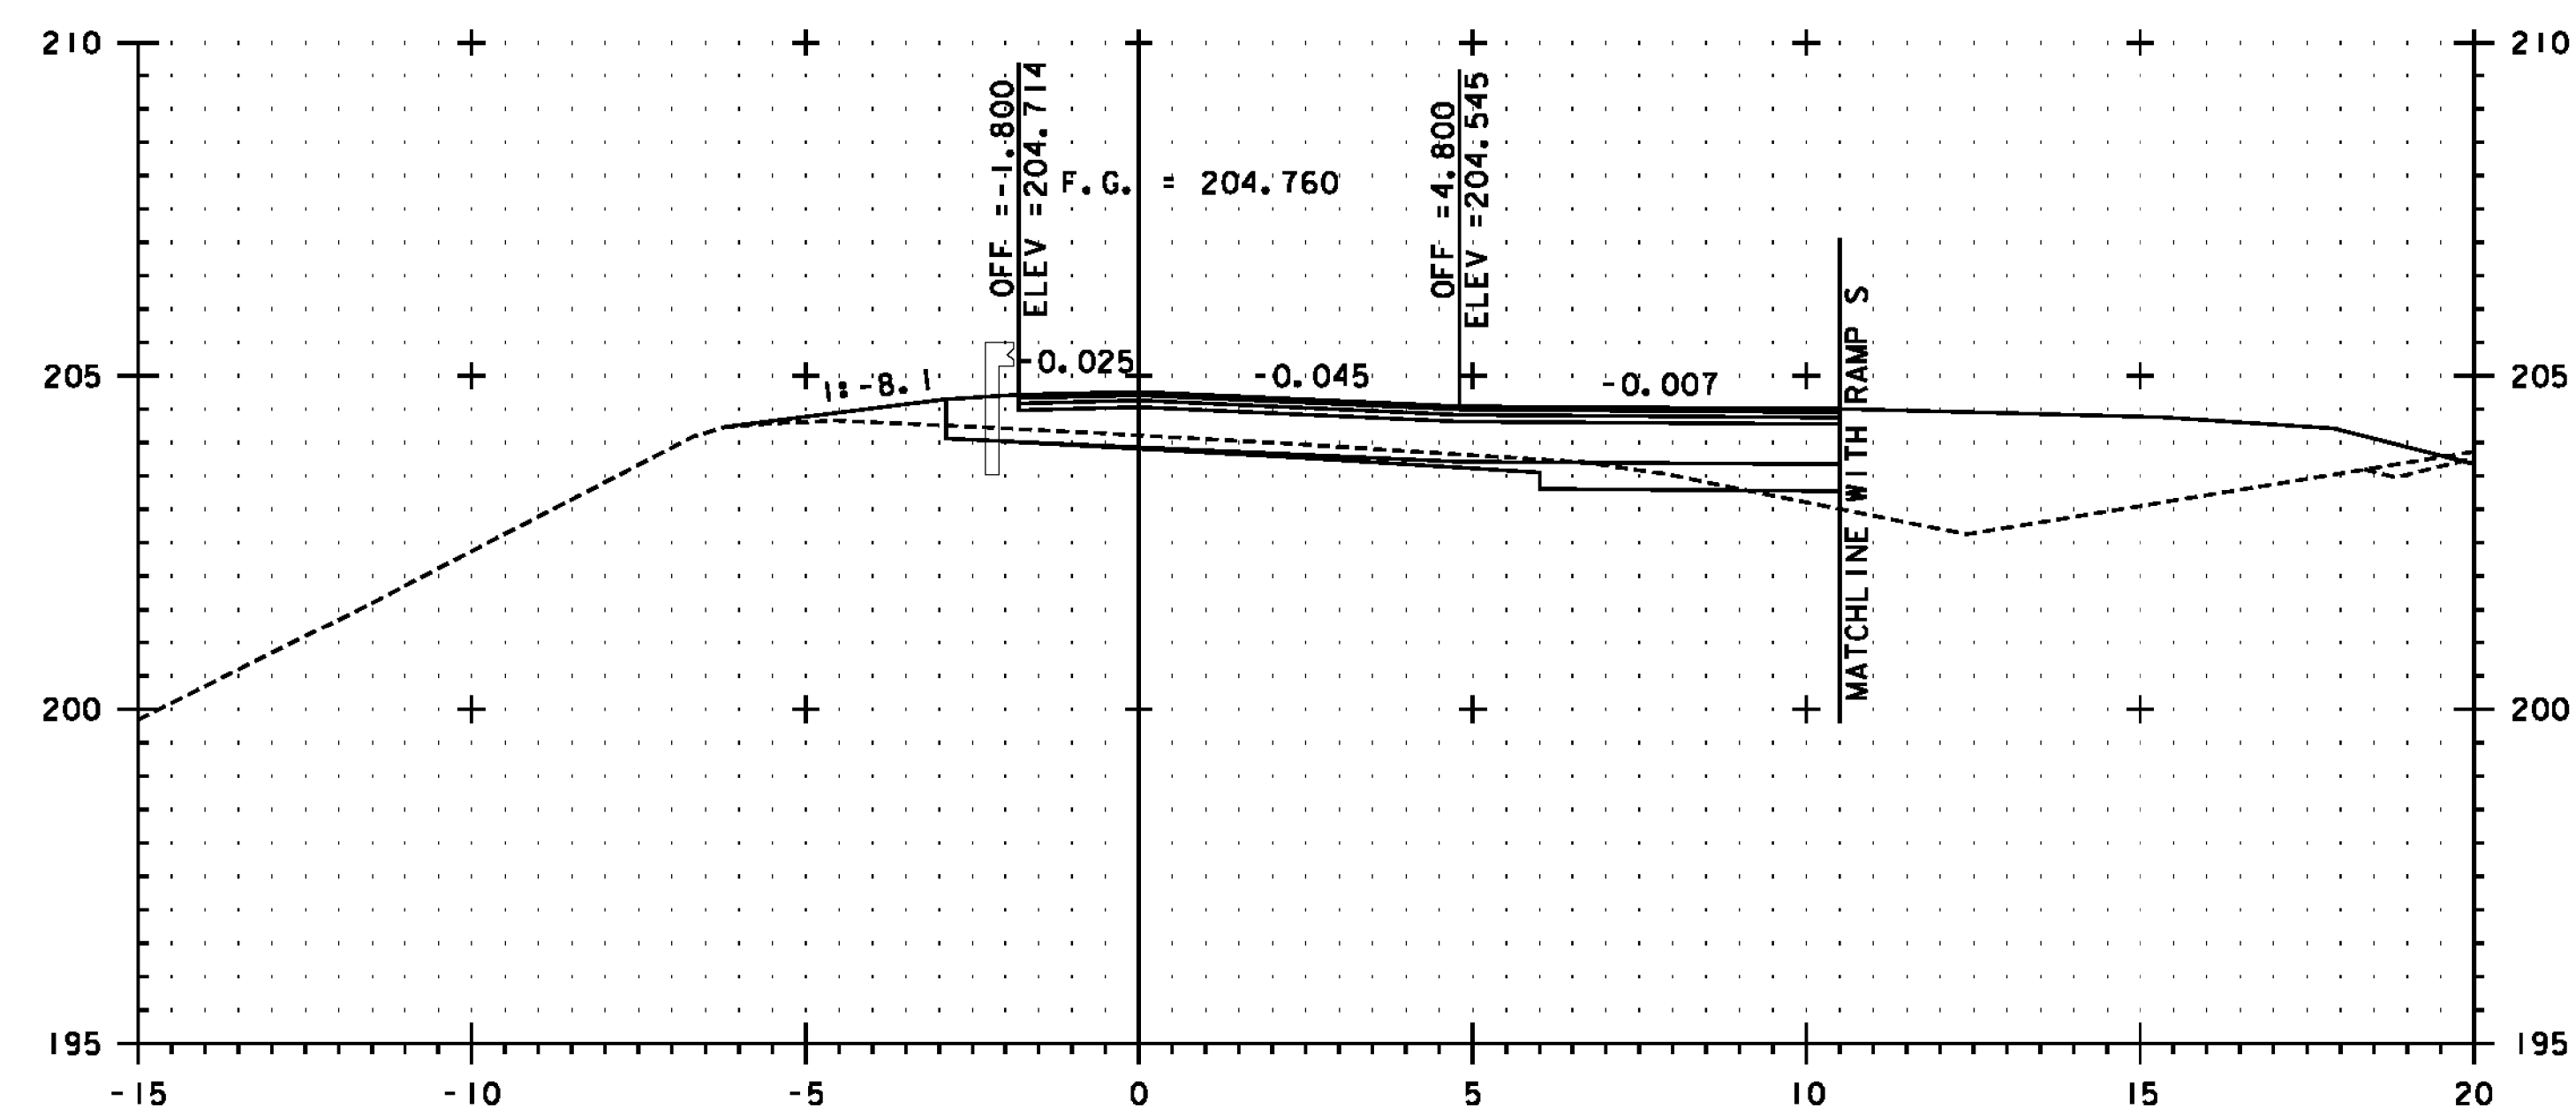

SB 10+980

SEE NOTE ON SHEET 447

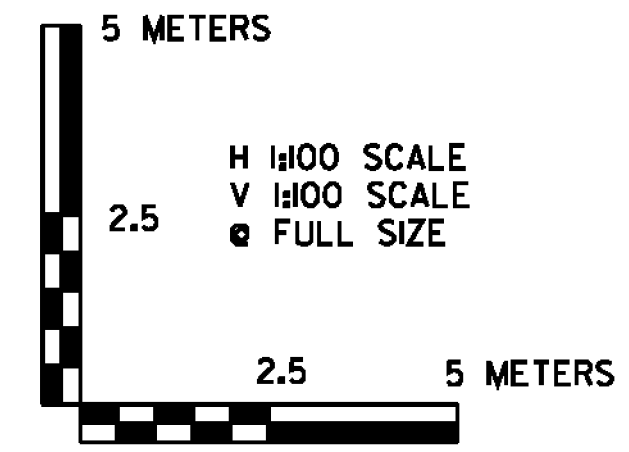

PROJECT NAME: BENNINGTON	
PROJECT NUMBER: NH 019-(154)	
FILE NAME: ...\plot_files\zd307c4xs.7SB.ptf	PLOT DATE: 1/26/2010
DESIGN SUPERVISOR: GREG EDWARDS	DRAWN BY: STANTEC
DESIGNED BY: MARC FOISY	CHECKED BY: GARY SANTY
US 7 SB CROSS SECTION SBX-17	SHEET 463 OF 468

1/26/2010 4:59:01 PM v:\1953\getlive\19530002\tr\anspor\getlive\dr\cwg\ng\com\tr\cst\4\plot_files\zd307c4xs.7SB.ptf