




SB 11+080.481 = S 1+000.000, 4.8m RT.

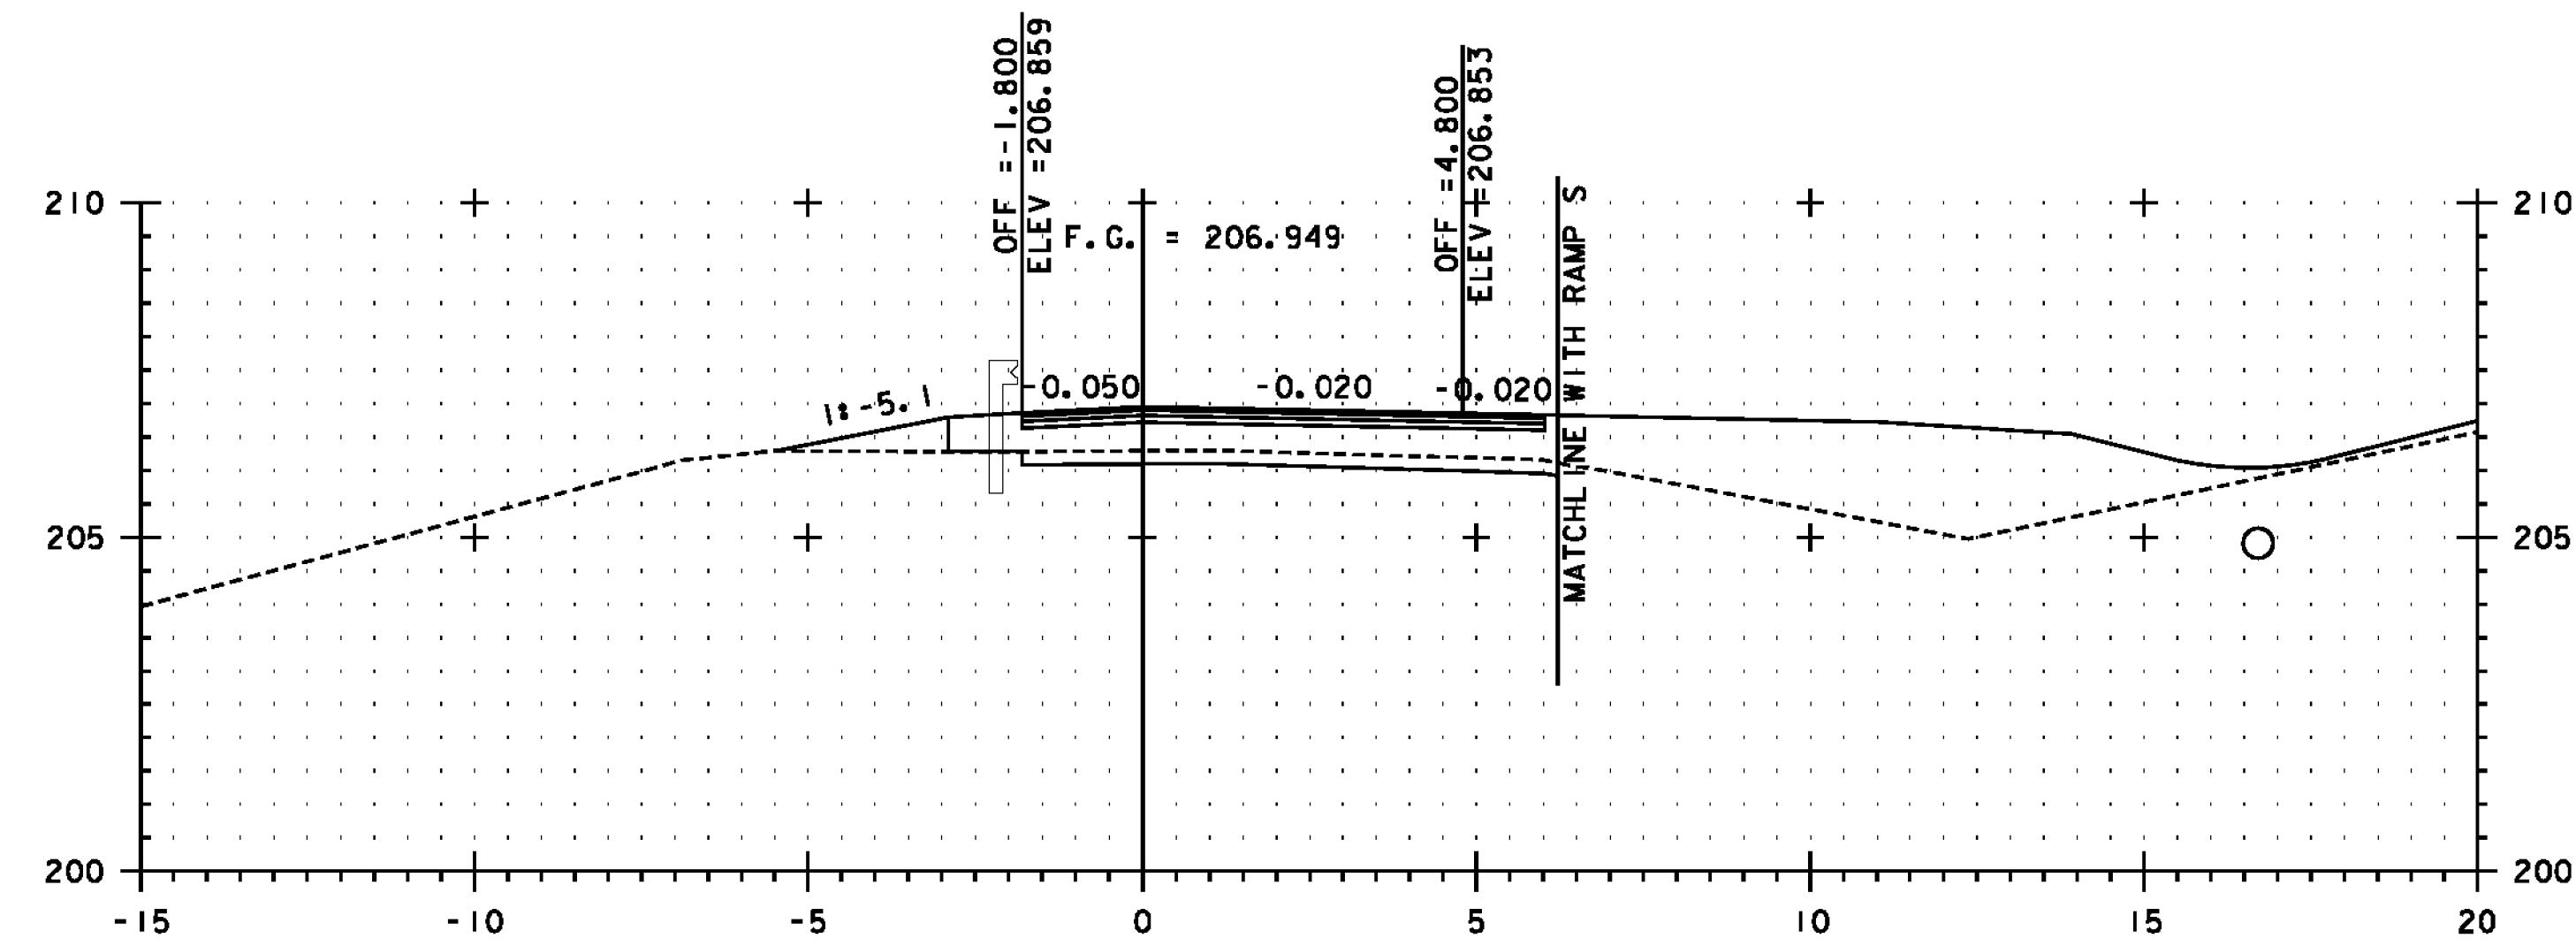


SB 11+040

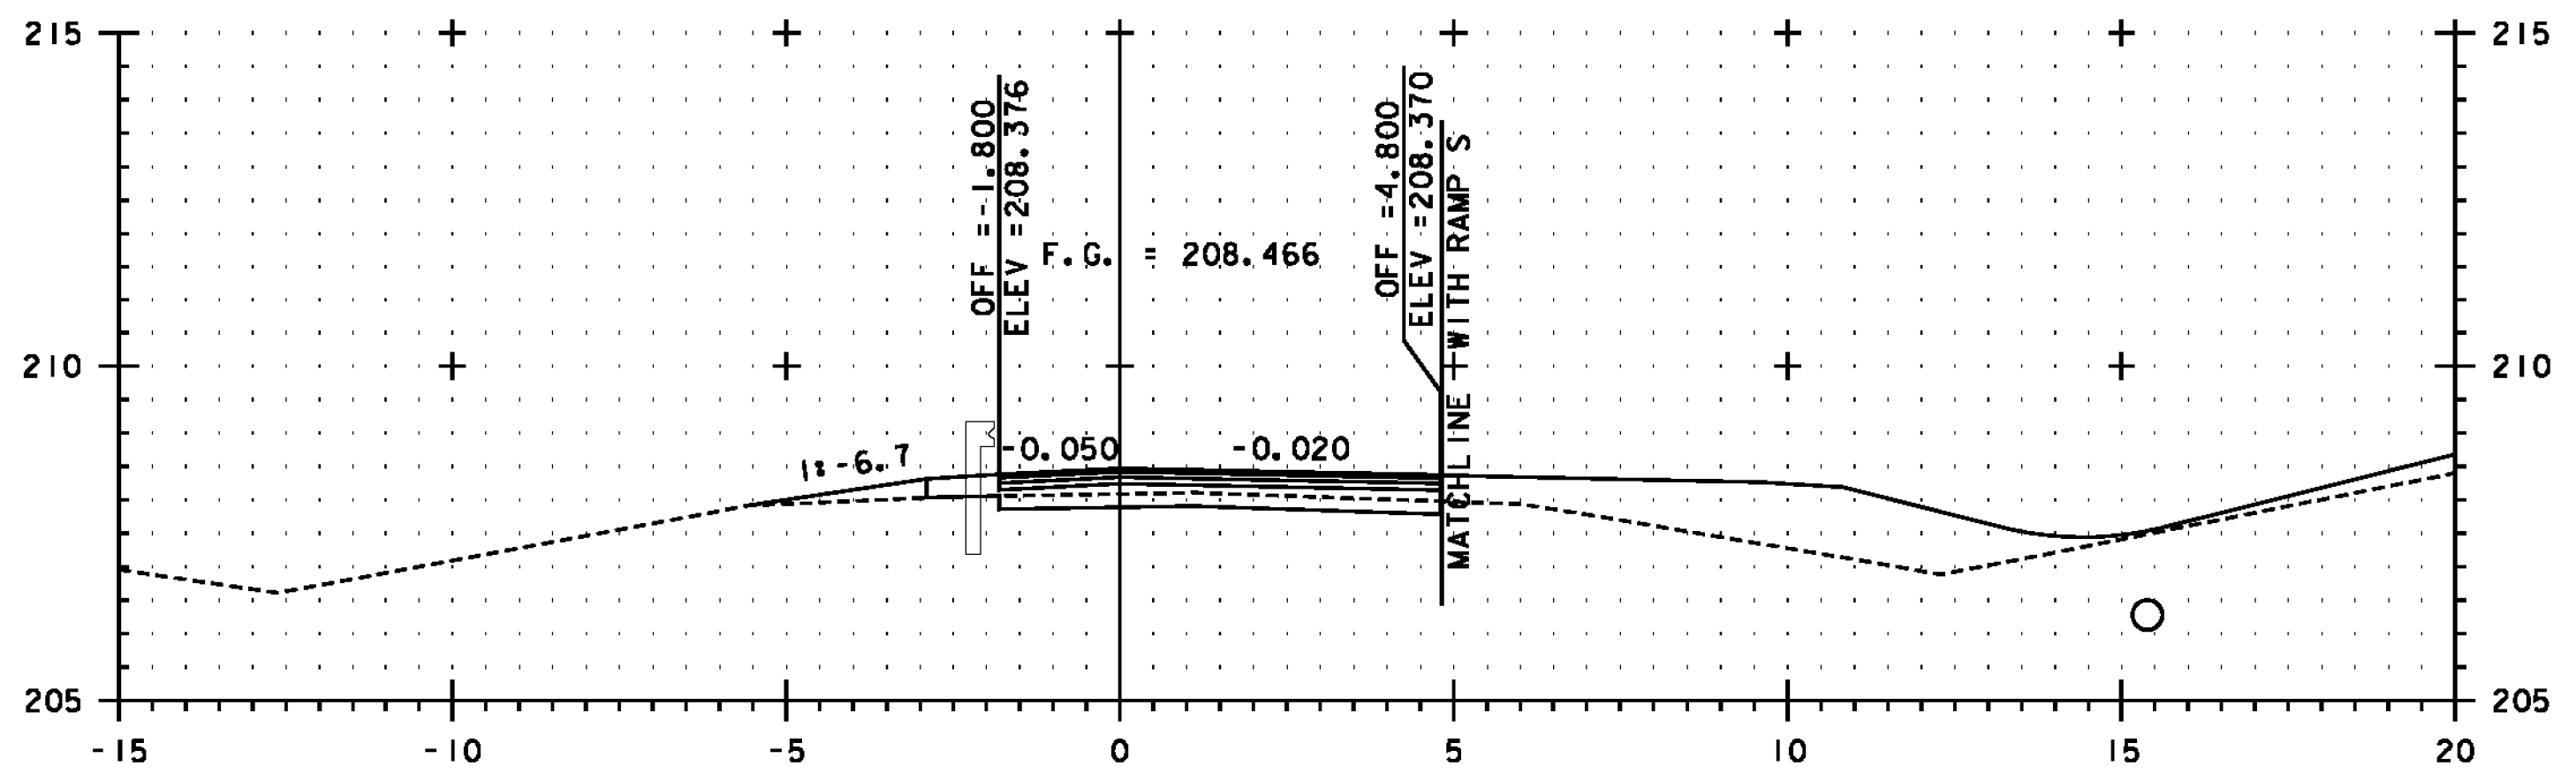

SB 11+080

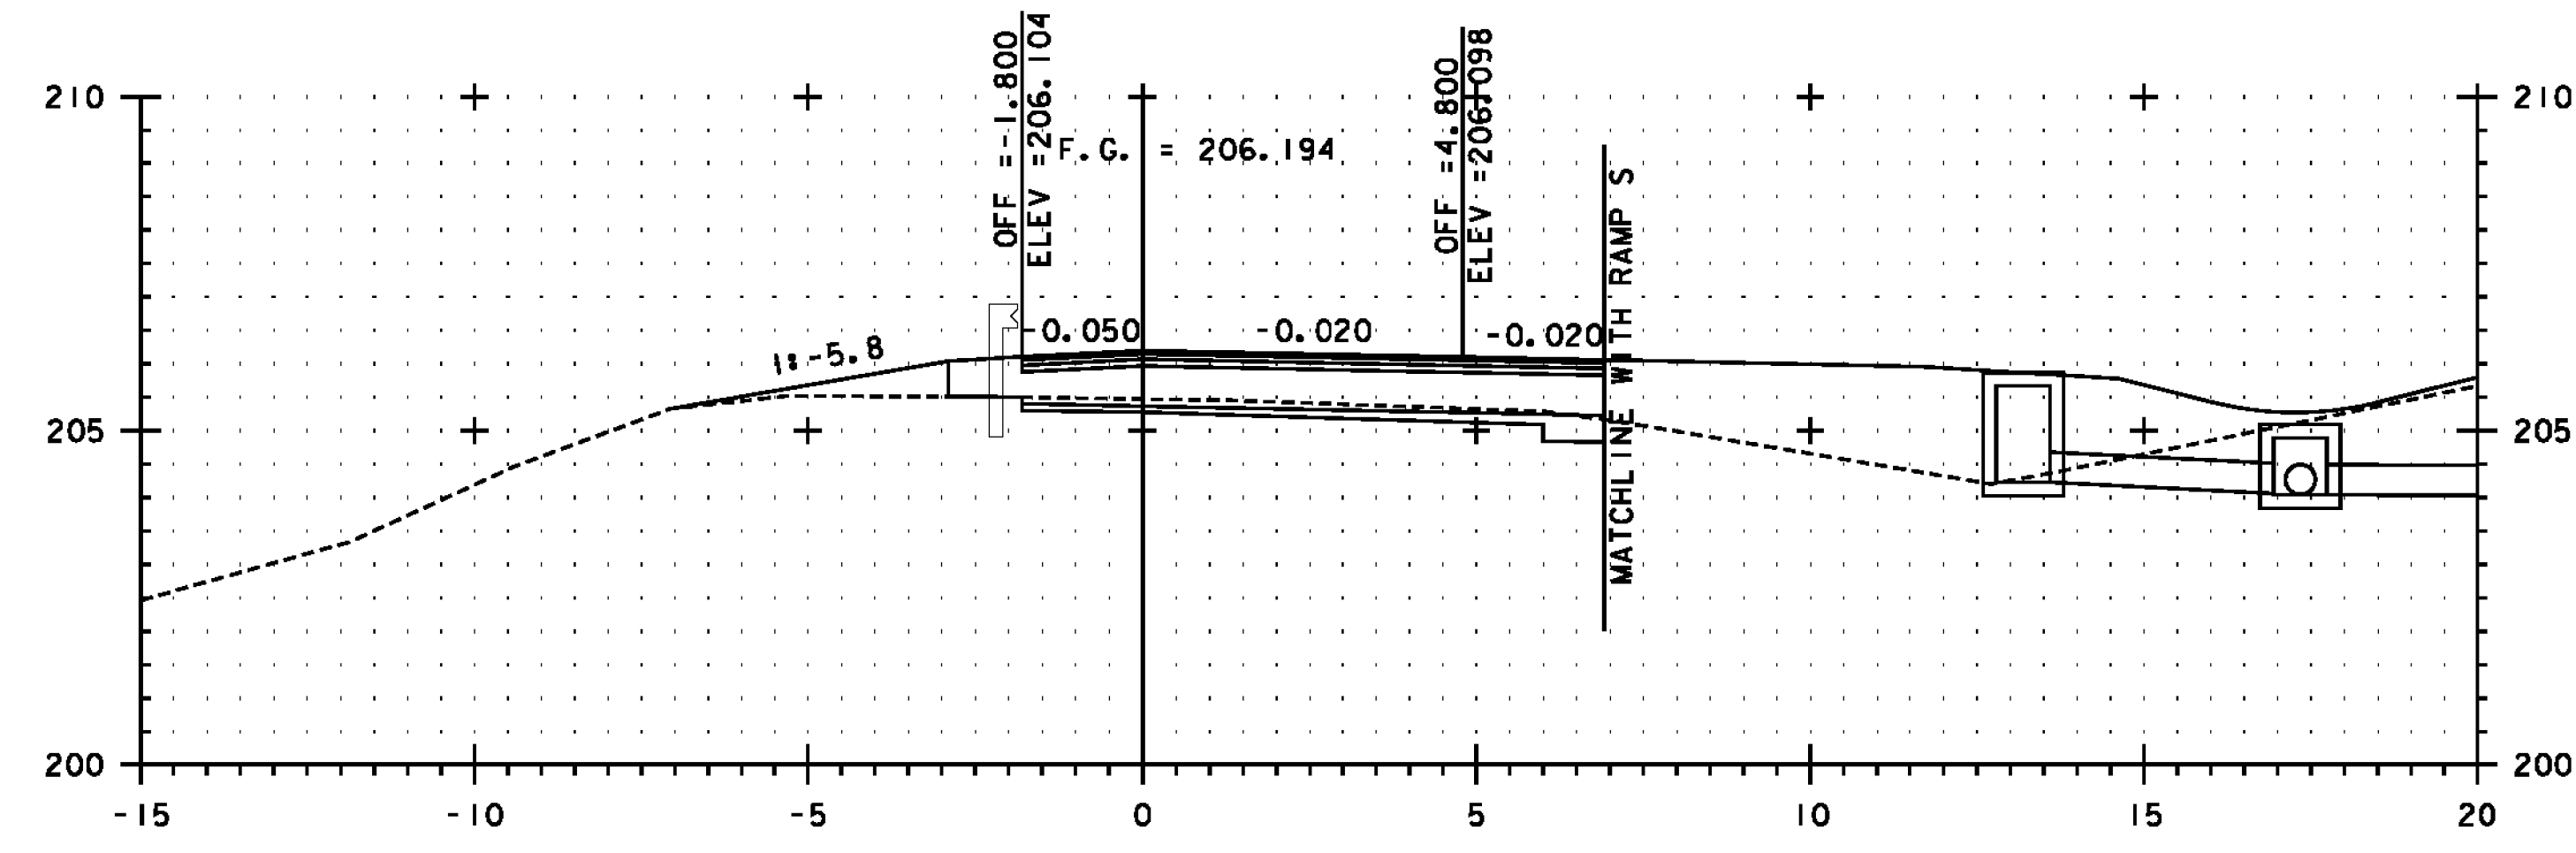


SB 11+020

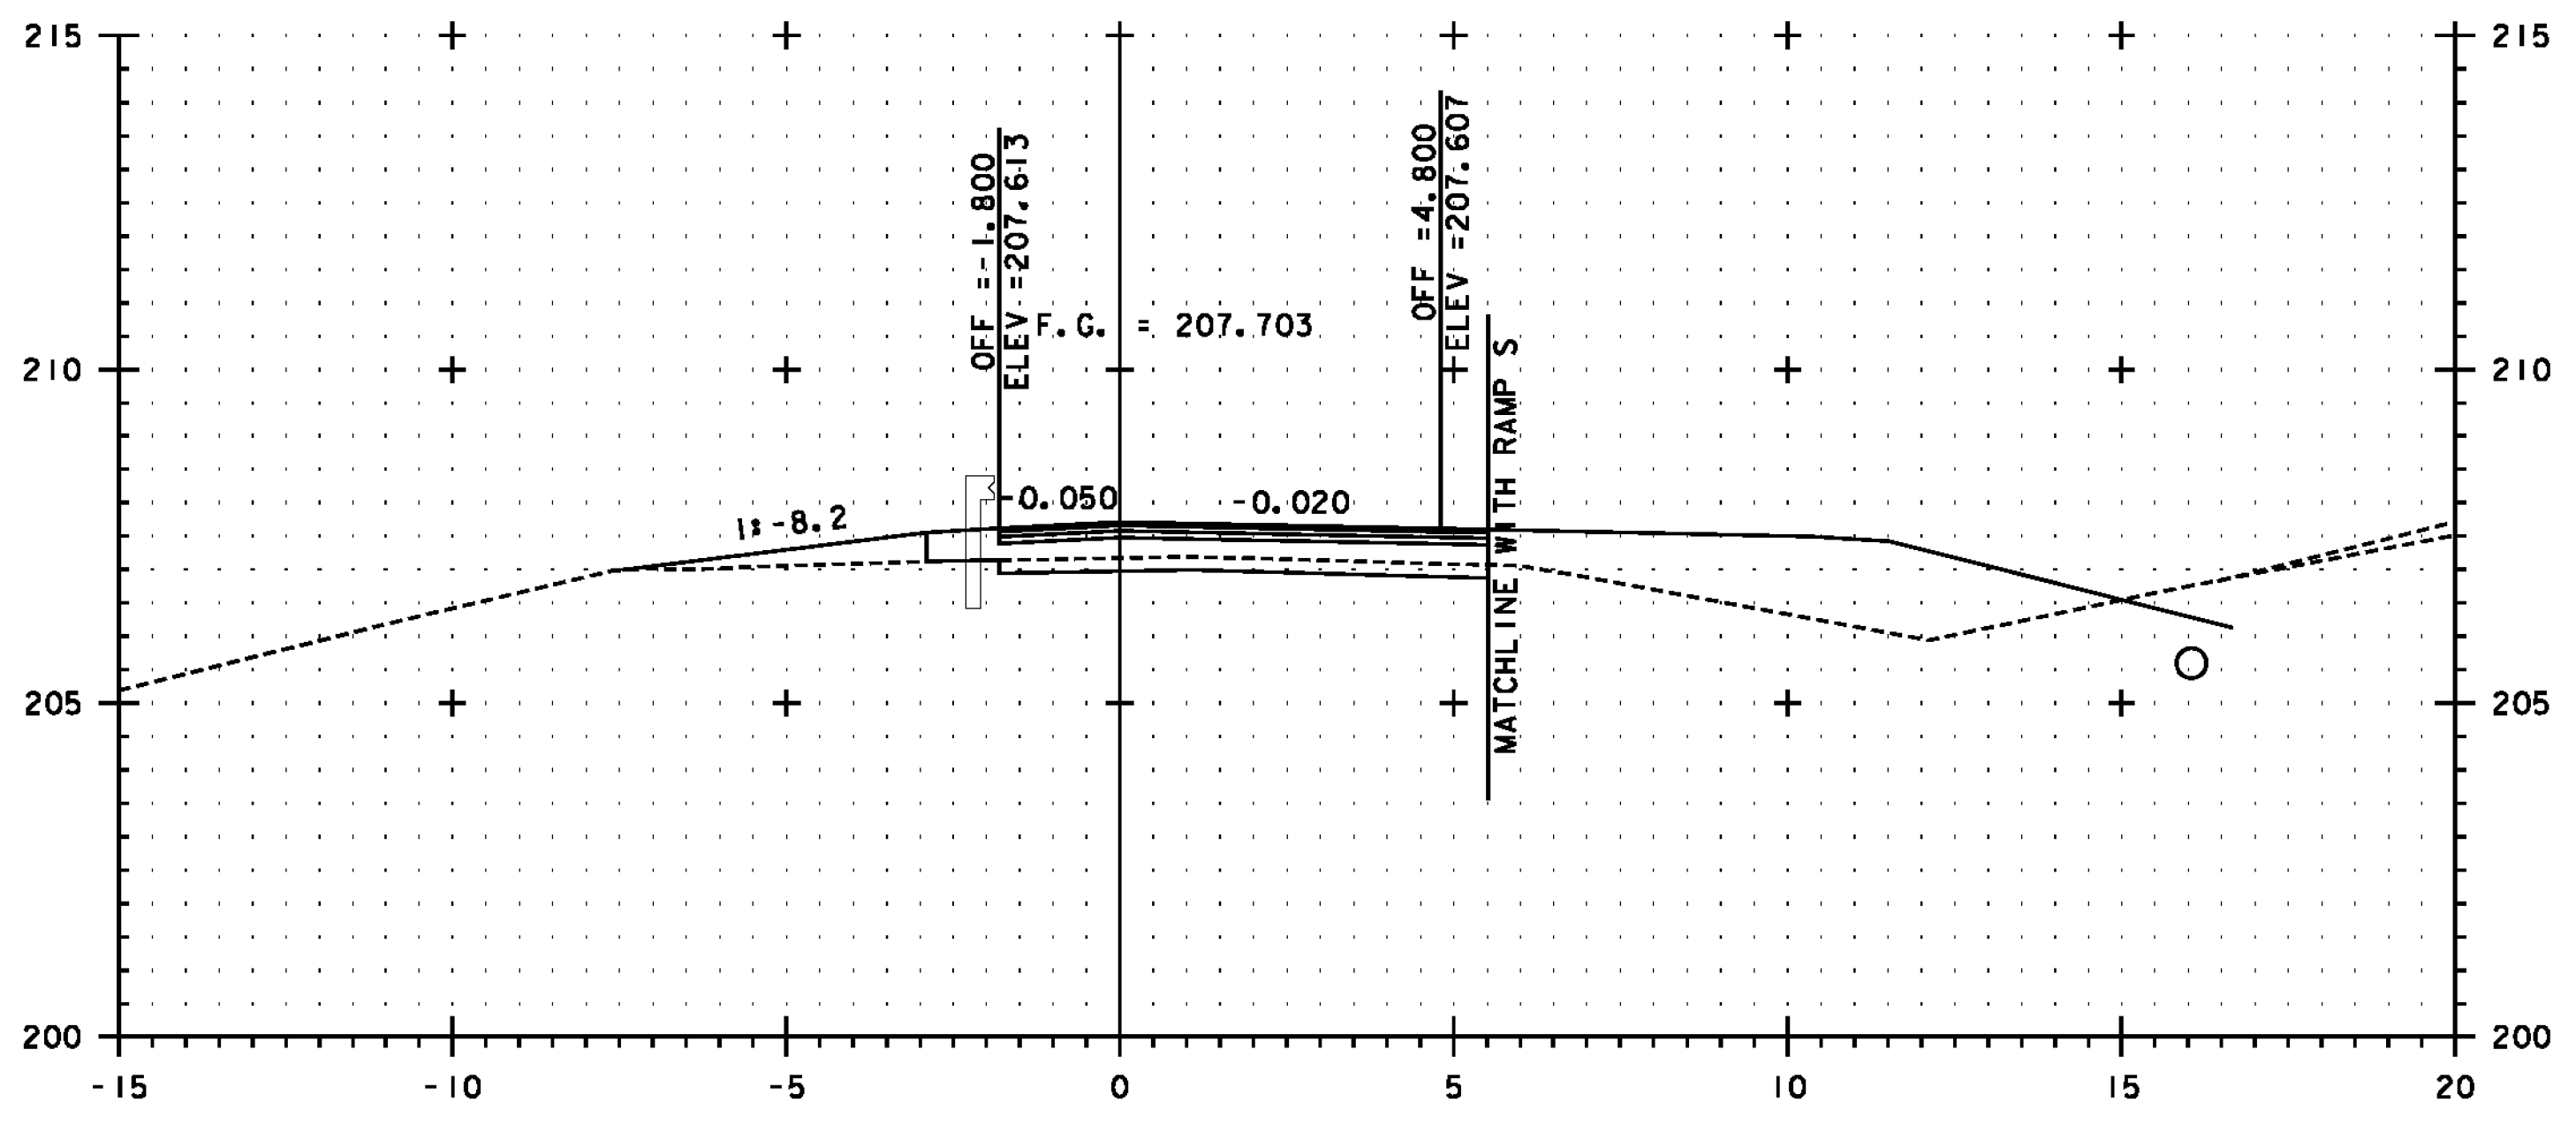

SB 11+060

SEE NOTE ON SHEET 447

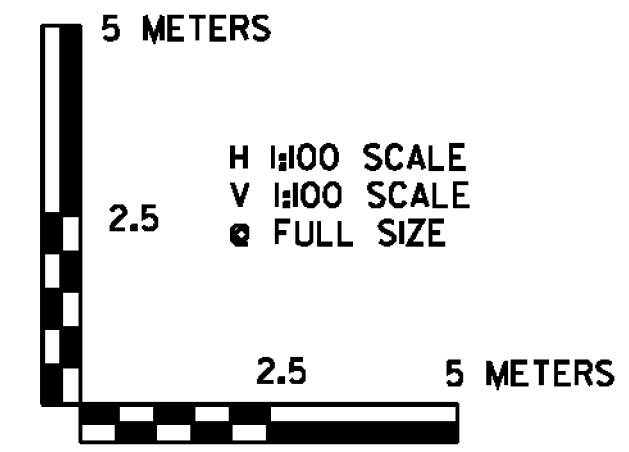

PROJECT NAME:	BENNINGTON	FILE NAME:	...\\plot_files\zd307c4xs.7SB.ptf	PLOT DATE:	1/26/2010
PROJECT NUMBER:	NH 019-(154)	DESIGN SUPERVISOR:	GREG EDWARDS	DRAWN BY:	STANTEC
		DESIGNED BY:	MARC FOISY	CHECKED BY:	GARY SANTY
			US 7 SB CROSS SECTION SBX-18	SHEET	464 OF 468

1/26/2010 4:59:02 PM v:\1953\getlive\19530002\transport\1101\dr\dwg\confr\cp1_4\plot_files\zd307c4xs_7SB.ptf