




SB 11+140

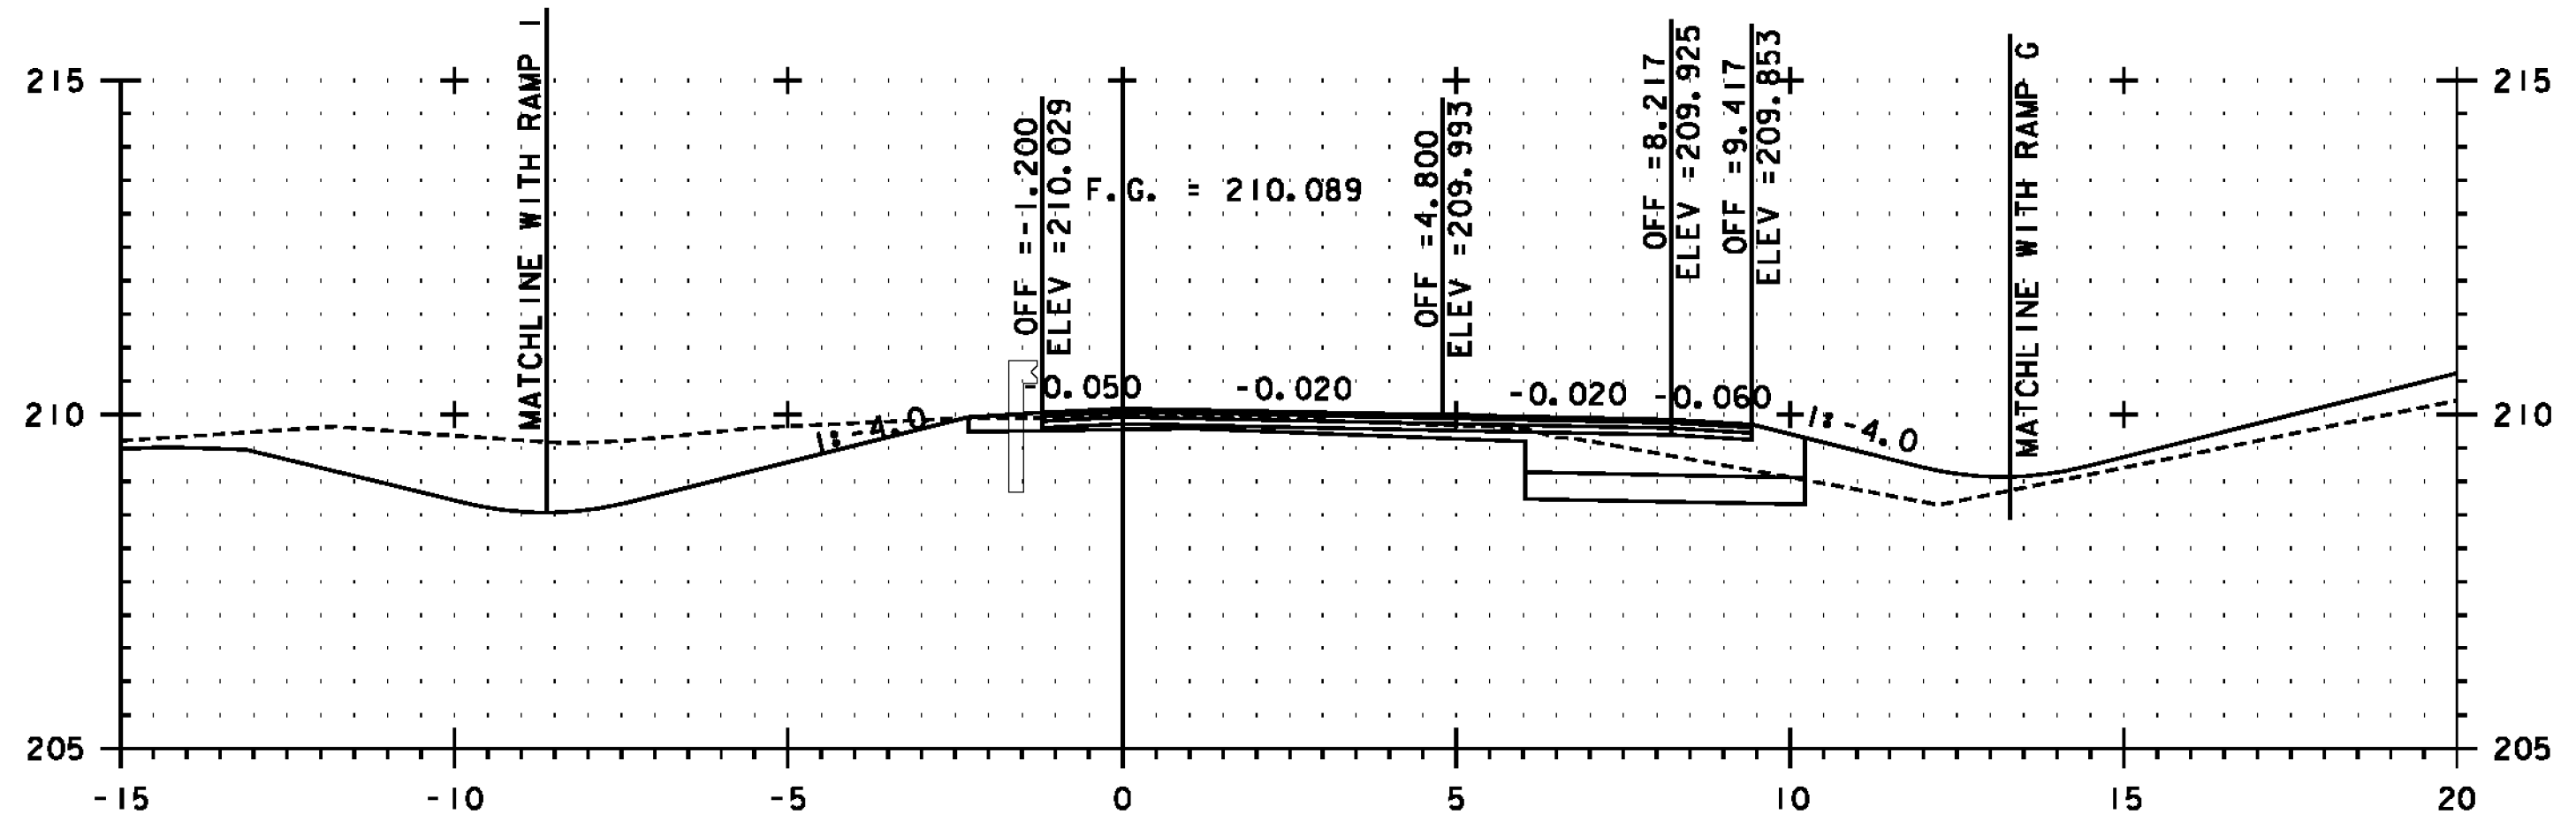


SB 11+120

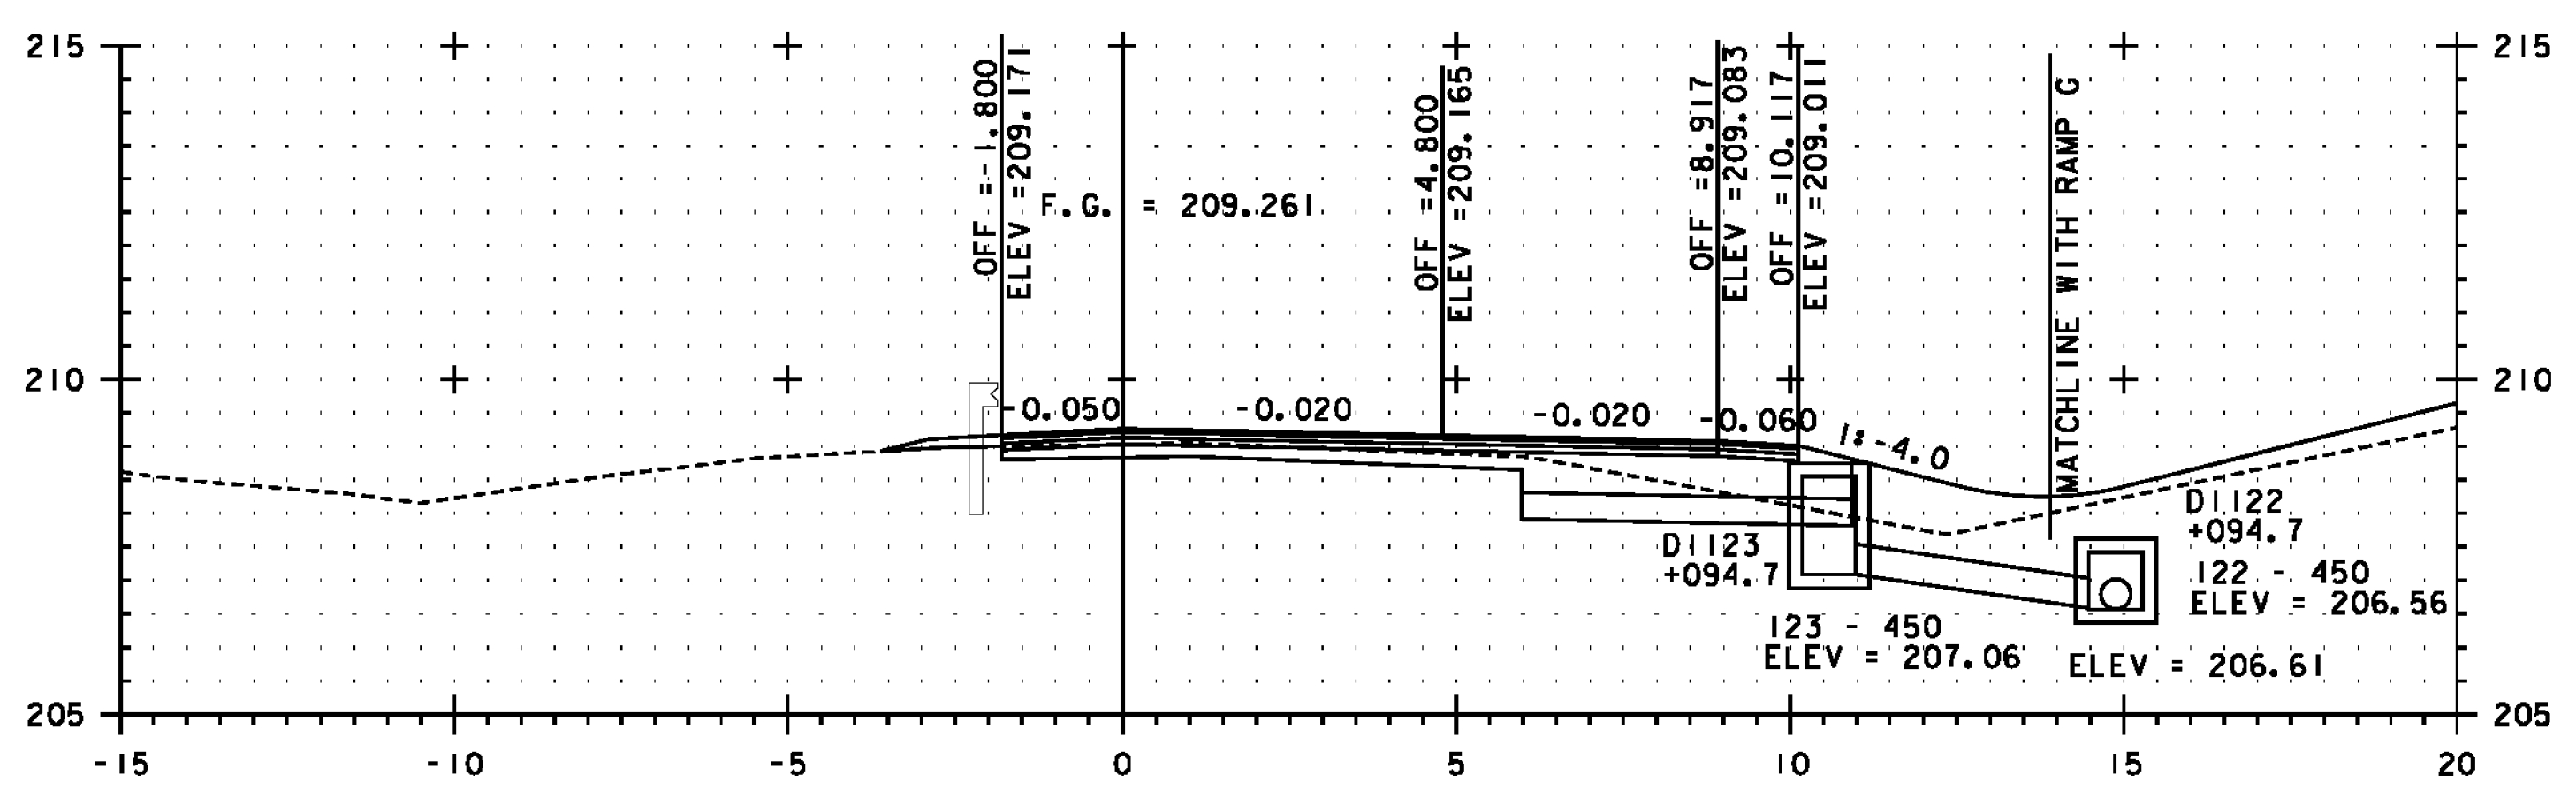

SB 11+100

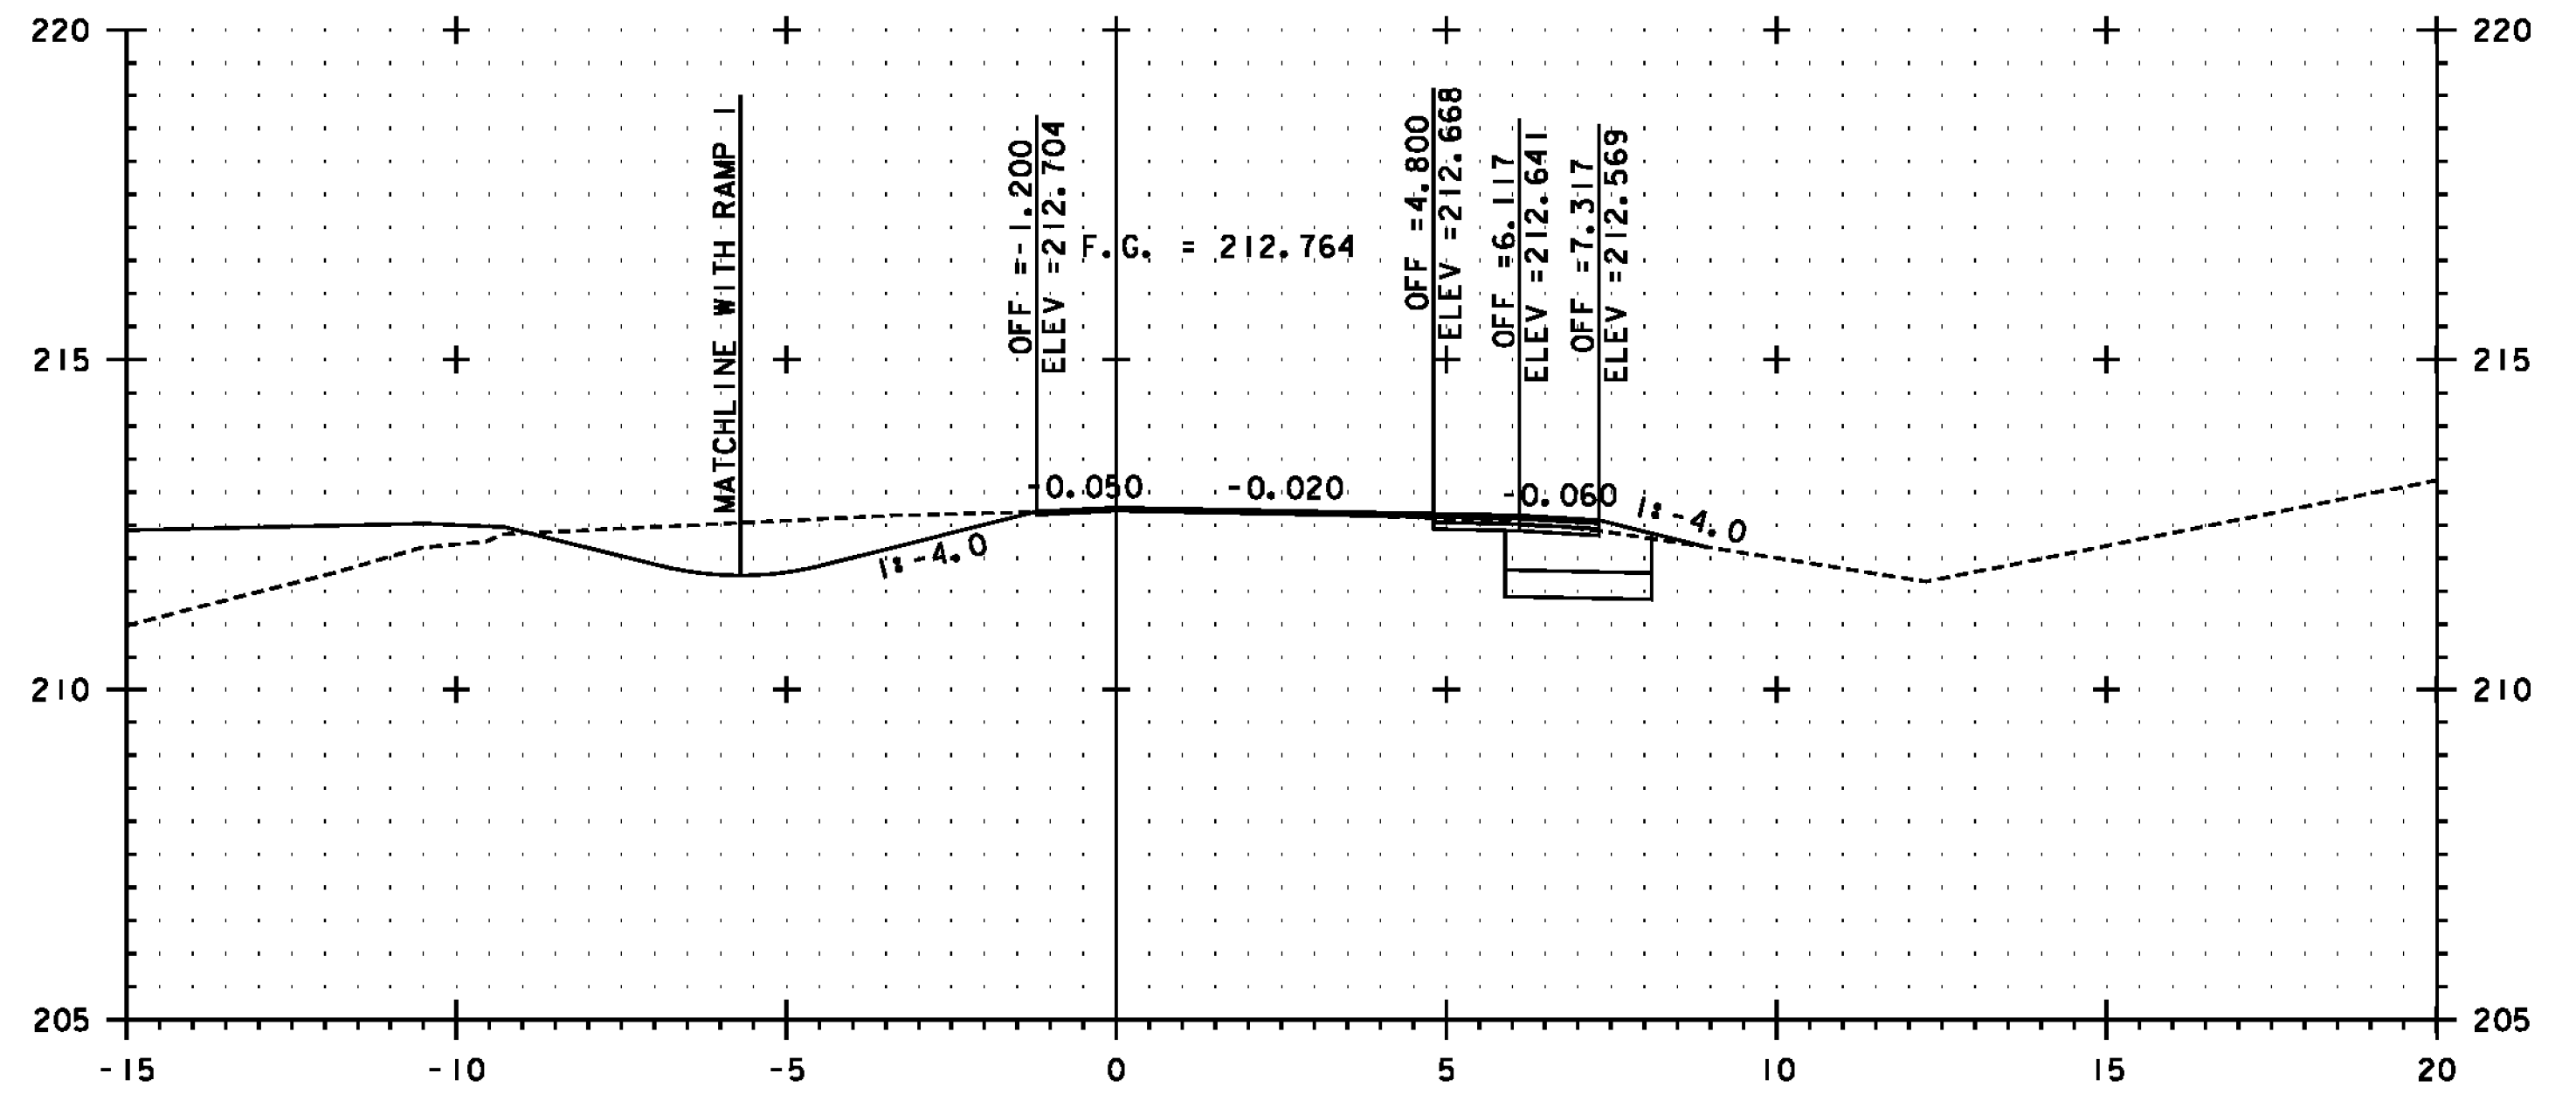


SB 11+180

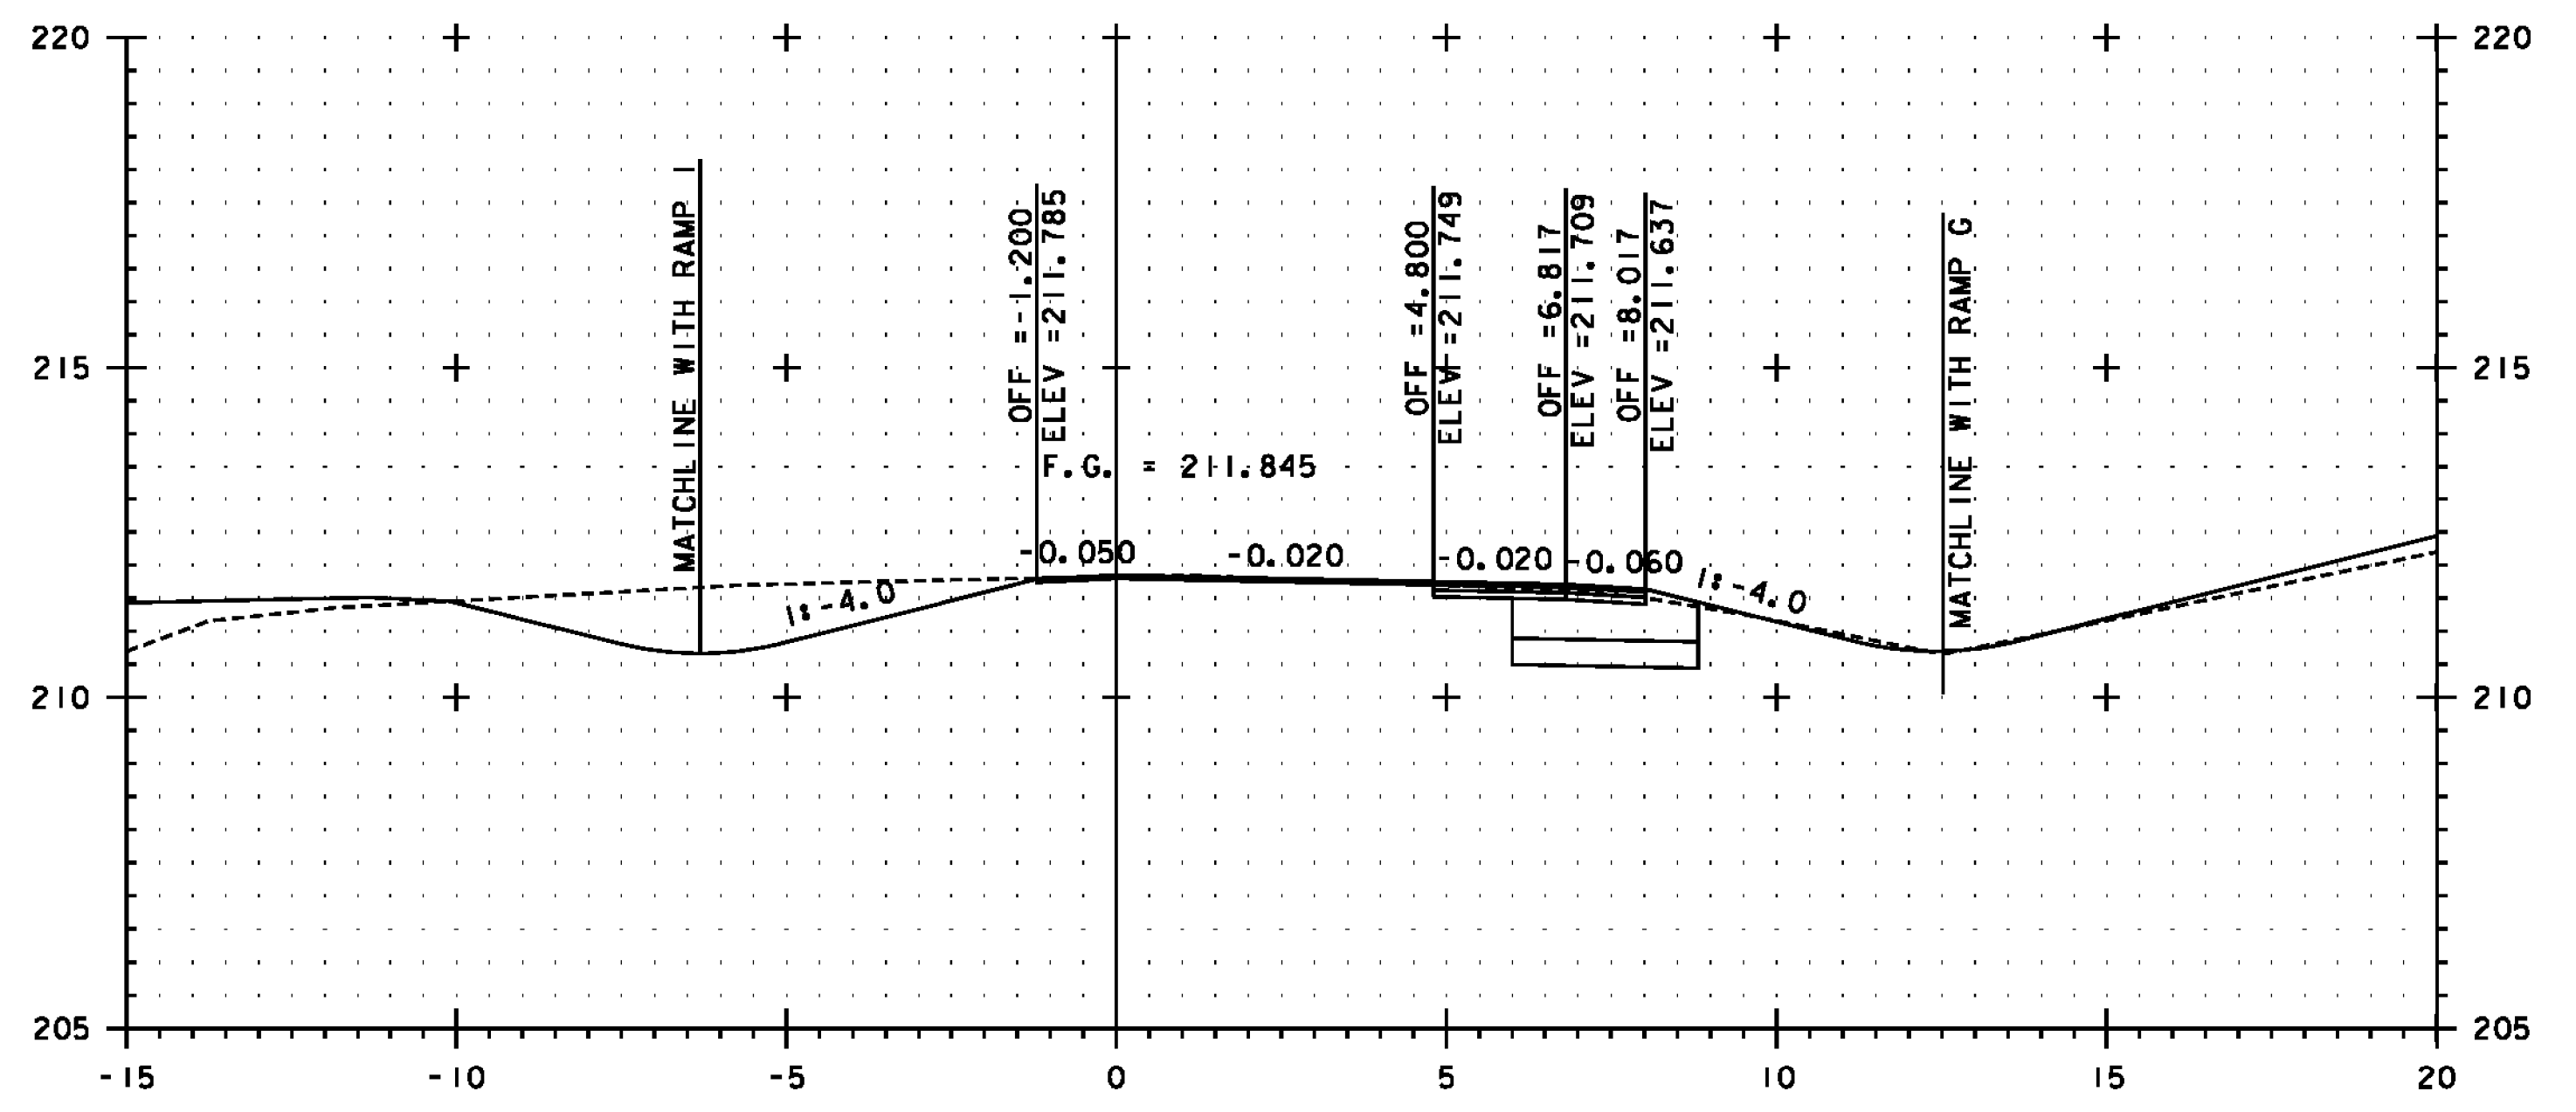

SB 11+160

SEE NOTE ON SHEET 447

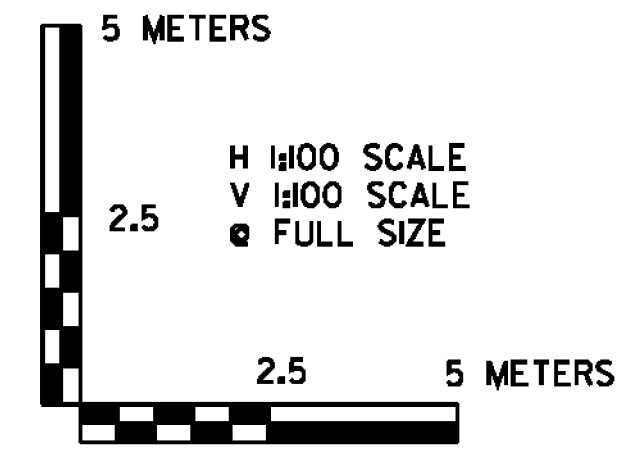

PROJECT NAME:	BENNINGTON	PLOT DATE:	1/26/2010
PROJECT NUMBER:	NH 019-(154)	DRAWN BY:	STANTEC
FILE NAME:	...plot_files\zd307c4xs.7SB.ptf	DESIGNED BY:	GARY SANTY
DESIGN SUPERVISOR:	GREG EDWARDS	CHECKED BY:	GARY SANTY
DESIGNED BY:	MARC FOISY	SHEET	465 OF 468
US 7 SB CROSS SECTION SBX-19			

1/26/2010 4:59:03 PM v:\1953\getlive\1953\0002\tr\anspor\1101\dr\mg\com\tr\cst_4\plot_files\zd307c4xs_7SB.ptf