




SB 11+240

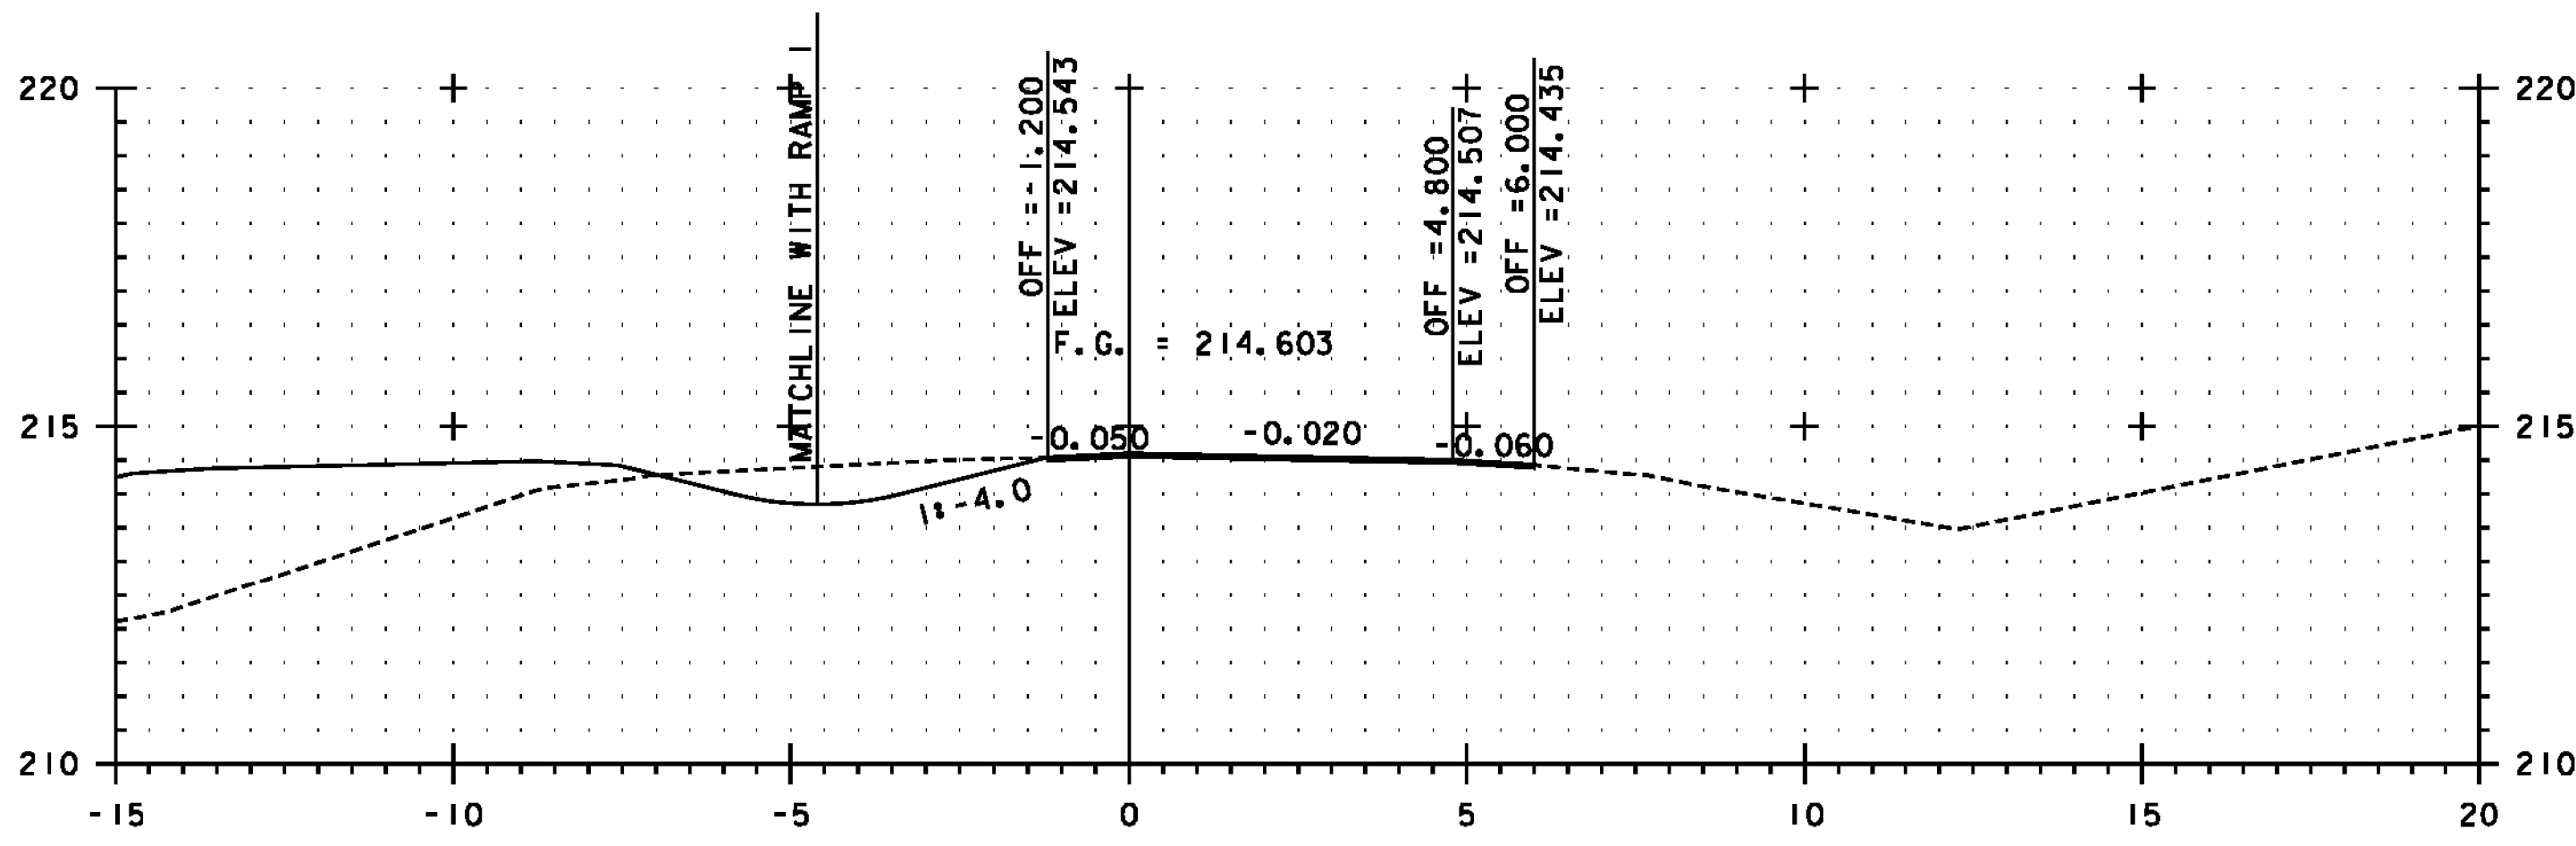


SB 11+220

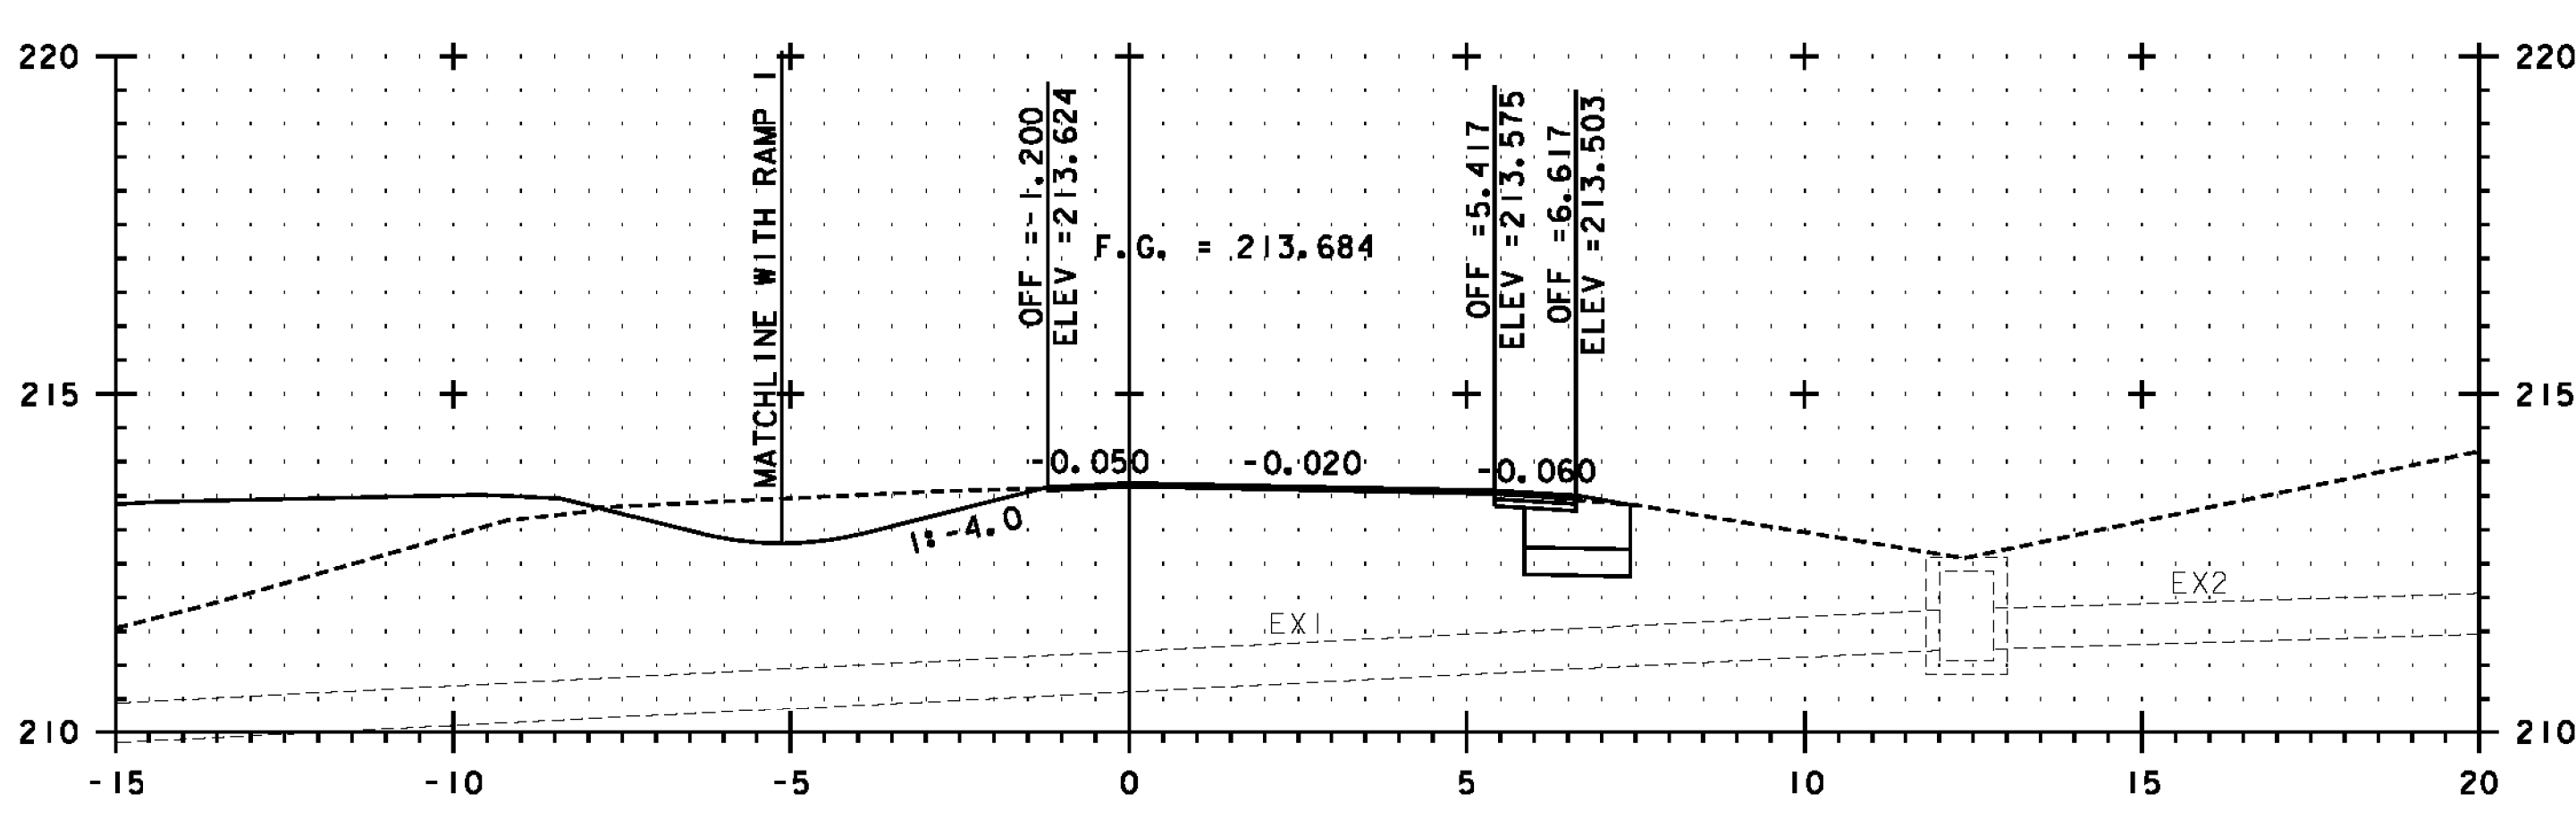

SB 11+200

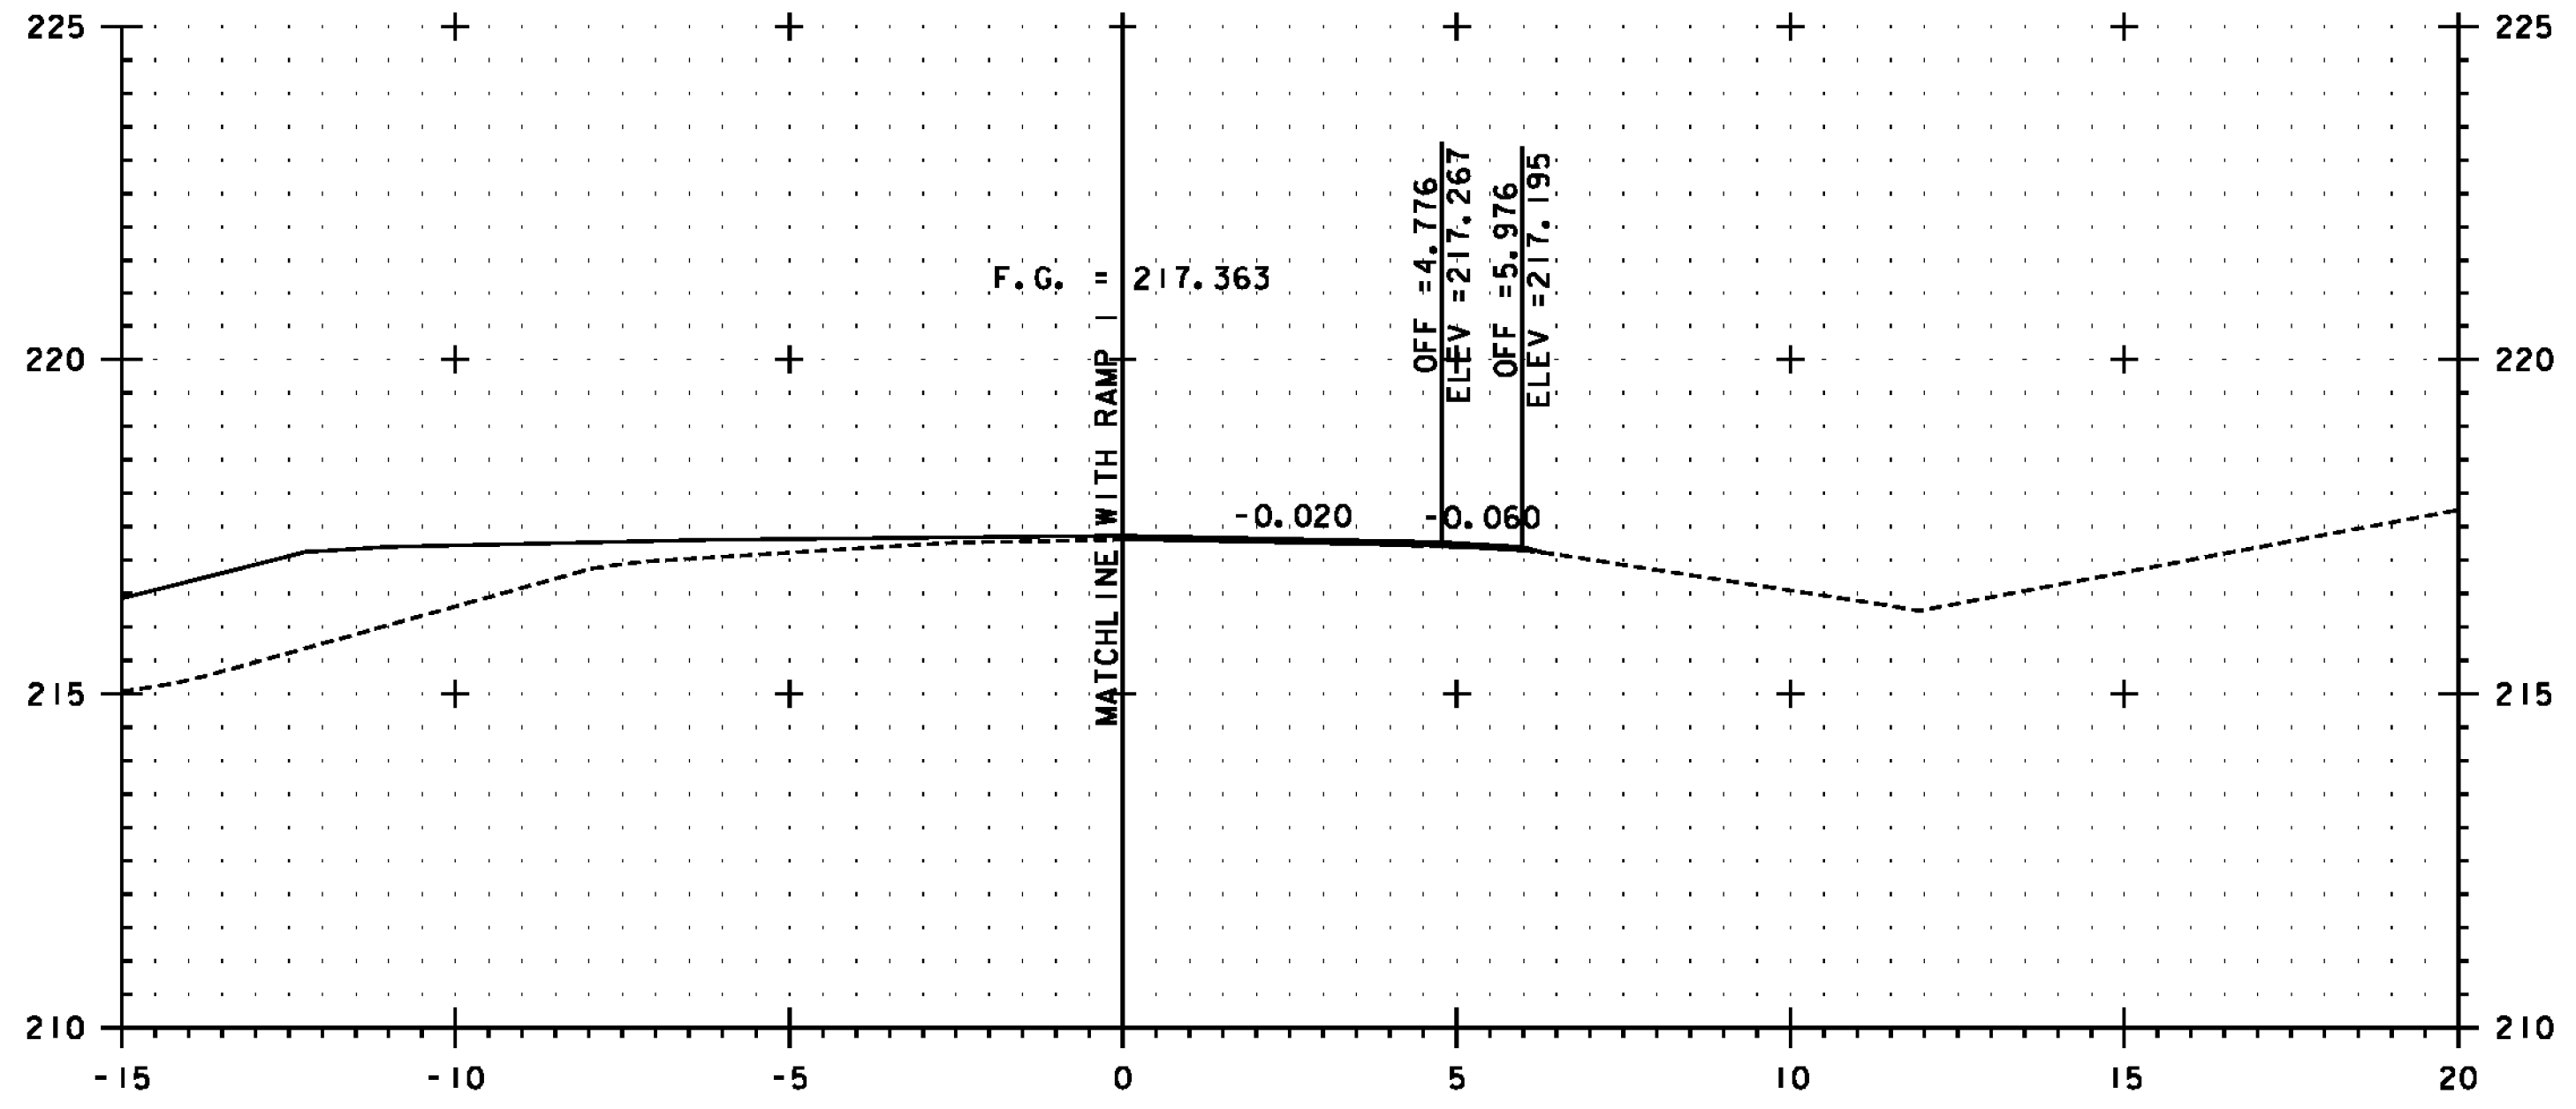


SB 11+280

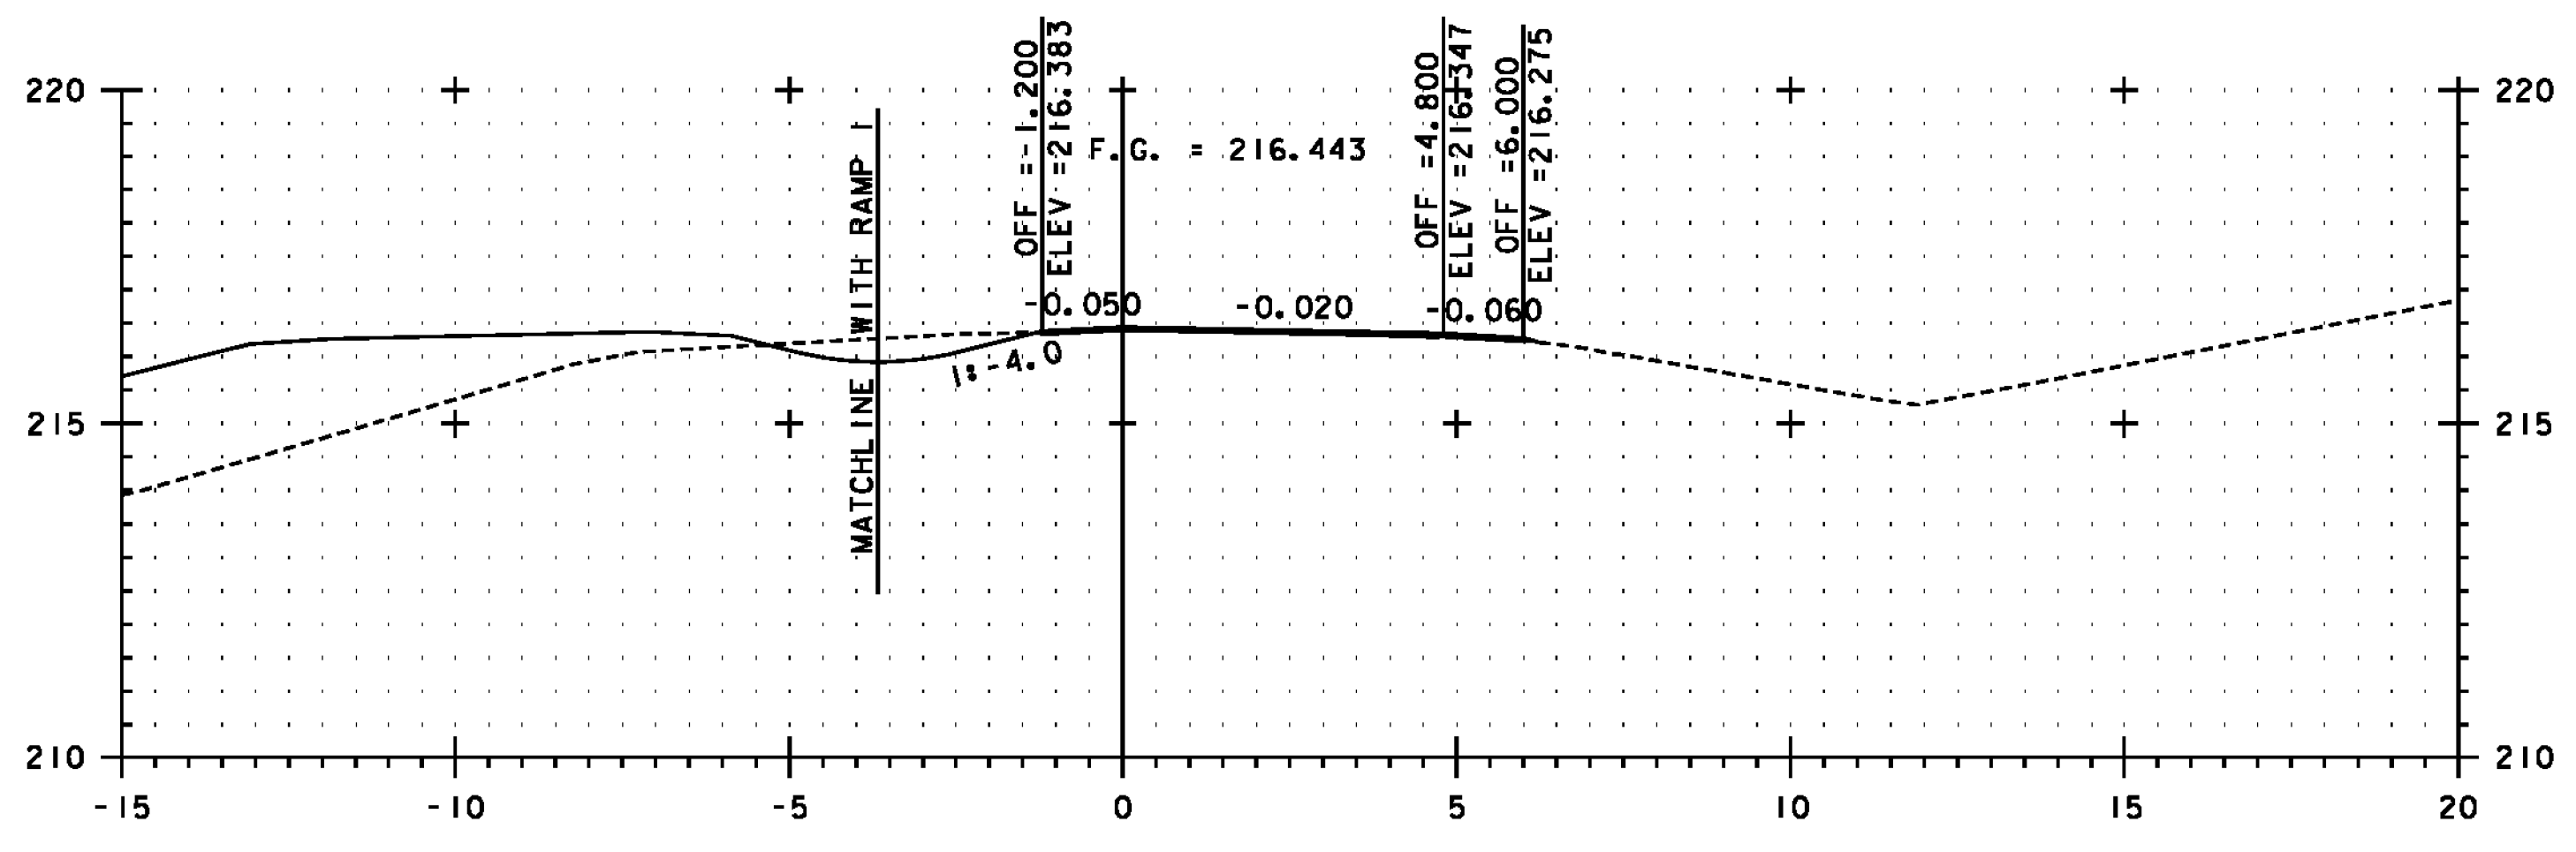

SB 11+260

SEE NOTE ON SHEET 447

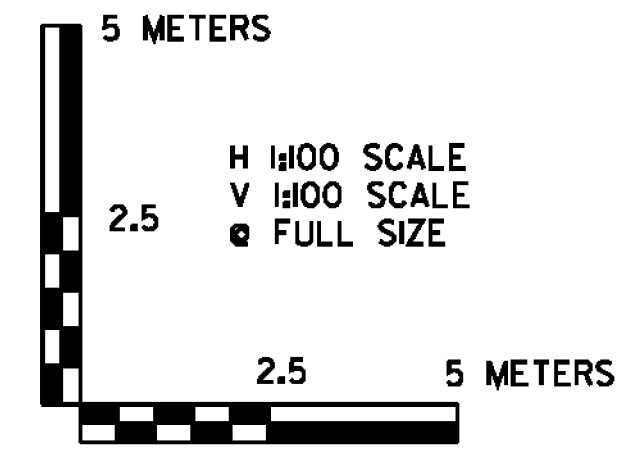

PROJECT NAME:	BENNINGTON	PLOT DATE:	1/26/2010
PROJECT NUMBER:	NH 019-(154)	DRAWN BY:	STANTEC
FILE NAME:	...plot_files\zd307c4xs.7SB.ptf	DESIGNED BY:	MARC FOISY
DESIGN SUPERVISOR:	GREG EDWARDS	CHECKED BY:	GARY SANTY
US 7 SB CROSS SECTION SBX-20		SHEET 466 OF 468	

1/26/2010 4:59:04 PM v:\1953\getlive\19530002\transportation\dwg\conform\4\plot\_files\zd307c4xs.7SB.ptf