




SB 11+340

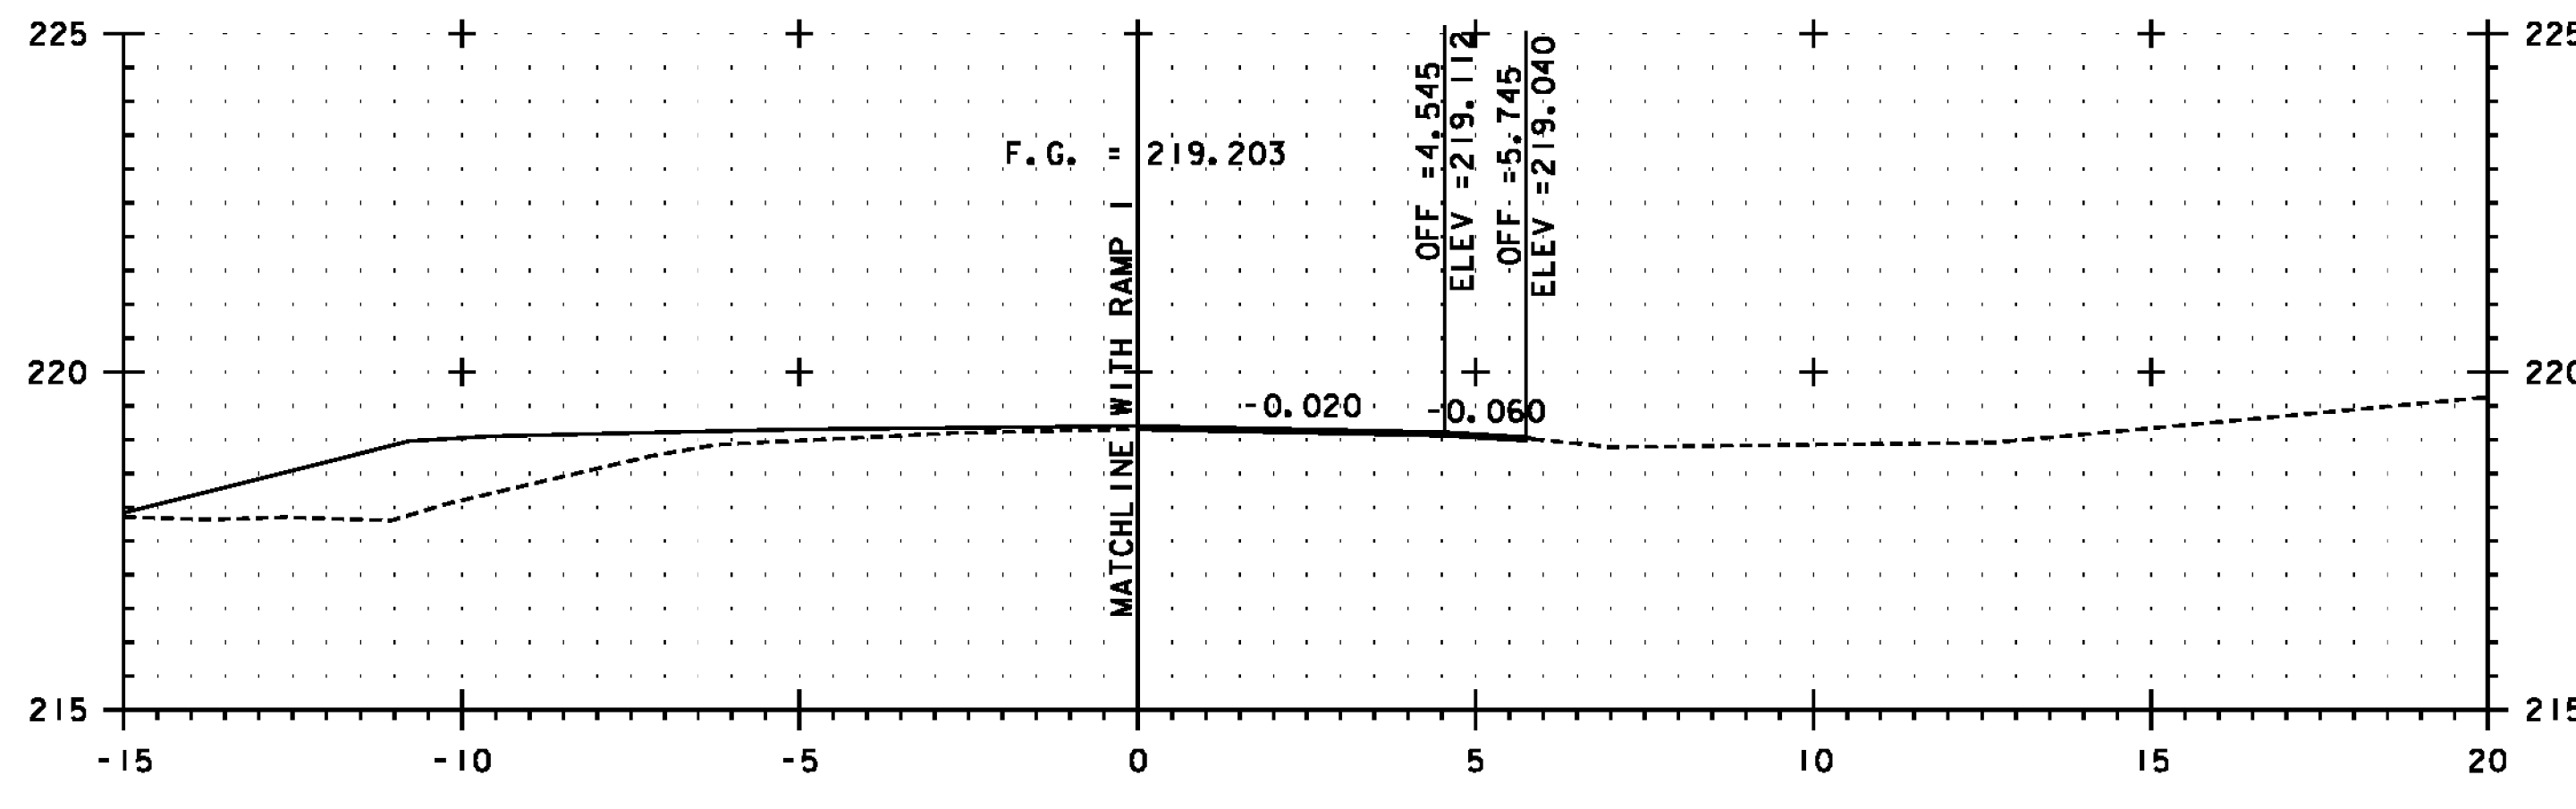


SB 11+320

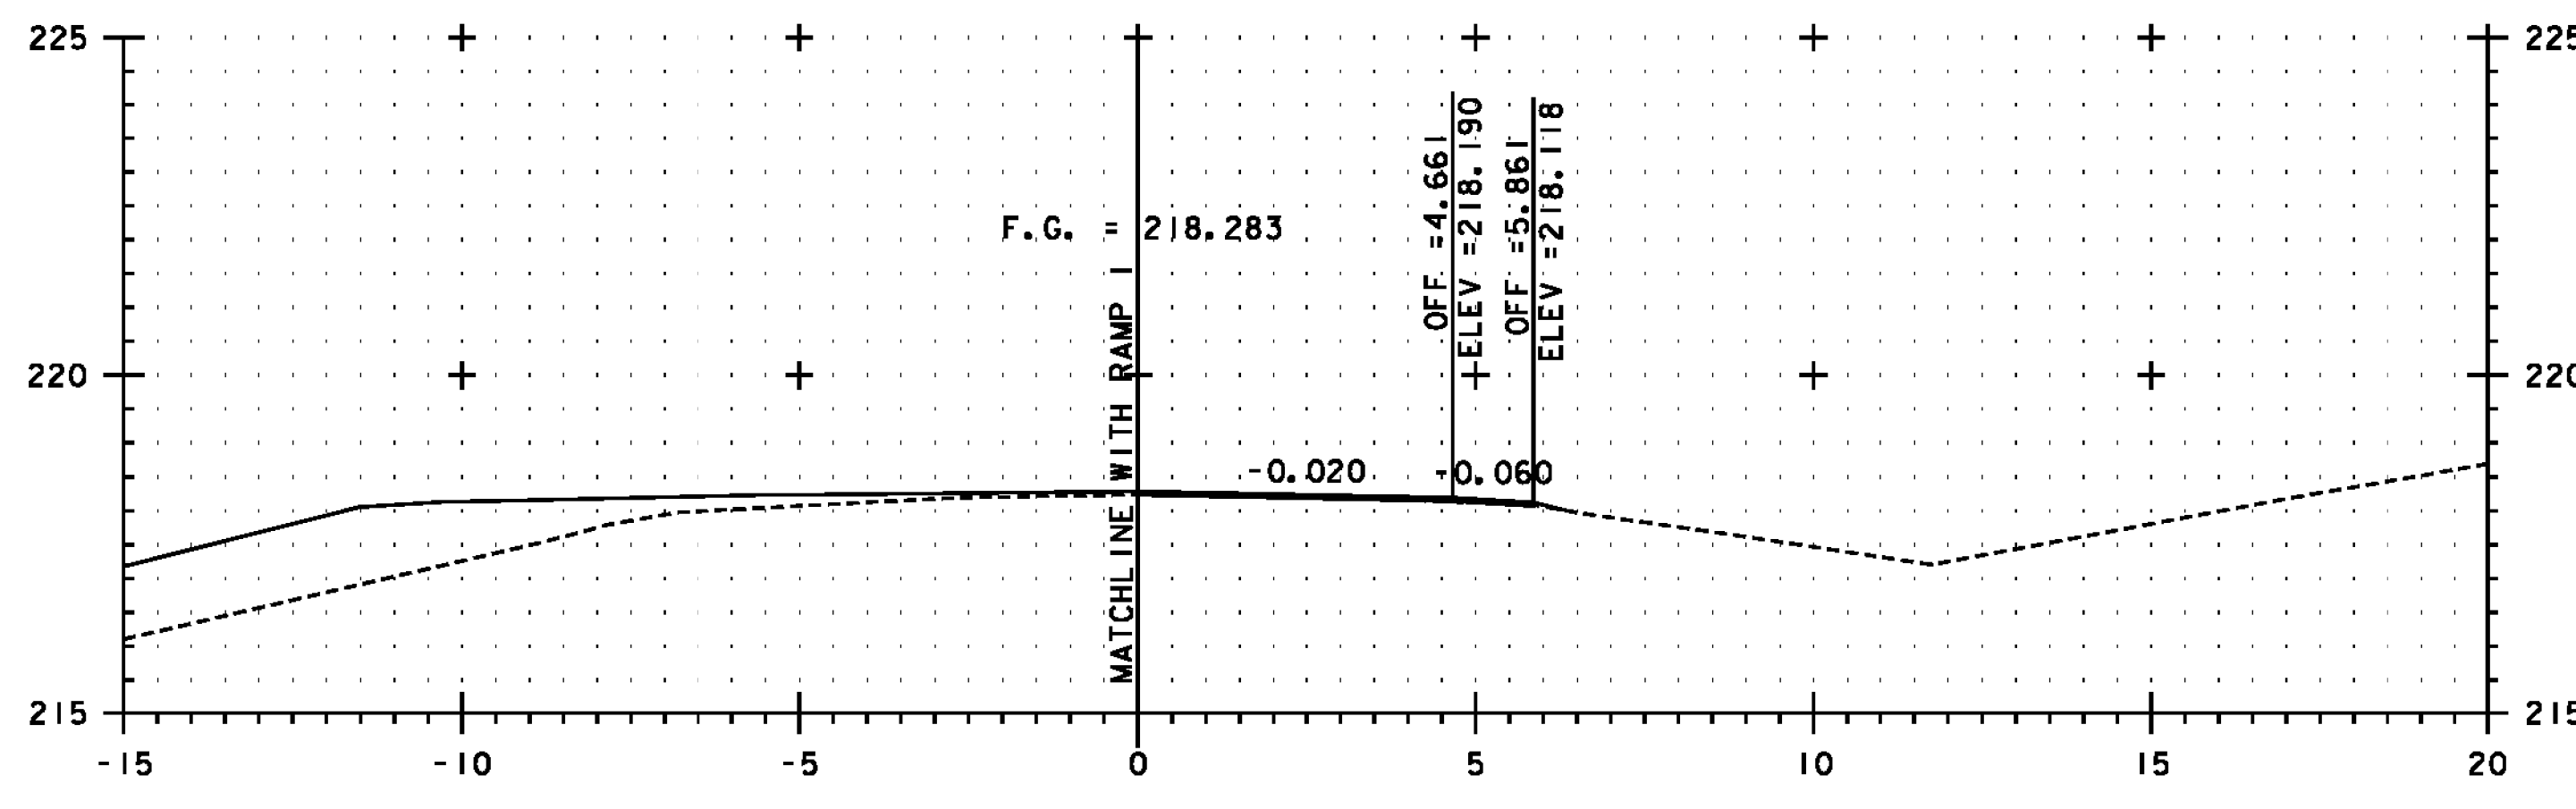

SB 11+300

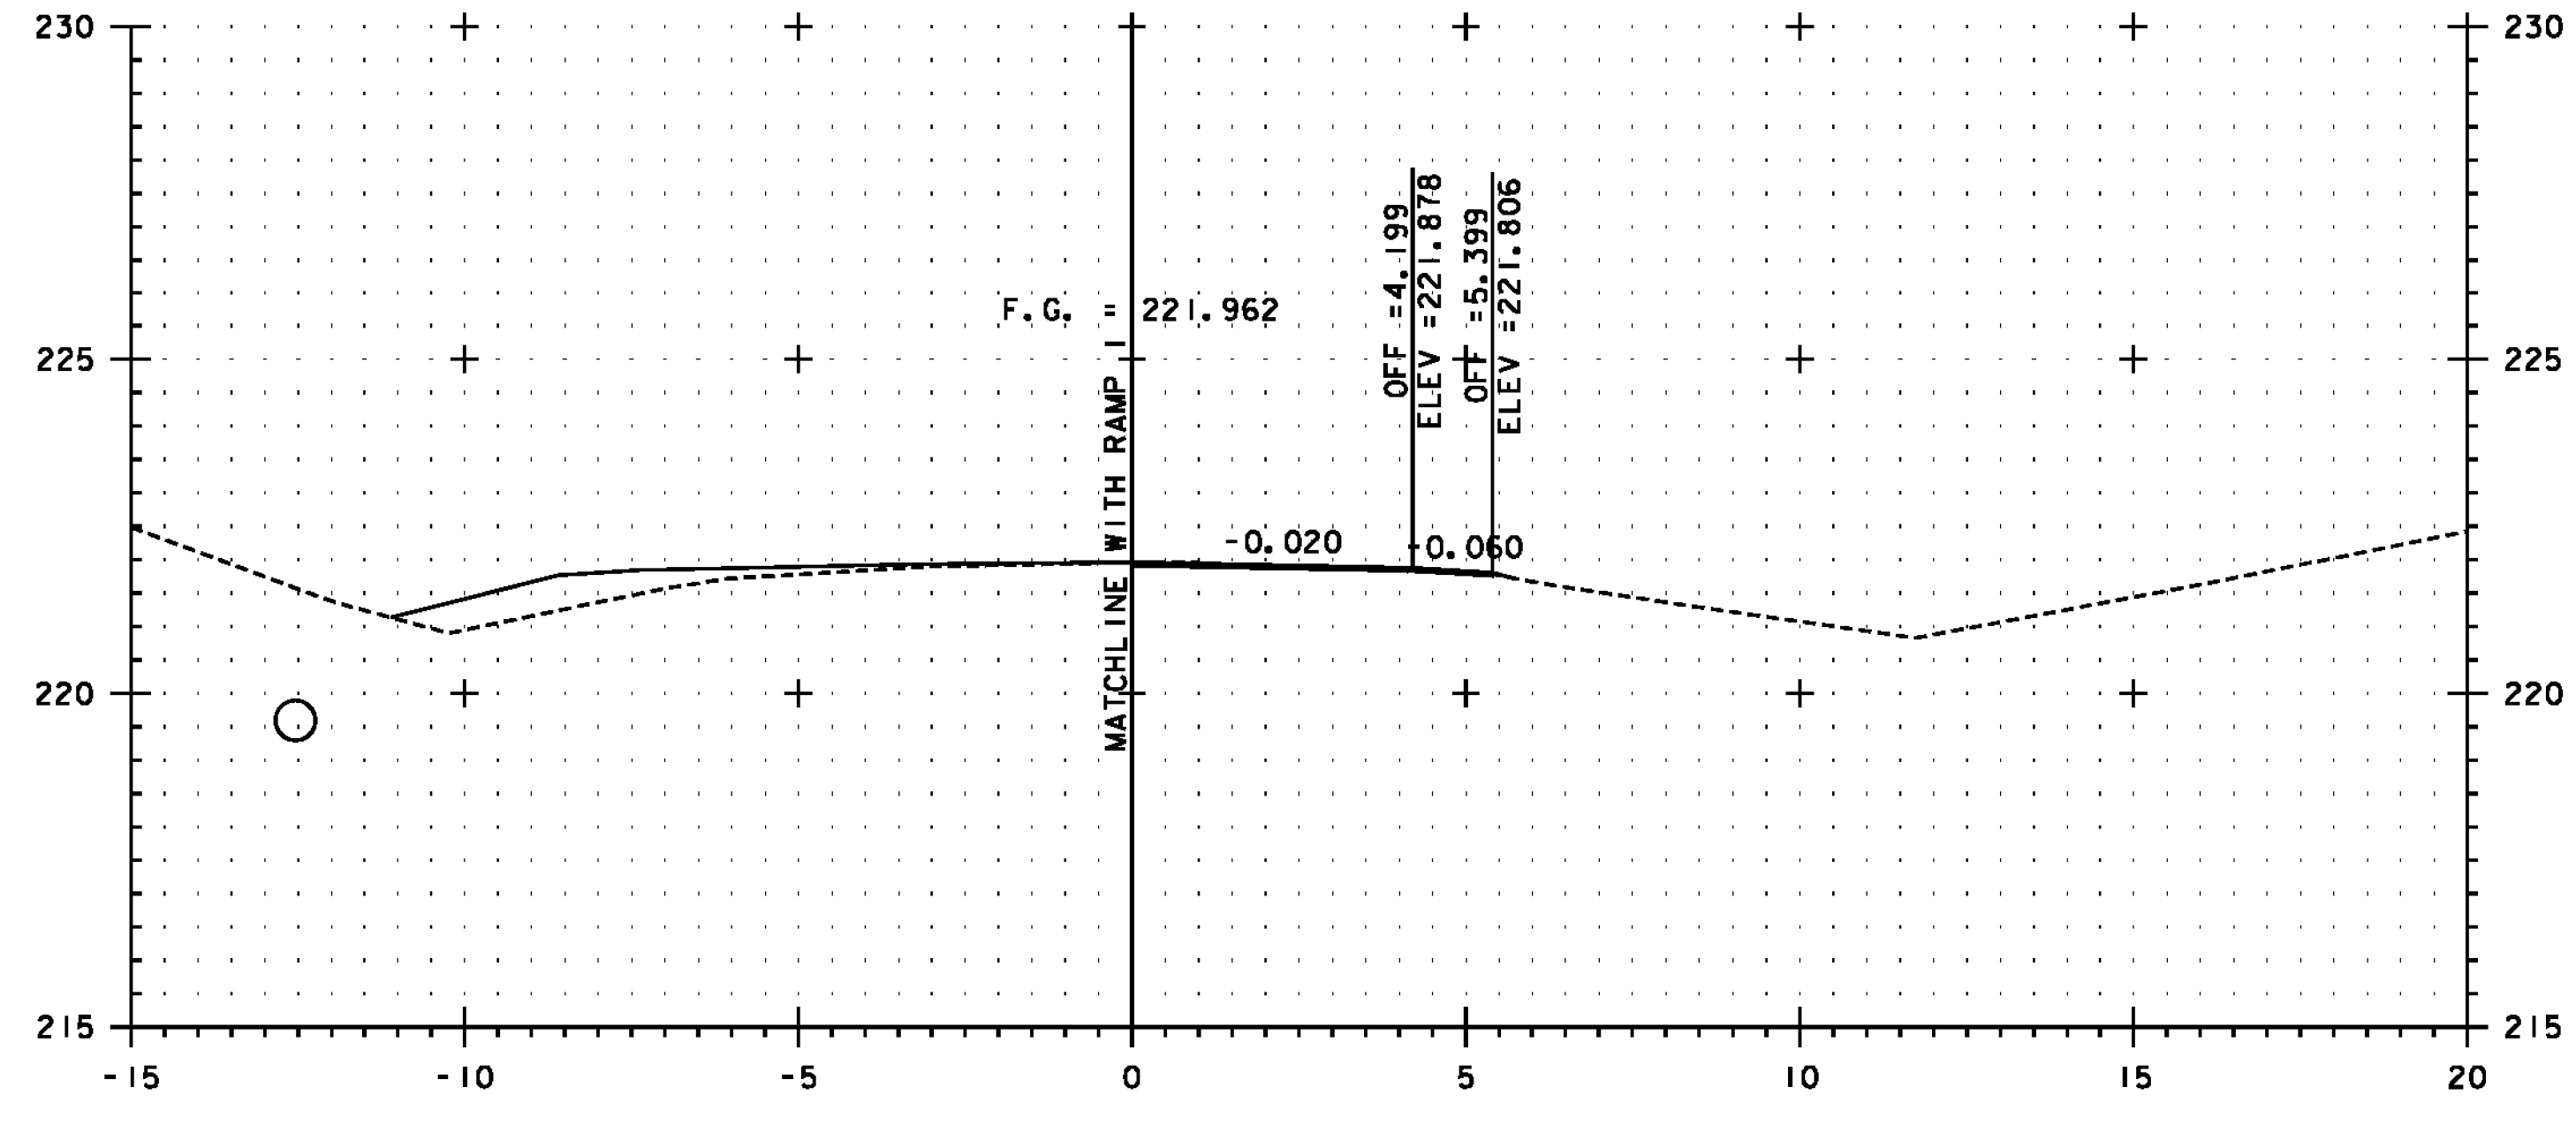


SB 11+380

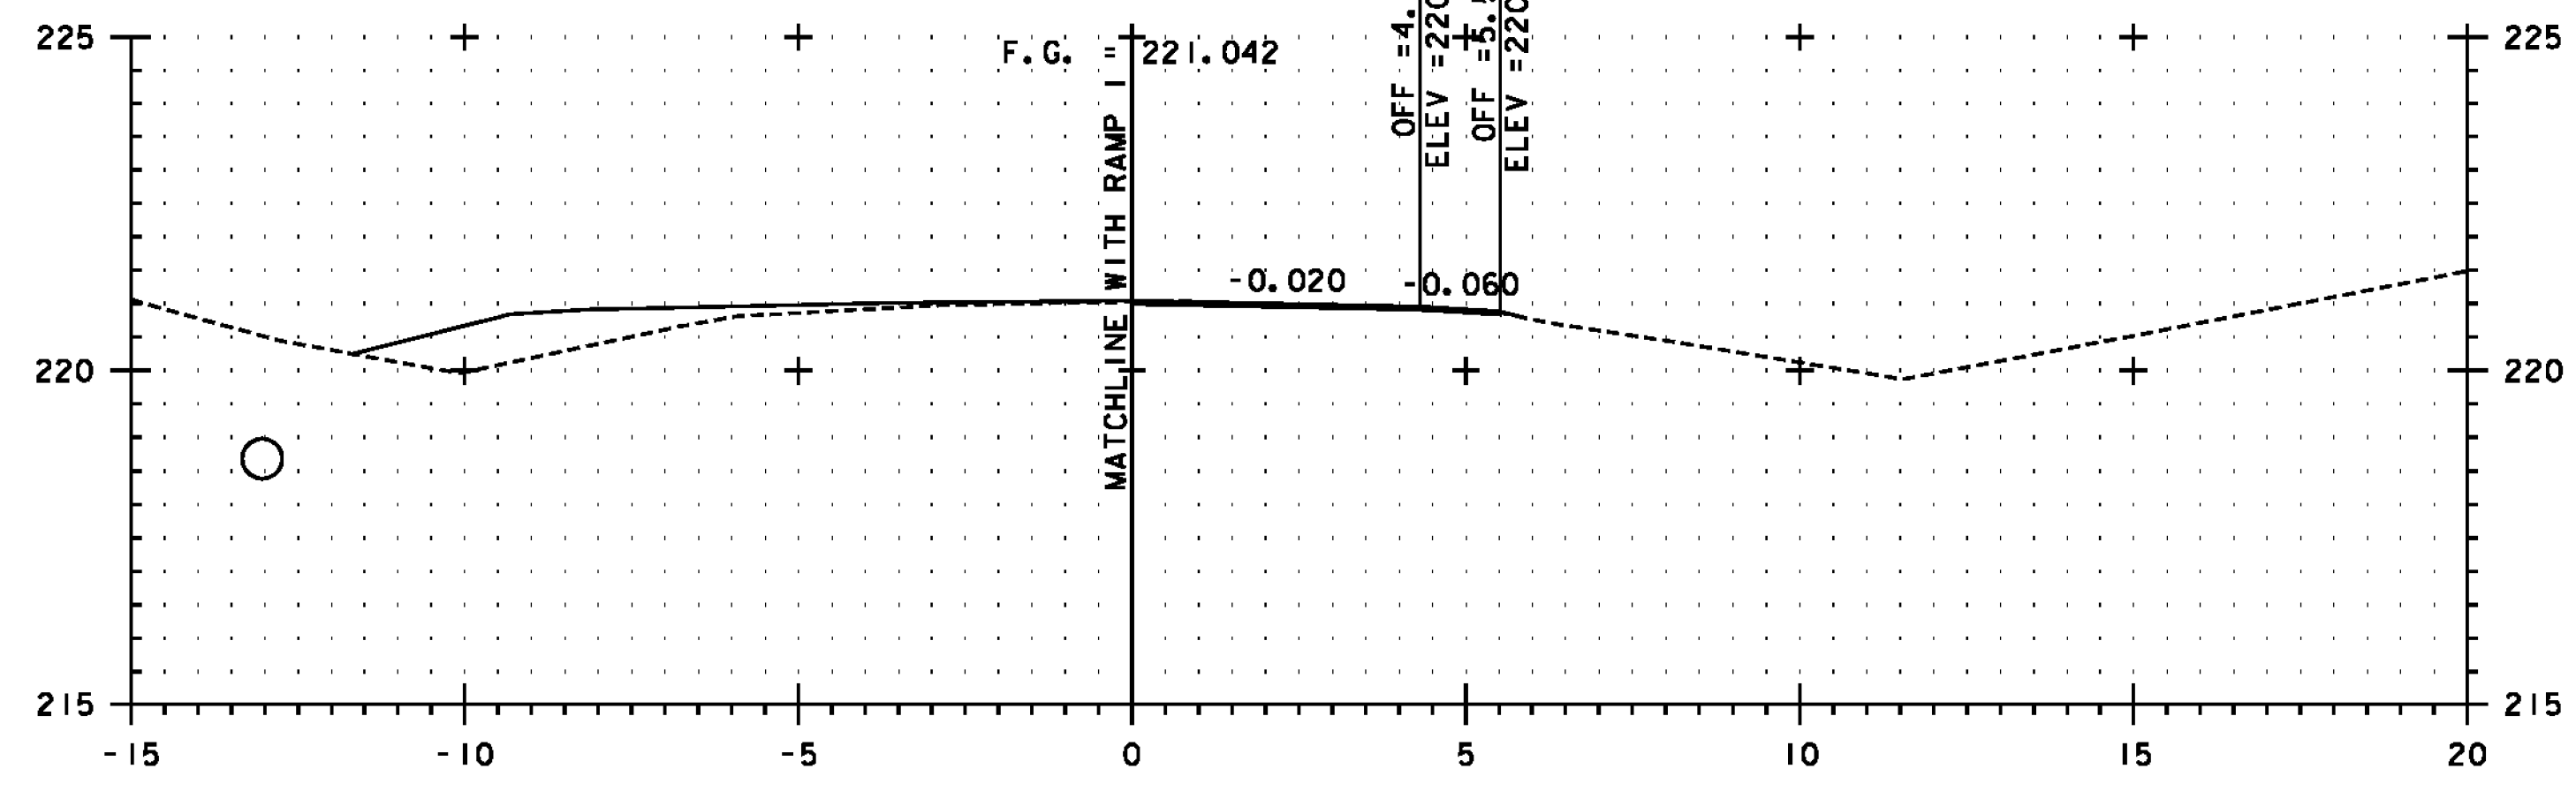

SB 11+360

SEE NOTE ON SHEET 447

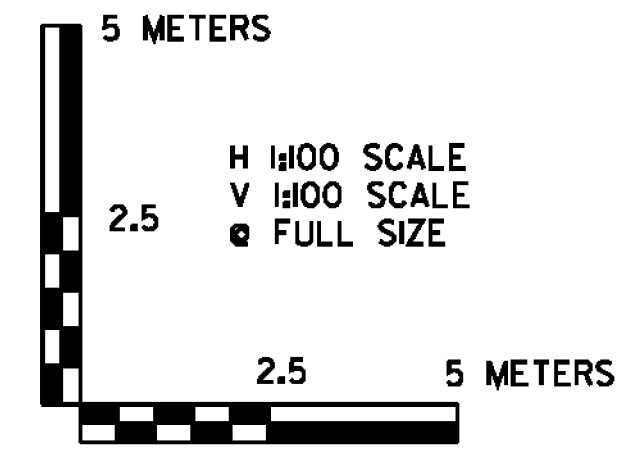

	PROJECT NAME: BENNINGTON	PLOT DATE: 1/26/2010
	PROJECT NUMBER: NH 019-(154)	DRAWN BY: STANTEC
FILE NAME: ...\plot_files\zd307c4xs.7SB.ptf	DESIGNED BY: MARC FOISY	CHECKED BY: GARY SANTY
DESIGN SUPERVISOR: GREG EDWARDS	SHEET 467 OF 468	
US 7 SB CROSS SECTION SBX-21		

I:\2672010_459105_Plan\1953\getlive\1953\0002A\transportation\dwg\eng\confr\cst_4\plot_files\zd307c4xs_7SB.ptf