


SIGN POST DESIGN
 TYPE "B" GROUND
 DETAIL #1
 VT 279 WB STA. 9+550, RT.
 415

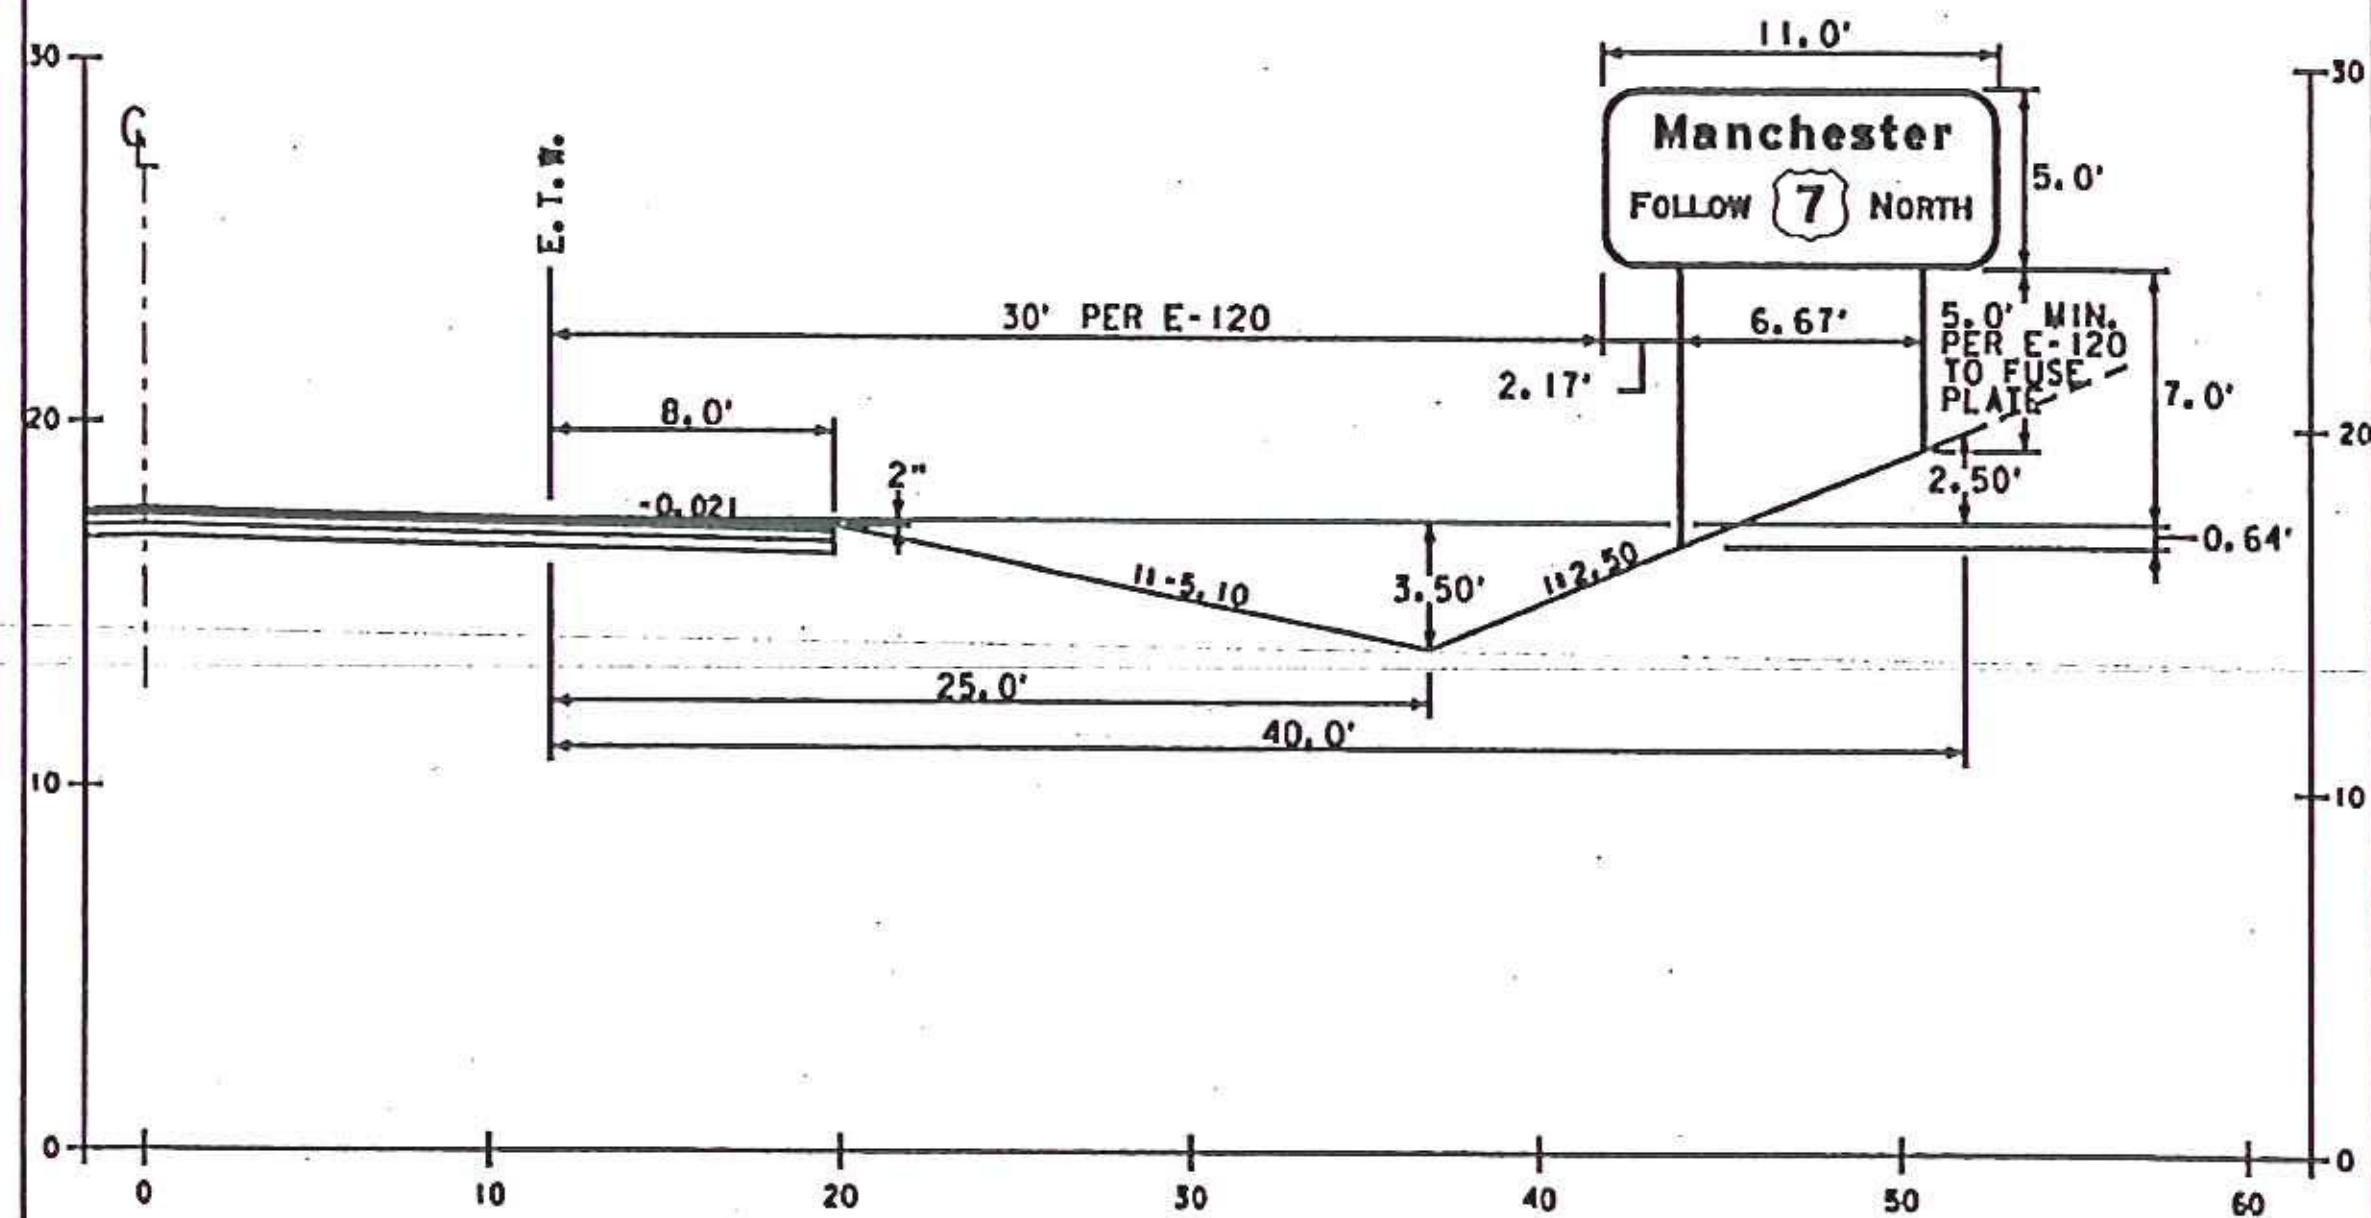

SELECTED W6X9 POSTS

WIDTH x HEIGHT = AREA
 A= 11.0x 5.0' = 55.00 SF

OVERALL LENGTH x Lbs./FT = Lbs.

~~(5' + 7' + 0.64' + 5' + 5')~~ X 9 = ~~203.76 Lbs.~~ = 92.4 KG

12.0' + 13.6' = 25.6' x 9 = 230.4 lbs = 105 kg

2' FOOTING SIZE (SEE VTrans STD. E-161)

600mm