


SIGN POST DESIGN
 TYPE "B" GROUND
 DETAIL #3
 VT 279 EB STA. 11+120, LT. *Rt.*
 (in Median)

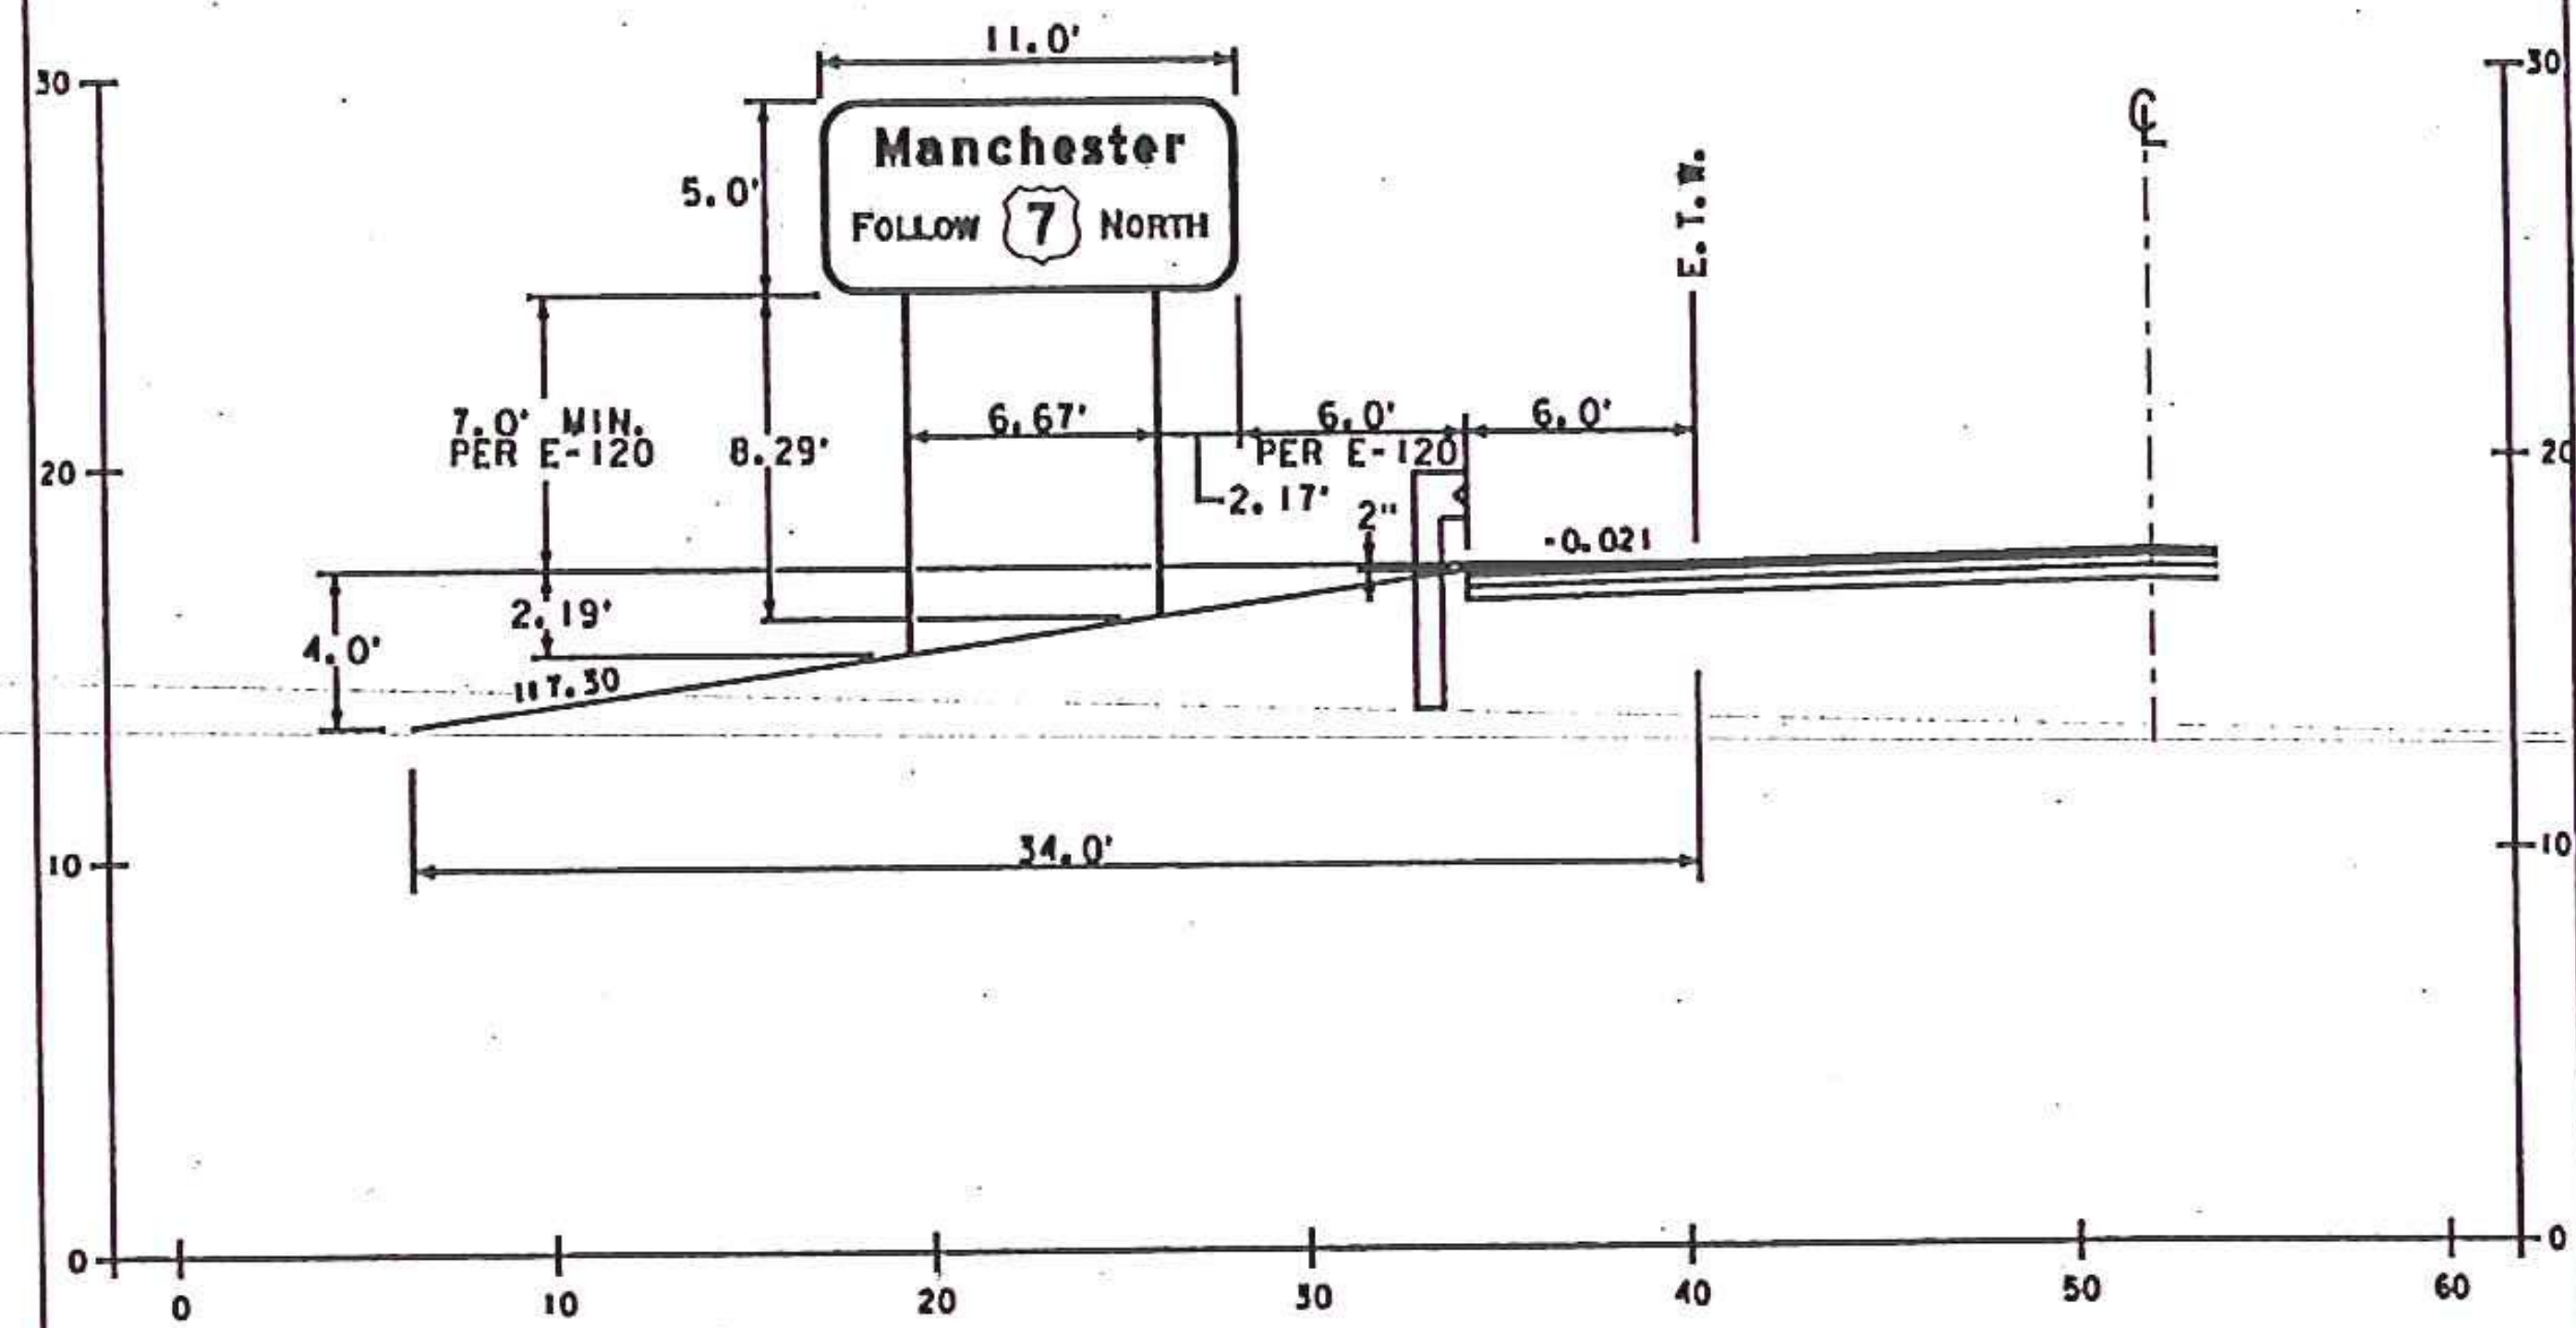

SELECTED W6X9 POSTS

WIDTH x HEIGHT = AREA
 A = 11.0 x 5.0 = 55.00 SF

OVERALL LENGTH x Lbs/FT = Lbs.
~~(5' + 8.29' + 5' + 7' + 2.19') x 9 = 247.32 Lbs. = 112.2 Kg~~
 14.75' + 13.75' = 28.5' x 9 = 256.5 lbs = 116 kg

2' FOOTING SIZE (SEE VTrans STD. E-161)
 600mm