

VT ROUTE 9 EASTBOUND

TEMPORARY 100 WHITE LINE & DURABLE 100 WHITE LINE, THERMOPLASTIC
 STA. VT 1+200.5 TO VT 1+370.0, DOUBLE SOLID LT. & RT.
 STA. VT 1+315.0 TO VT 1+350.0, DOTTED RT.
 STA. VT 1+350.0 TO VT 1+370.0, SOLID RT. (LANE LINE)

TEMPORARY 100 YELLOW LINE & DURABLE 100 YELLOW LINE, THERMOPLASTIC
 STA. VT 1+200.5 TO VT 1+275.0, DOUBLE SOLID, & TO LT.
 STA. VT 1+275.0 TO VT 1+350.0, DOUBLE SOLID, & TO RT.
 STA. VT 1+350.0 TO VT 1+370.0, DOUBLE SOLID, LT.

TEMPORARY 200 YELLOW LINE & DURABLE 200 YELLOW LINE, THERMOPLASTIC
 STA. VT 1+275.0 TO VT 1+350.0, DIAGONALS






TEMPORARY LETTER OR SYMBOL
 STA. VT 1+363.2, RT. - - - - -
 STA. VT 1+362.9, RT. - - - - -

DURABLE LETTER OR SYMBOL, THERMOPLASTIC
 STA. VT 1+265.9, RT. - - - - -
 STA. VT 1+278.0, RT. - - - - -
 STA. VT 1+363.2, RT. - - - - -
 STA. VT 1+362.9, RT. - - - - -
 STA. VT 1+351.2, RT. - - - - -



REMOVING SIGNS AS SHOWN-3
 ERECTING SALVAGED SIGNS AS SHOWN-1

DURABLE CROSSWALK MARKING, THERMOPLASTIC
 STA. VT 1+245.0.

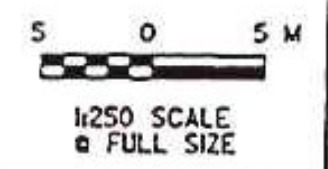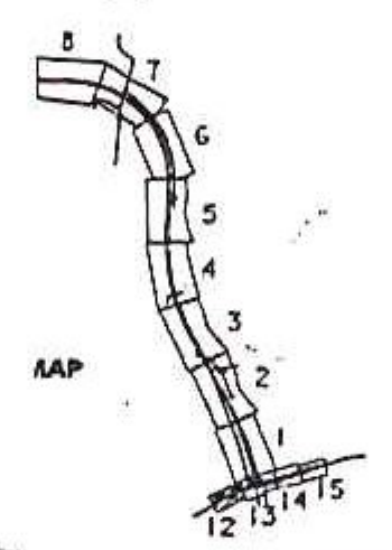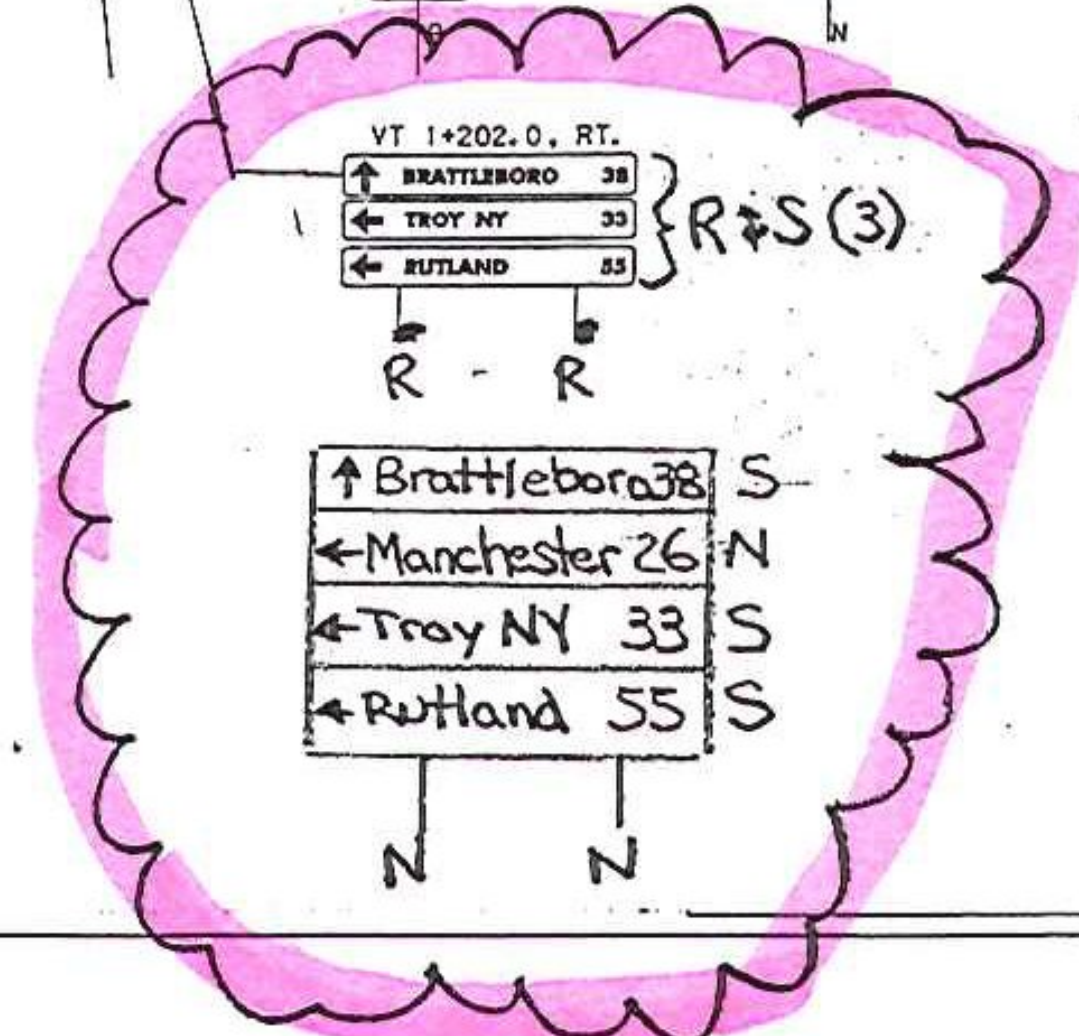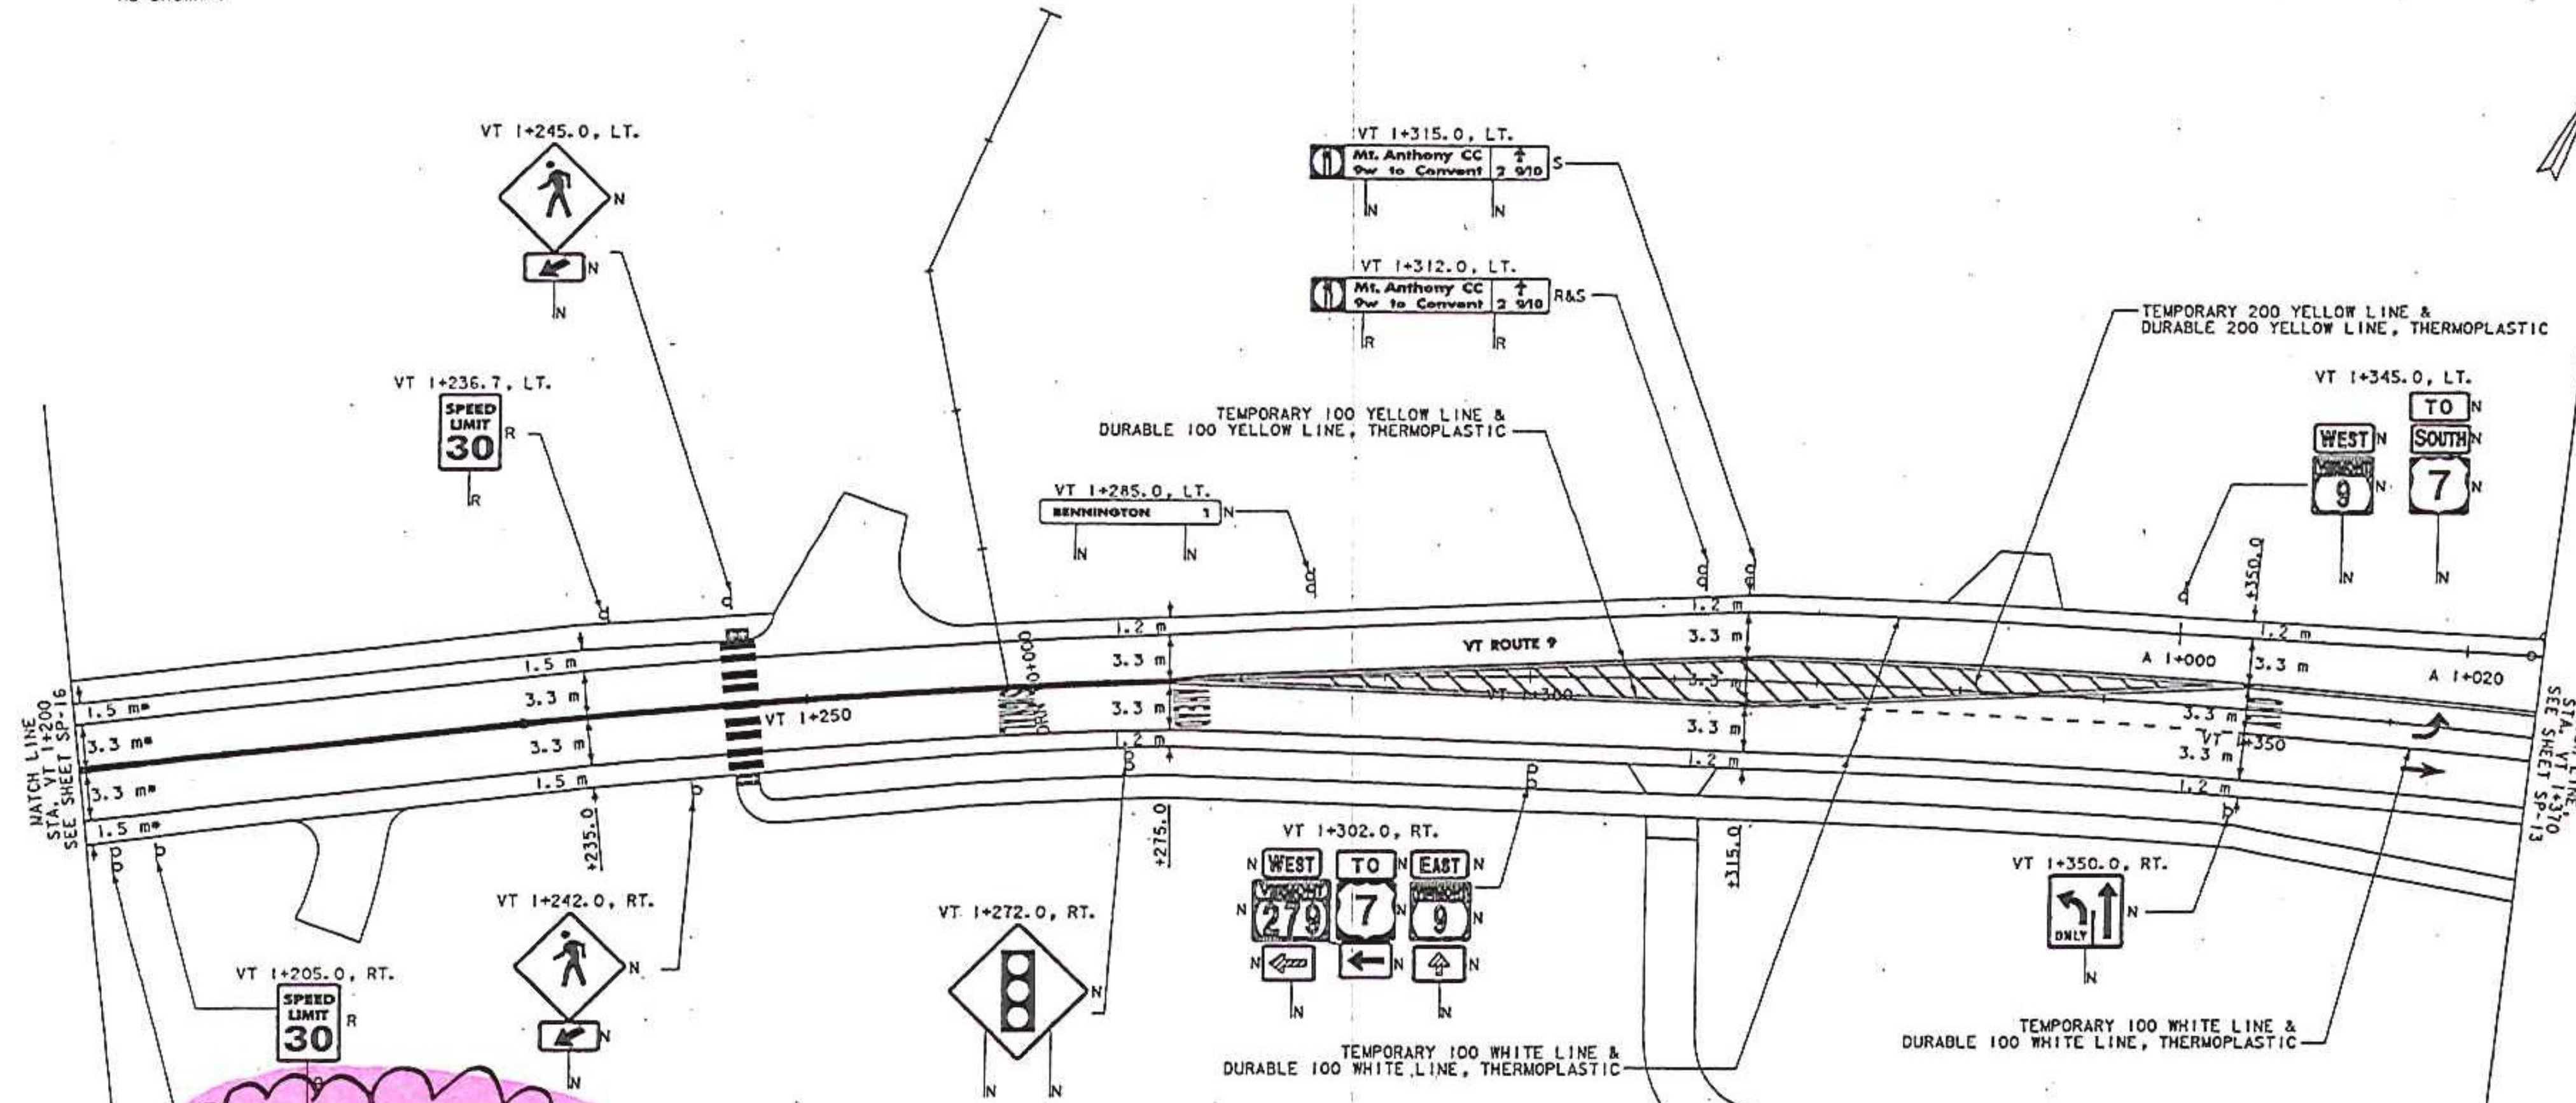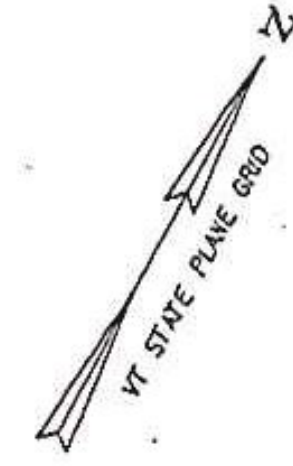

- NOTES:
 1) FOR ANY TOWN HIGHWAY OR STREET DETAILS, SEE VTTRANS STANDARD E-193
 2) FOR FURTHER DETAILS ON LIGHTING, SEE LIGHTING PLAN SHEET LP-05
 3) ALL DIMENSIONS, NOTES, AND CALLOUTS ARE IN MILLIMETERS (mm) EXCEPT WHERE NOTED

VERMONT AGENCY OF TRANSPORTATION

PROJECT NAME: BENNINGTON
 PROJECT NUMBER: AC NH 019-(5)
 FILE NAME: \plot files\2d\307chxt_sgn.plt PLOT DATE: 1/30/2009
 DESIGN SUPERVISOR: GREG EDWARDS DRAWN BY: STANTEC
 DESIGNED BY: MARC FOISY CHECKED BY: GARY SANTY
 SIGNS AND MARKINGS SP-12 SHEET 120 OF 367

RECORD PLANS