

# VT ROUTE 9 WESTBOUND

**TEMPORARY 100 WHITE LINE & DURABLE 100 WHITE LINE, THERMOPLASTIC**  
 STA. VT 1+560.0 TO VT 1+700.0, SOLID LT. & RT. (WITH EDGE LINE BREAKS FOR HARVARD ST. & HICKORY HILL ROAD)  
 STA. VT 1+569.5 TO VT 1+646.8, SOLID RT. (LANE LINE)  
 VT 1+573.1 - VT 1+648.8, SOLID RT.  
 VT 1+655.5 - VT 1+700.0, SOLID RT.

**TEMPORARY 600 STOP BAR & DURABLE 600 STOP BAR, THERMOPLASTIC**  
 STA. VT 1+563.5, RT. (HARVARD ST.)  
 STA. VT 1+651.5, RT. (HICKORY HILL ROAD)

**TEMPORARY 100 YELLOW LINE & DURABLE 100 YELLOW LINE, THERMOPLASTIC**  
 STA. VT 1+570.0 TO VT 1+600.0, DOUBLE SOLID, LT. & RT.  
 STA. VT 1+600.0 TO VT 1+644.5, DOUBLE SOLID, C  
 STA. VT 1+656.5 TO VT 1+700.0, DOUBLE SOLID, C  
 STA. VT 1+563.5, RT. (HARVARD STREET)  
 STA. VT 1+651.5, RT. (HICKORY HILL ROAD)



**DURABLE CROSSWALK MARKING, THERMOPLASTIC**  
 STA. VT 1+563.5, RT. (HARVARD ST.)  
 SEE SP-12 FOR DETAIL

**TEMPORARY 200 YELLOW LINE & DURABLE 200 YELLOW LINE, THERMOPLASTIC**  
 STA. VT 1+570.0 TO VT 1+590.0, DIAGONALS

**TEMPORARY LETTER OR SYMBOL**  
 STA. VT 1+565.8, RT. - " STOP " (HARVARD ST.)  
 STA. VT 1+578.4, RT. - " ONLY " (HARVARD ST.)  
 STA. VT 1+590.4, RT. - " ONLY " (HICKORY HILL ROAD)  
 STA. VT 1+614.0, RT. - " ONLY " (HICKORY HILL ROAD)  
 STA. VT 1+637.5, RT. - " ONLY " (HICKORY HILL ROAD)

**DURABLE LETTER OR SYMBOL, THERMOPLASTIC**  
 STA. VT 1+565.8, RT. - " STOP " (HARVARD STREET)  
 STA. VT 1+578.4, RT. - " ONLY " (HARVARD STREET)  
 STA. VT 1+590.4, RT. - " ONLY " (HICKORY HILL ROAD)  
 STA. VT 1+614.0, RT. - " ONLY " (HICKORY HILL ROAD)  
 STA. VT 1+625.5, RT. - " ONLY " (HICKORY HILL ROAD)  
 STA. VT 1+637.5, RT. - " ONLY " (HICKORY HILL ROAD)  
 STA. VT 1+653.4, RT. - " STOP " (HICKORY HILL ROAD)

**REMOVING SIGNS AS SHOWN-9**  
**ERECTING SALVAGED SIGNS AS SHOWN-3**

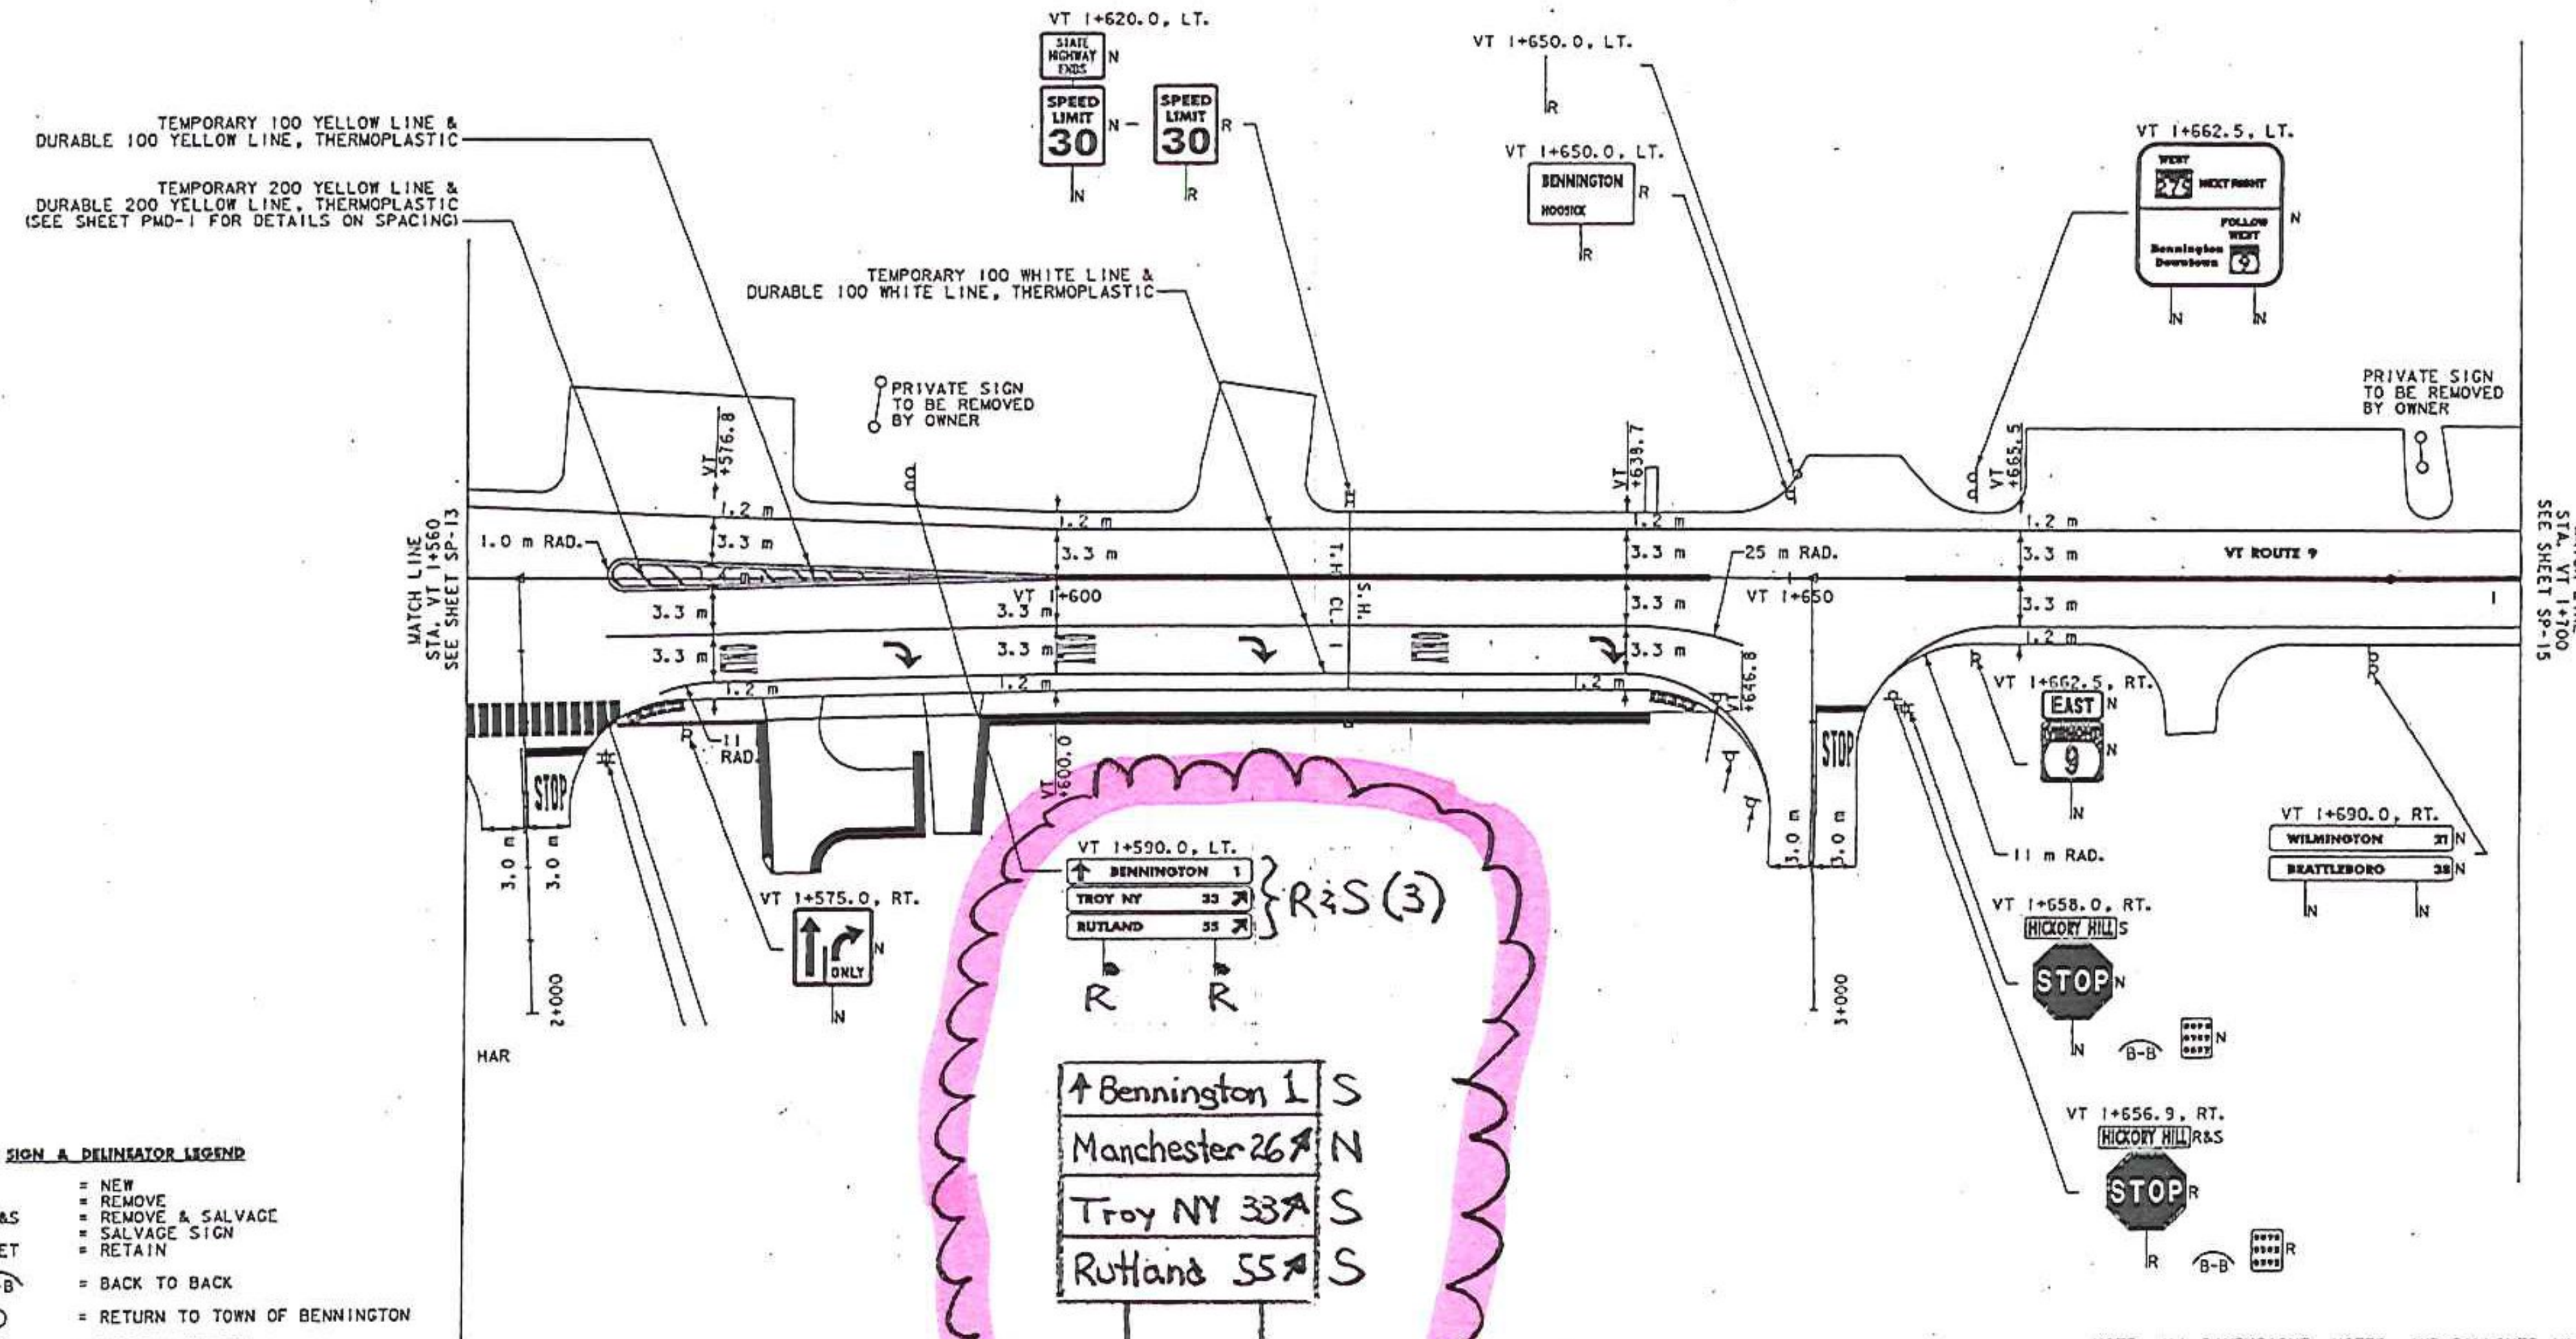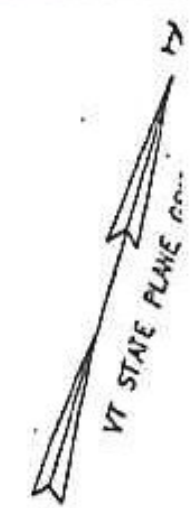

- SIGN & DELINEATOR LEGEND**
- = NEW
  - = REMOVE & SALVAGE
  - = REMOVE & SALVAGE
  - = SALVAGE SIGN
  - = RETAIN
  - B-B = BACK TO BACK
  - ⊙ = RETURN TO TOWN OF BENNINGTON
  - ↑ = TYPE I (WHITE)
  - ↑ = TYPE I (AMBER)
  - ↑ = TYPE I (WHITE W/REF PLAQUE)
  - ↑ = TYPE II
  - ↑ = TYPE III (WHITE)
  - ↑ = TYPE III (AMBER)
  - = MATCH EXISTING CONDITIONS

**RECORD PLANS**

NOTE: ALL DIMENSIONS, NOTES, AND CALLOUTS IN MILLIMETERS (mm) EXCEPT AS NOTED

**VERMONT AGENCY OF TRANSPORTATION**

PROJECT NAME: BENNINGTON  
 PROJECT NUMBER: AC NH 019-K51

FILE NAME: \\plot files\2d307dtxf\_09n011  
 DESIGN SUPERVISOR: GREG EDWARDS  
 DESIGNED BY: MARC FOIST  
 SIGNS AND MARKINGS SP-14

PLOT DATE: 1/30/2009  
 DRAWN BY: STANTEC  
 CHECKED BY: GARY SANTY  
 SHEET 123 OF 367

14