


DURABLE 150 WHITE LINE, THERMOPLASTIC  
 STA. NB 6+740.0 TO 7+100.0, SOLID LT. & RT.  
 STA. NB 6+740.0 TO 7+100.0, DASHED RT.



DURABLE 150 YELLOW LINE, THERMOPLASTIC  
 STA. NB 6+740.0 TO 7+100.0, DOUBLE SOLID C

DELINEATORS W/STIFF POSTS  
 AS SHOWN-4 (FOR DETAILS, SEE VTTRANS STD. E-197)

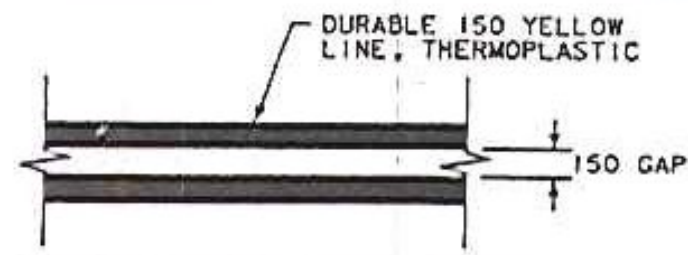



150 DOUBLE SOLID LINES (YELLOW)  
 DETAIL

LOCATION	TYPE
STA. NB 6+740.0 TO NB 6+762.0, LT.	SHOULDER
STA. NB 6+740.0 TO NB 7+100.0, RT.	SHOULDER
STA. NB 6+740.0 TO NB 7+100.0, C	CENTERLINE
STA. NB 6+855.4 TO NB 7+100.0, LT.	SHOULDER

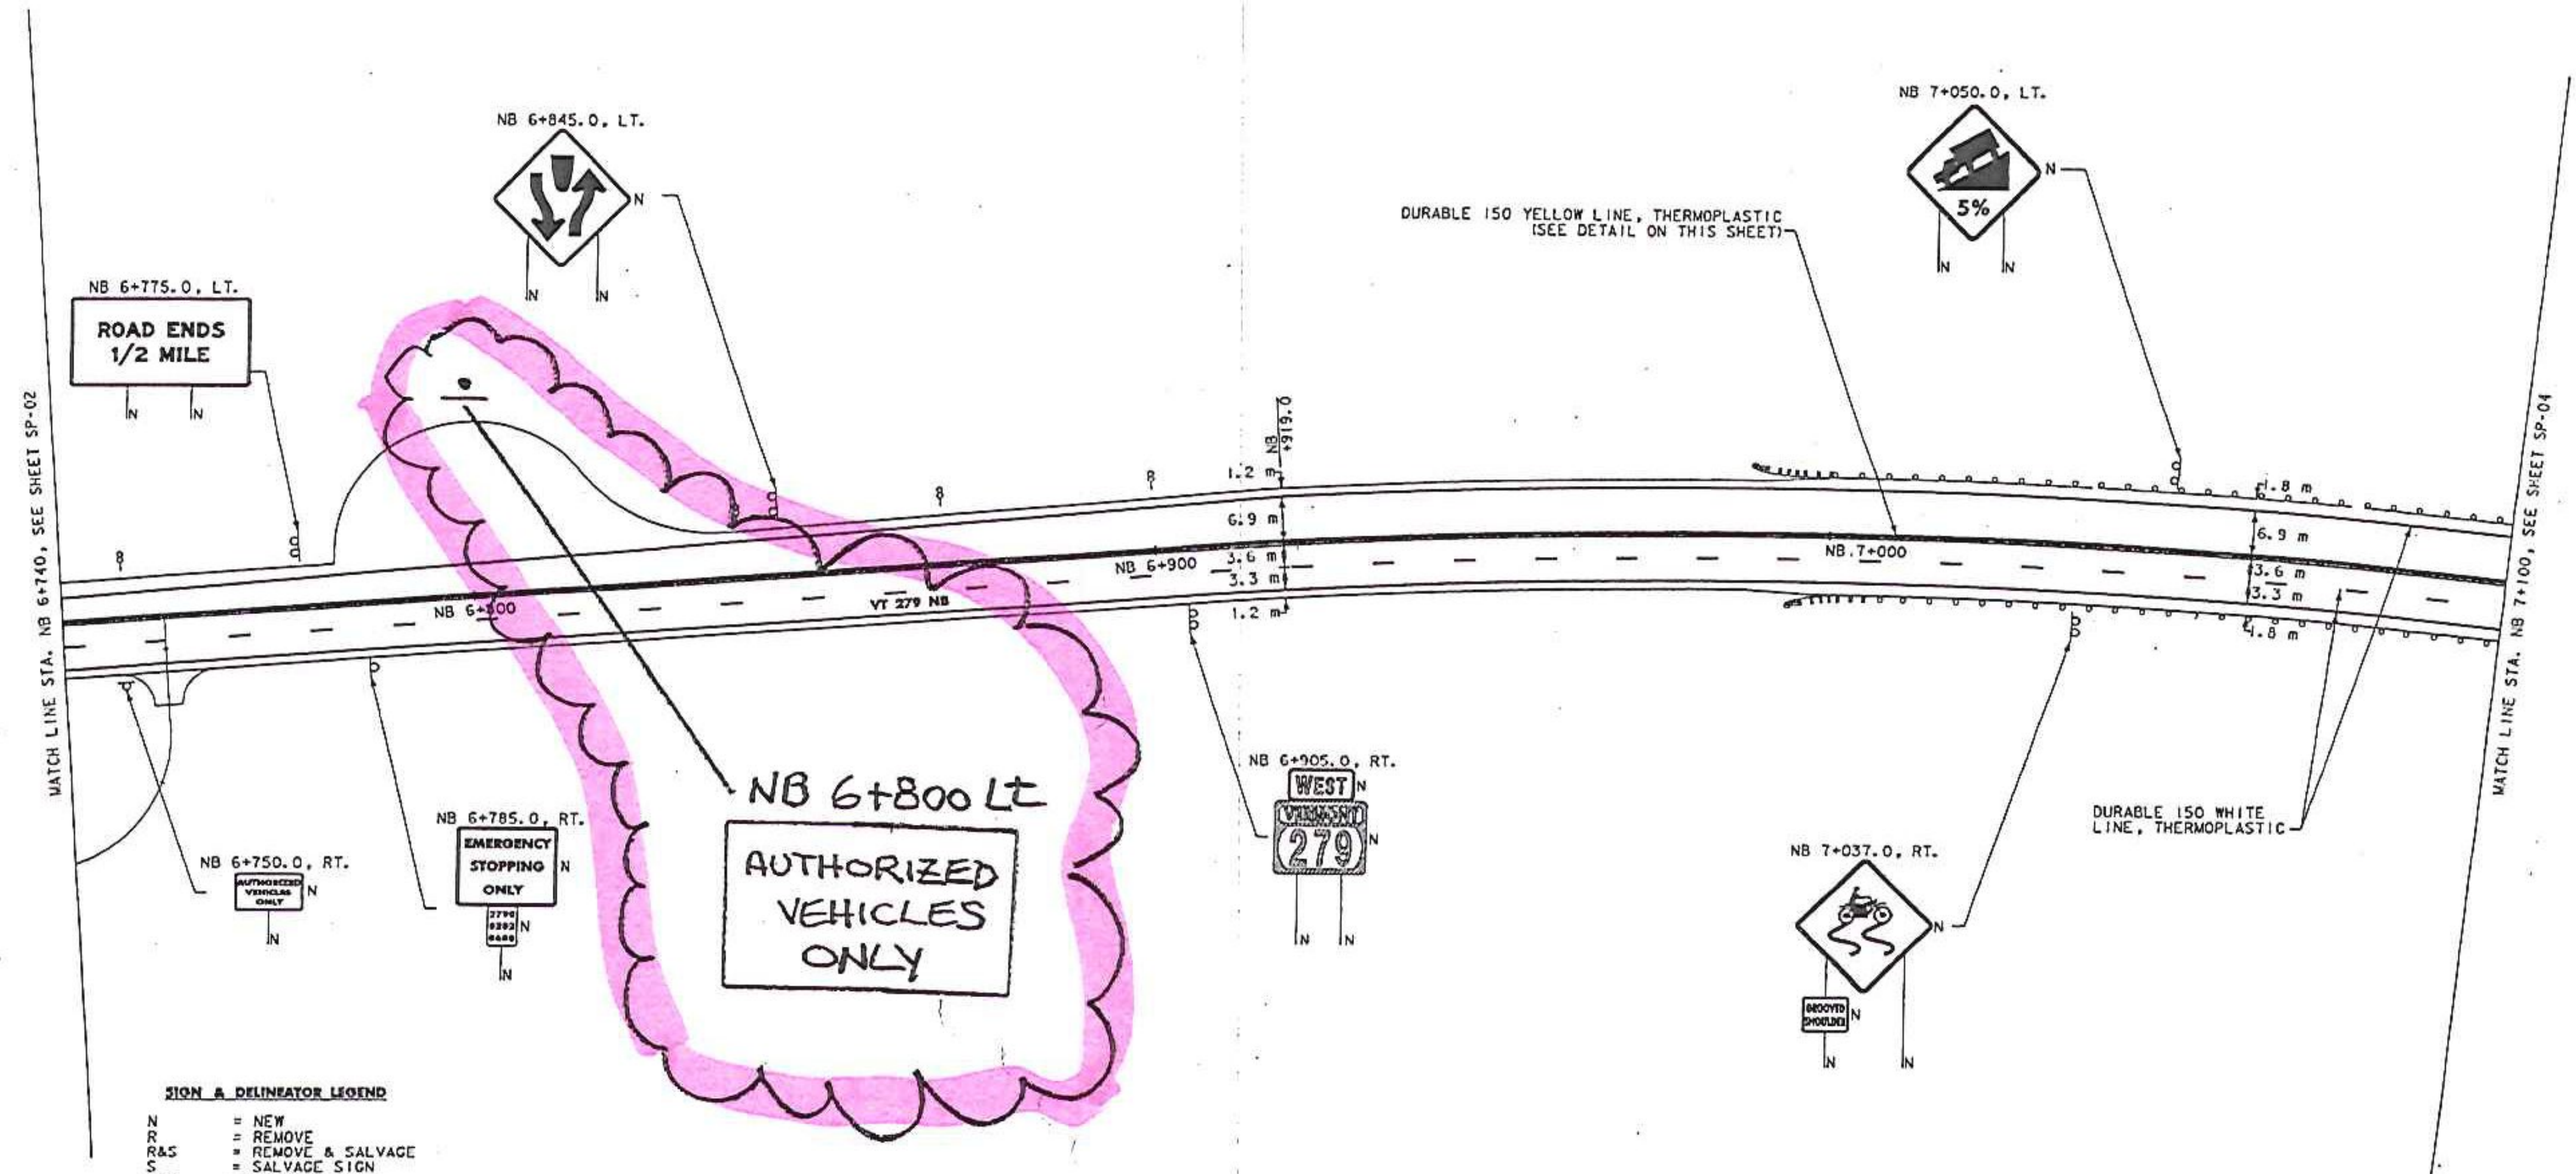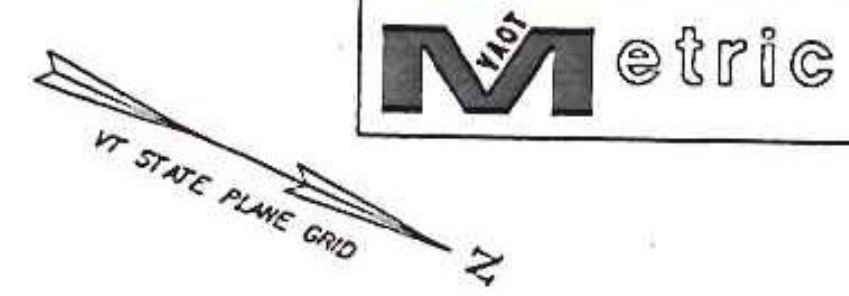

**SIGN & DELINEATOR LEGEND**

N	= NEW
R	= REMOVE
R&S	= REMOVE & SALVAGE
S	= SALVAGE SIGN
RET	= RETAIN
B-B	= BACK TO BACK
⊙	= RETURN TO TOWN OF BENNINGTON
↑	= TYPE I (WHITE)
↑	= TYPE I (AMBER)
⊙	= TYPE I (WHITE W/REF PLAQUE)
↑	= TYPE II
↑	= TYPE III (WHITE)
↑	= TYPE III (AMBER)
⋄	= MATCH EXISTING CONDITIONS

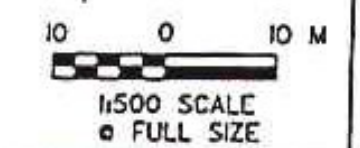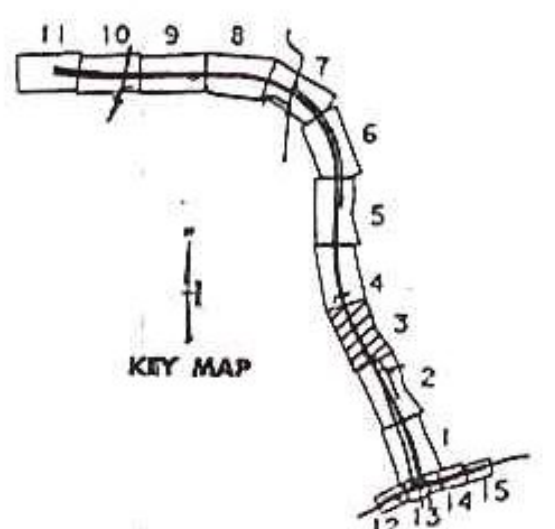

NOTE: ALL DIMENSIONS, NOTES, AND CALLOUTS ARE IN MILLIMETERS (mm) EXCEPT WHERE NOTED

**VERMONT AGENCY OF TRANSPORTATION**

PROJECT NAME: BENNINGTON  
 PROJECT NUMBER: AC NH 019-1(51)

FILE NAME: ...plot files\zd307atxt\_sgn.plt PLOT DATE: 1/30/2009  
 DESIGN SUPERVISOR: GREG EDWARDS DRAWN BY: STANTEC  
 DESIGNED BY: MARC FOISY CHECKED BY: GARY SANTY  
 SIGNS AND MARKINGS SP-03 SHEET # OF 367

RECORD PLANS 16