

DURABLE 150 WHITE LINE, THERMOPLASTIC
 STA. NB 8+840.0 TO 9+200.0, SOLID RT.
 STA. NB 8+840.0 TO 9+200.0, DASHED RT.
 STA. NB 8+840.0 TO NB 9+106.3, DASHED LT.
 STA. NB 8+840.0 TO NB 9+106.3, SOLID LT.
 STA. XO 1+340.0 TO 1+430.5, SOLID RT.
 STA. XO 1+340.0 TO 1+430.5, DASHED RT.


DURABLE 150 YELLOW LINE, THERMOPLASTIC
 STA. NB 8+840.0 TO 8+958.0, DOUBLE SOLID ☐
 STA. NB 9+106.3 TO 9+200.0, SOLID ☐
 STA. NB 8+958.0 TO 9+106.3, DOUBLE SOLID ☐
 STA. NB 8+958.0 TO 9+106.3, DOUBLE SOLID LT.
 STA. XO 1+340.0 TO 1+430.5, SOLID ☐

DURABLE 300 YELLOW LINE, THERMOPLASTIC
 STA. NB 8+958.0 TO 9+106.3, DIAGONALS

MILLED RUMBLE STRIPS
 STA. NB 8+840.0 TO 8+872.0, LT.
 STA. NB 8+840.0 TO 9+200.0, RT.
 STA. NB 8+840.0 TO 9+106.3, ☐
 STA. NB 9+106.3 TO 9+200.0, LT.
 STA. XO 1+340.0 TO 1+573.6, RT.
 STA. XO 1+340.0 TO 1+430.5, LT.
 STA. XO 1+430.5 TO 1+506.5, ☐


FLASHING BEACON - GROUND MOUNTED
 STA. NB 9+130.0, RT. (2)
 FOR FURTHER DETAILS ON LIGHTING, SEE LIGHTING PLAN SHEET LP-03

DELINEATORS W/STEEL POSTS
 AS SHOWN-10 (FOR DETAILS, SEE VTRANS STD. E-197)

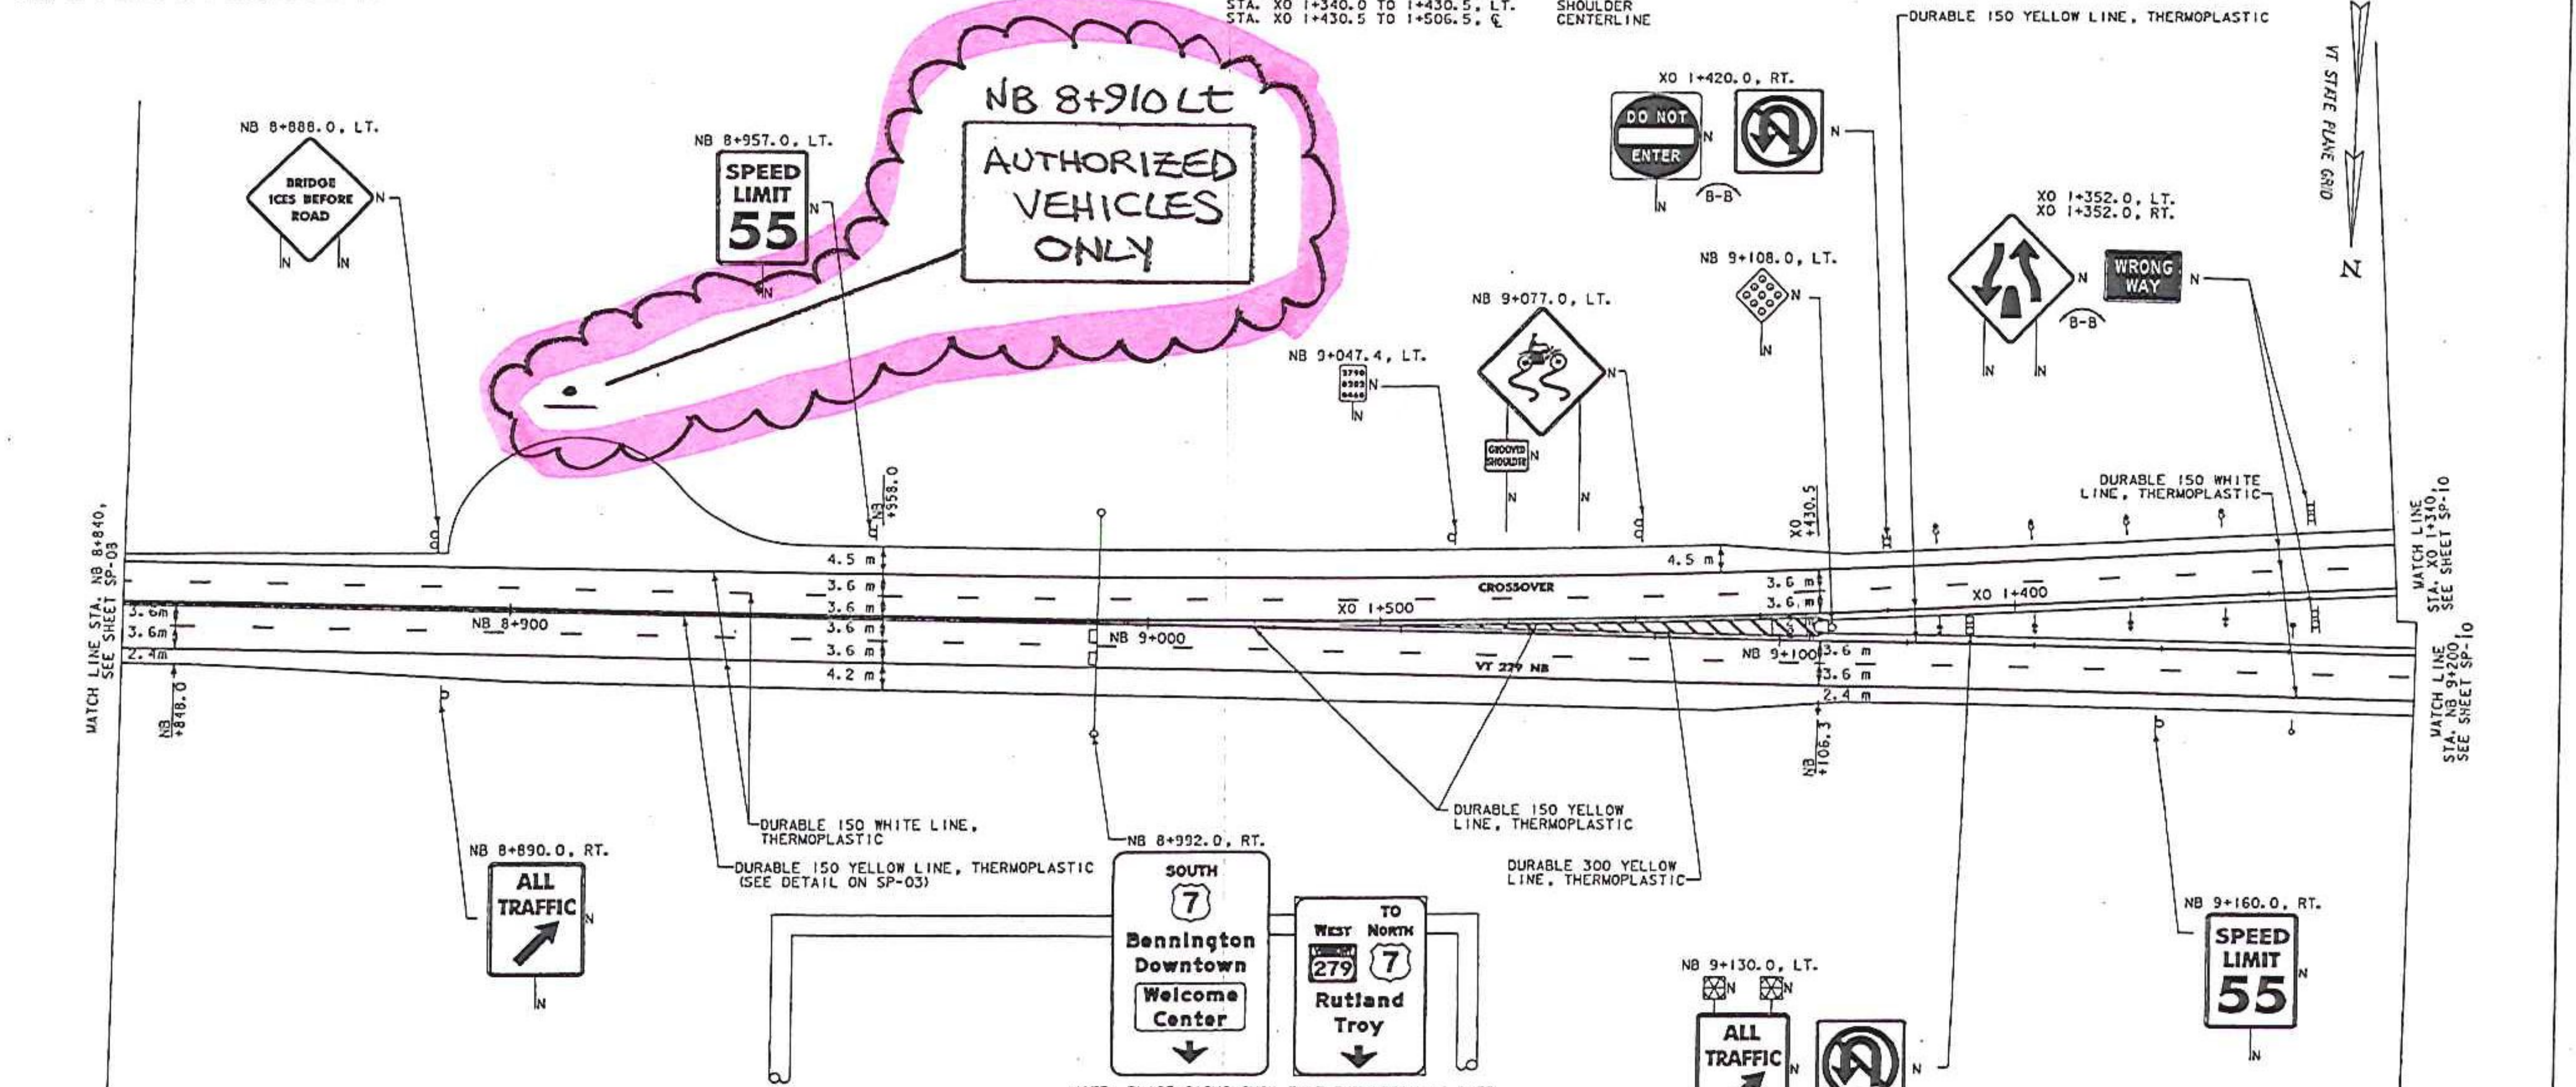


- SIGN & DELINEATOR LEGEND**
- N = NEW
 - R = REMOVE
 - R&S = REMOVE & SALVAGE
 - S = SALVAGE SIGN
 - RET = RETAIN
 - (B-B) = BACK TO BACK
 - (O) = RETURN TO TOWN OF BENNINGTON
 - ↑ = TYPE I (WHITE)
 - ↑ = TYPE I (AMBER)
 - ↑ = TYPE I (WHITE W/REF PLAQUE)
 - ↑ = TYPE II
 - ↑ = TYPE III (WHITE)
 - ↑ = TYPE III (AMBER)
 - = MATCH EXISTING CONDITIONS

NOTE: PLACE SIGNS SUCH THAT THE ARROW IS OVER THE CENTER OF THE LANE. BASED ON THE SIZE OF THE SIGNS, THERE WILL BE 175 BETWEEN THEM. SEE OSD-02 FOR OVERHEAD SUPPORT DETAILS.

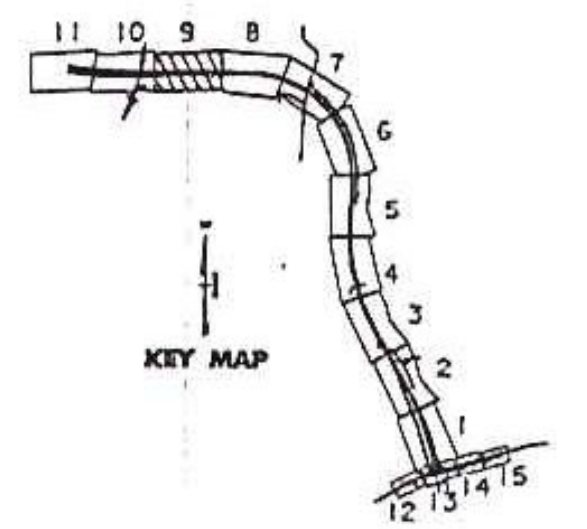

NOTE: 1) FOR STRIPING DETAILS AT THE GORES, SEE VTRANS STANDARDS E-191 & E-192

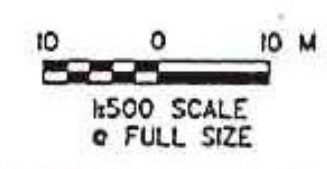

NOTES

1. REFER TO LP-03 FOR FLASHING BEACON CONDUIT AND POWER DETAILS.
2. ALL DIMENSIONS, NOTES, AND CALLOUTS ARE IN MILLIMETERS (mm) EXCEPT WHERE NOTED

VERMONT AGENCY OF TRANSPORTATION

	PROJECT NAME: BENNINGTON	FILE NAME: \\plot files\z307\trt\sign.ppt	PLOT DATE: 1/30/2009
	PROJECT NUMBER: AC NH 019-1(51)	DESIGN SUPERVISOR: GREG EDWARDS	DRAWN BY: STANTEC
	DESIGNED BY: MARC FOISY	CHECKED BY: GARY SANTY	
	SIGNS AND MARKINGS SP-09		SHEET 07 OF 367

RECORD PLANS 17

V:\2009\19\190000\190000.dwg