


# RECORD PLANS

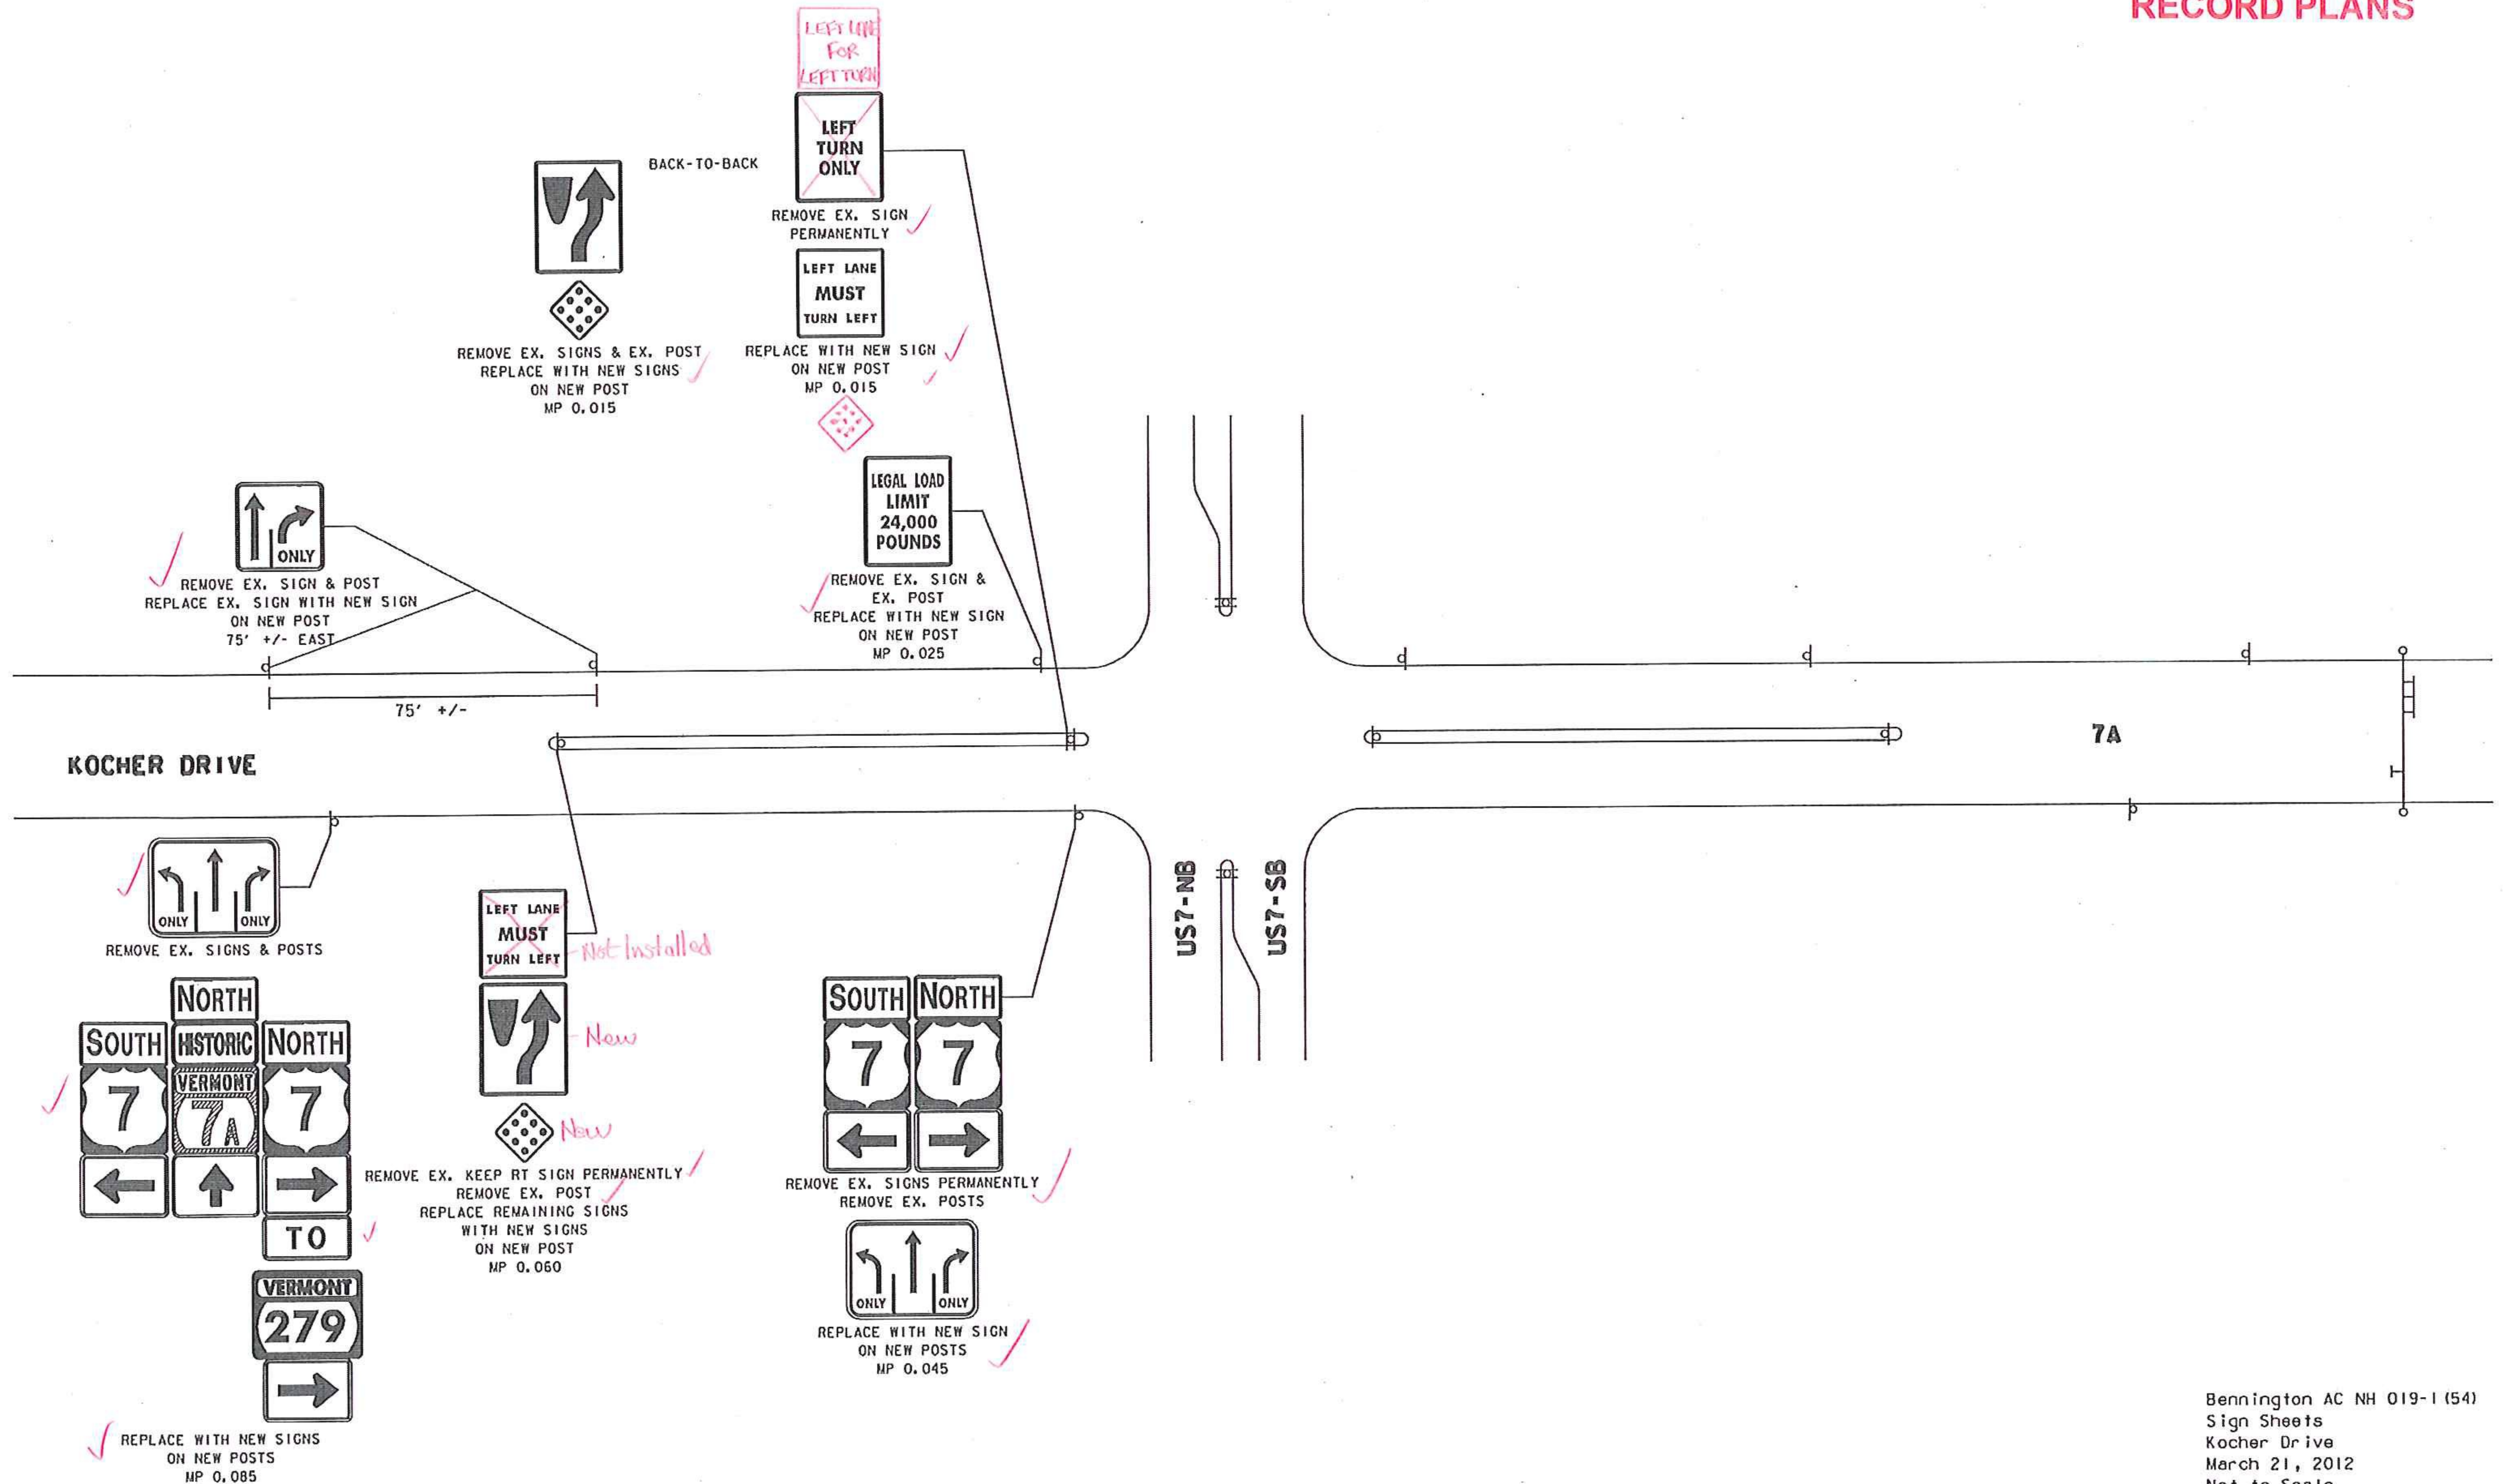

E:\2007\2007038.00\_Bennington Bypass\Bennington Bypass\Contract 54\Signs\Sign Summary\_03-21-12.dgn

• ALL MILES ARE REFERENCED TO THE ROUTE THE SIGN SERVES

Bennington AC NH 019-1 (54)  
 Sign Sheets  
 Kocher Drive  
 March 21, 2012  
 Not to Scale  
 Sheet 1 of 1