



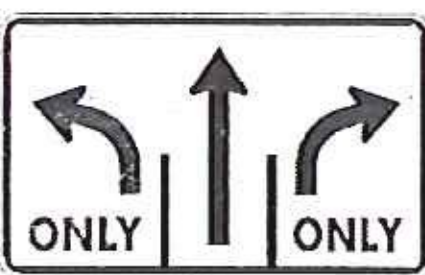


DIRECTION	MILEPOINT	LOCATION CODE (SHEET 2)	SIGN CODE	WIDTH (MM)	HEIGHT (MM)	SHEETING REMARKS	SIGN LEGEND	NEW SIGNS		EXISTING SIGNS			EXIST POST		NUMBER OF NEW POSTS	SQUARE STEEL (MM)			TUBULAR STEEL Ø (mm)				SIGN FRAME REQUIRED	RECORD PLANS REMARKS	SIGN DETAIL LOCATION			
								"A"	"B"	RETAIN	SALVAGE FROM	SALVAGE TO	REMOVE	RETAIN		REMOVE	44	50	63	75	89	100			125	SHSM	PROJECT SHEET #	STANDARD SHEET #
																	(KG / M)			(KG / M)								
BENNINGTON KOCHER DR							FY-FLUORESCENT YELLOW FYG-FLUORESCENT YELLOW GREEN																"SHSM"-STANDARD HIGHWAY SIGNS AND MARKINGS					
	WB 0.060 Lt	K	R3-7L	600	750		Change			0.45						9-19-12								-STRAIGHTEN POST	X			
		K	OM1-1	450	450					0.20				1		9-19-12	4.1	X						X				
WB 0.045		F	M3-3	600	300	SOUTH							1															
		F	M1-4	600	600	US 7							1															
		F	M6-1	525	375	LEFT ARROW							1															
		F	M3-1	600	300	NORTH							1															
		F	M1-4	600	600	US 7							1															
		F	M6-1	525	375	RIGHT ARROW							1															
		F	VR-932	1200	750				9-27-12	0.90				2		9-27-12	7.1	X								E-145A		
SIGN SUMMARY SHEET							SHEET TOTALS		1.55	0.00	0	0	0	6	0	1	3	13.8	0	0.0	0.0	0.0	0.0	PROJECT NAME: Bennington PROJECT NUMBER: NH 019-1(54)				
							SM	SM	EA	EA	EA	EA	EA	EA	EA	EA	M	EA	KG	KG	KG	KG	FILE NAME: Bennington Kocher Dr.xls PLOT DATE: 3/7/2012 PROJECT MANAGER: 0 DRAWN BY: T. Guazzoni DESIGNED BY: T. Guazzoni CHECKED: 0 BENNINGTON KOCHER DR SHEET 3 SHEET 3 OF 3					
VERMONT AGENCY OF TRANSPORTATION							TOWN DIRECTIONAL TOTALS		7.54	0.0	0	0	0	16	0	6	8	36.8	0	0.0	0.0	0.0						

Existing Removed
6 ea 11-14-12