


RECORD PLANS



EX. SIGNS & EX. POST PREVIOUSLY REMOVED
AS PART OF TEMPORARY CROSSOVER
REPLACE WITH NEW SIGN
ON NEW POST
MP 0.384

VT279 WB →

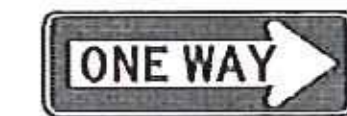

NEW SIGN ON NEW POST
MP 0.384

RAMP 1 →



REMOVE EX. SIGN & EX. POST
PERMANENTLY
MP 0.372



REMOVE EX. SIGN & EX. POSTS
REPLACE WITH NEW SIGN
ON NEW POSTS
MP 0.270

Bennington AC NH 019-1 (54)
Sign Sheets
Ramp 1
March 21, 2012
Not to Scale
Sheet 1 of 1

ALL MPs ARE REFERENCED TO THE ROUTE THE SIGN SERVES