


RECORD PLANS

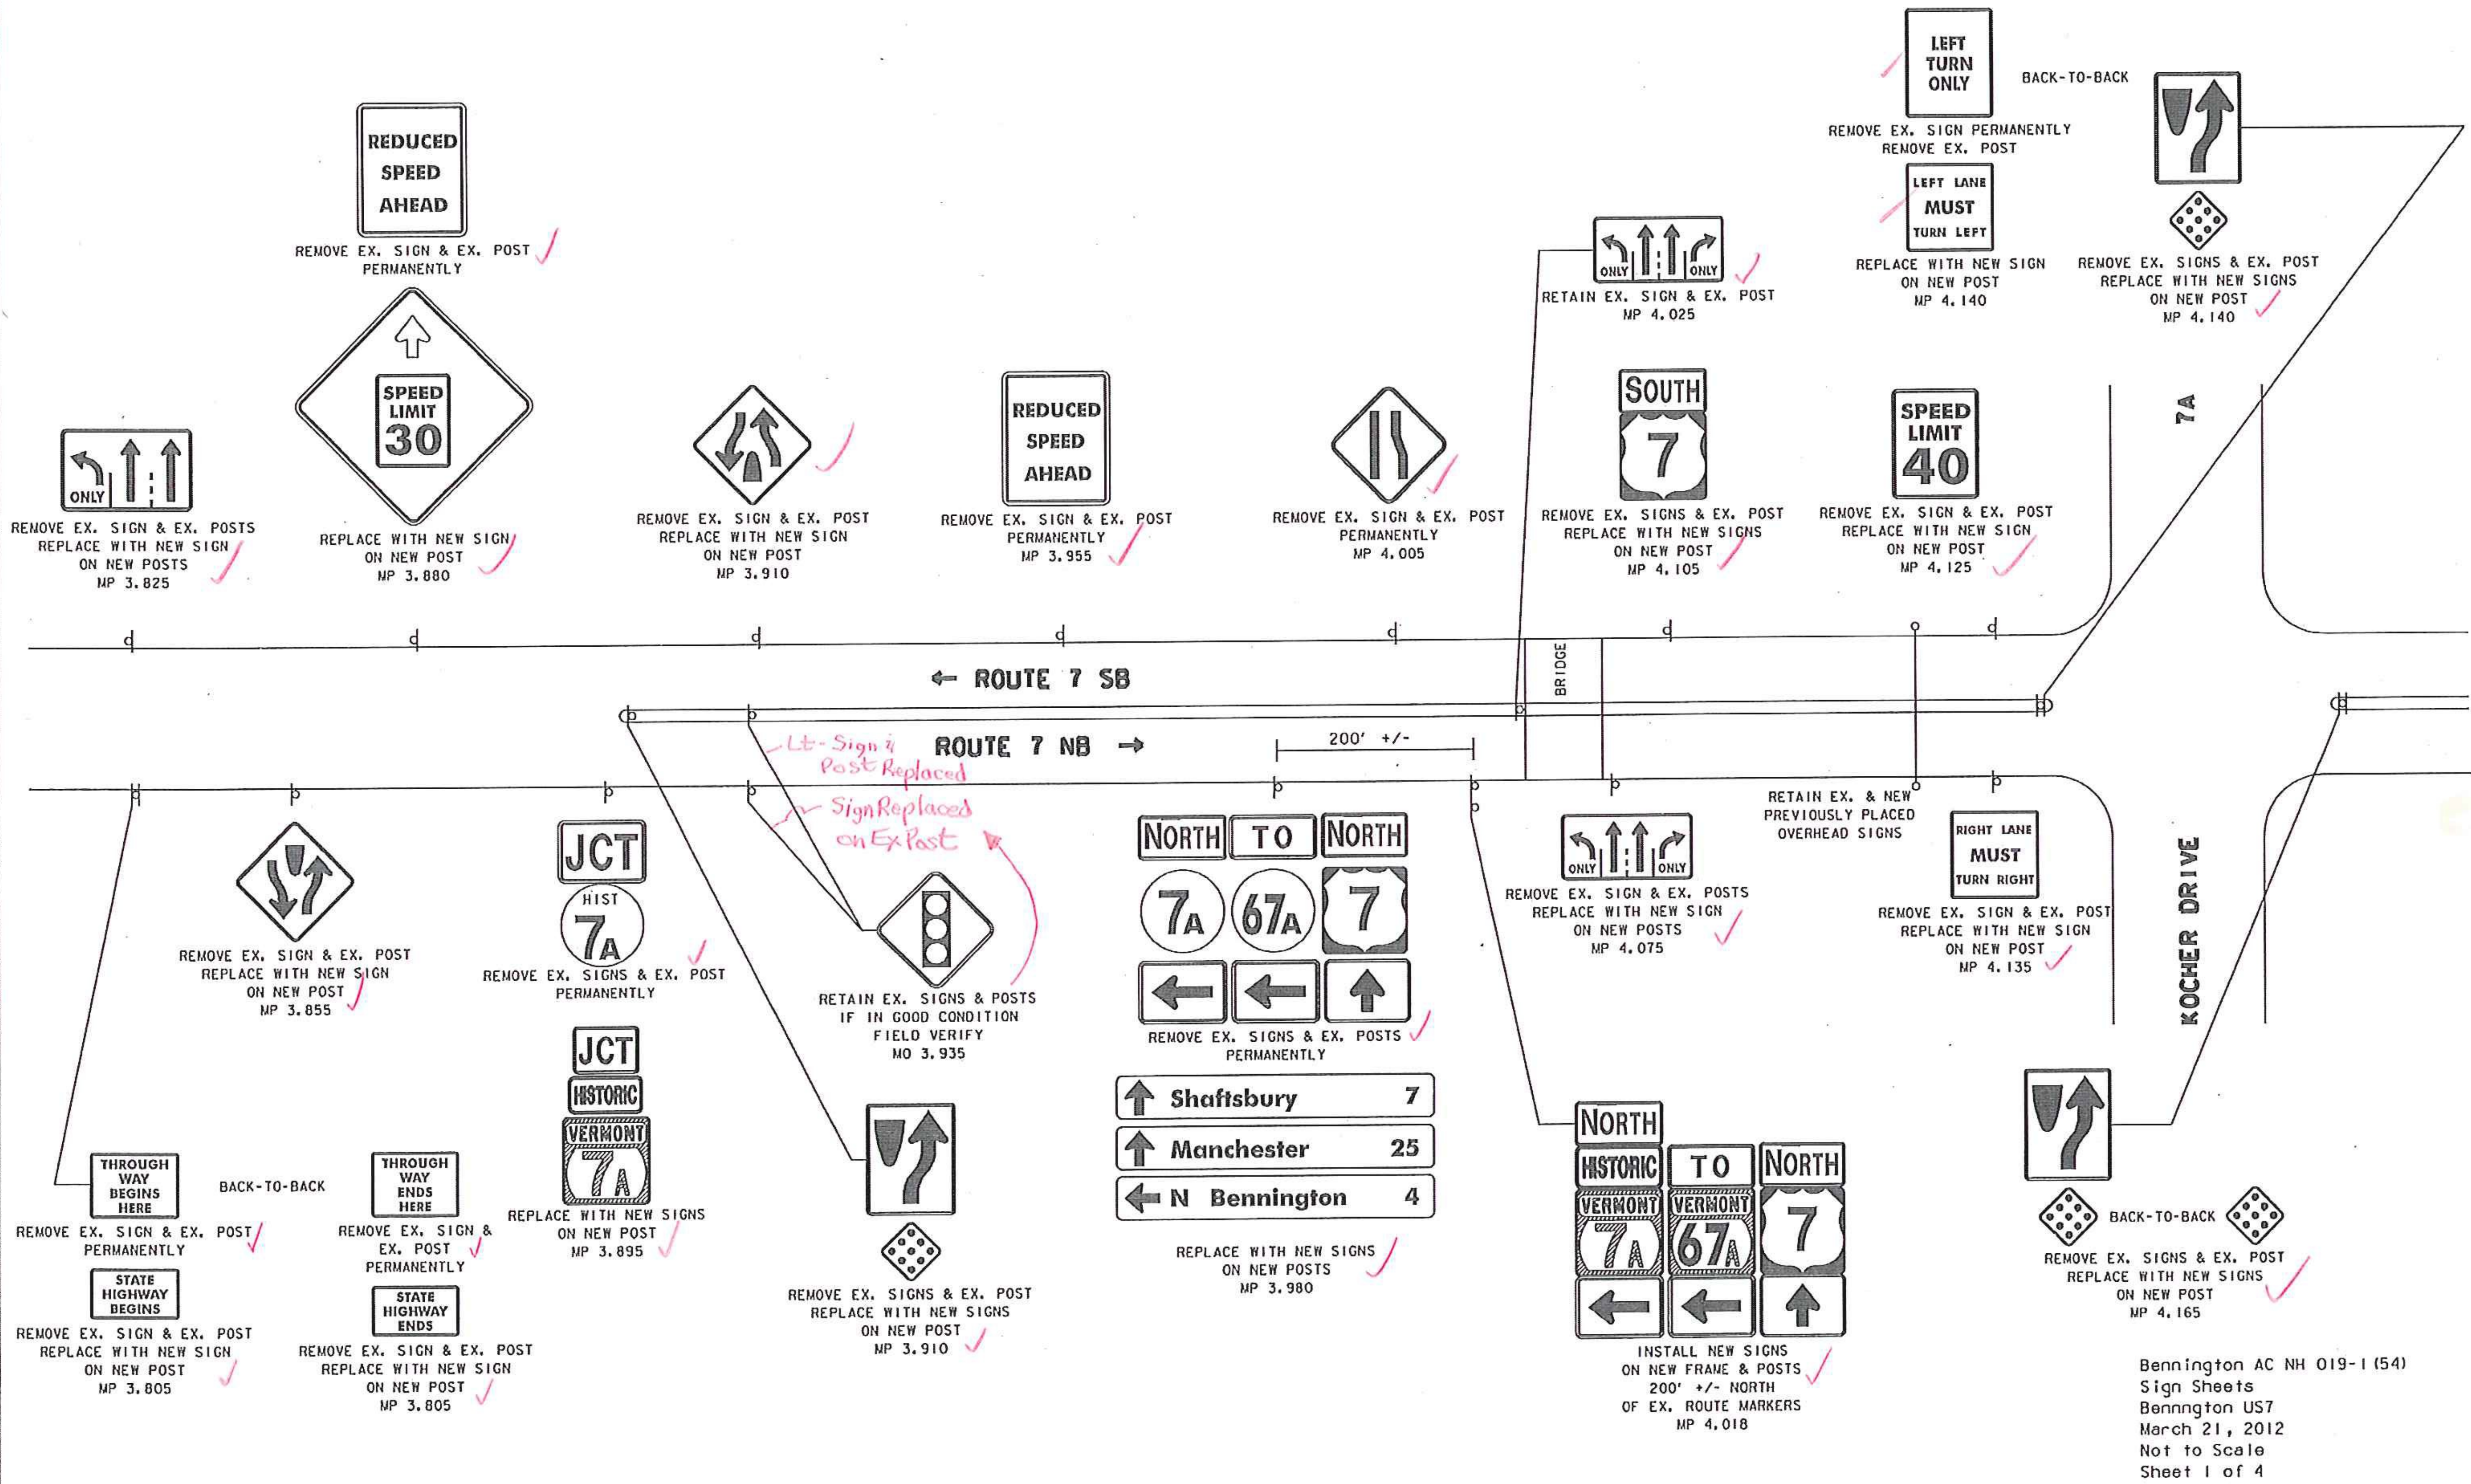

• ALL MPs ARE REFERENCED TO THE ROUTE THE SIGN SERVES

Bennington AC NH 019-1 (54)
 Sign Sheets
 Bennington US7
 March 21, 2012
 Not to Scale
 Sheet 1 of 4