

- Bennington
- Pownal 10
- N Bennington 4



REMOVE EX. SIGNS & EX. POSTS ✓




REPLACE WITH NEW SIGNS ON NEW POSTS ✓



REMOVE EX. SIGN & EX. POST REPLACE WITH NEW SIGN ON NEW POSTS ✓




INSTALL NEW SIGNS ON NEW POSTS MP 4.205 ✓

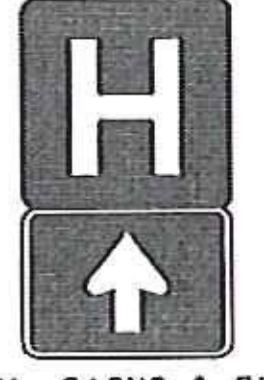


REMOVE EX. SIGNS & EX. POSTS PERMANENTLY MP 4.220 ✓




REMOVE EX. SIGNS & EX. POSTS PERMANENTLY MP 4.245 ✓

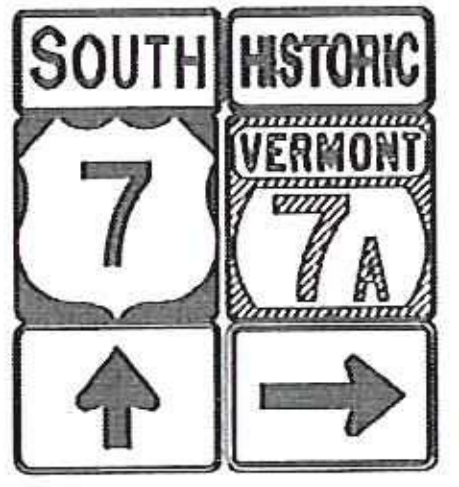

INSTALL NEW SIGNS ON NEW POSTS MP 4.243 ✓

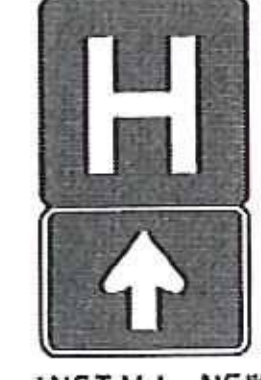


INSTALL NEW SIGNS ON NEW POSTS MP 4.281 ✓

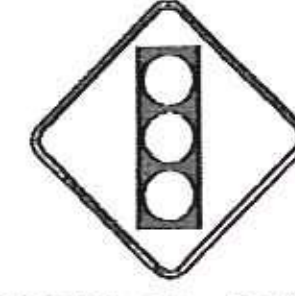


REMOVE EX. SIGNS REPLACE WITH NEW SIGNS ON EX. POST MP 4.320 ✓ *New*

← ROUTE 7 SB  
← ROUTE 7 SB

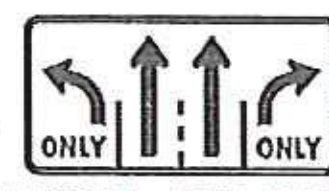

INSTALL NEW SIGNS ON NEW POSTS MP 4.205 ✓

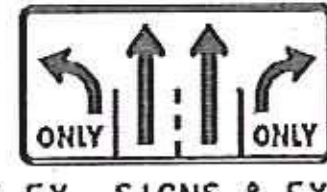

REMOVE EX. SIGNS & EX. POSTS MP 4.245 ✓



INSTALL NEW SIGN ON NEW POSTS MP 4.320 ✓



INSTALL NEW SIGN ON NEW POSTS MP 4.435 ✓

ROUTE 7 NB →  
ROUTE 7 NB →



REMOVE EX. SIGNS & EX. POST REPLACE WITH NEW SIGN ON NEW POST MP 4.170 ✓



REMOVE EX. SIGN & EX. POST ✓



REPLACE WITH NEW SIGNS ON NEW POSTS MP 4.185 ✓



TEMPORARY 45 SPEED LIMIT SIGN REMOVE EX. 45 SIGN AND EX. POST REPLACE WITH NEW 55 SPEED LIMIT SIGN ON NEW NEW POSTS MP 4.210 ✓



REMOVE EX. SIGN & EX. POST PERMANENTLY ✓



INSTALL NEW SIGNS ON NEW POSTS MP 4.325 ✓

RETAIN NEW OVERHEAD SIGNS

RAMP L

Bennington AC NH 019-1 (54)  
Sign Sheets  
Bennington US7  
March 21, 2012  
Not to Scale  
Sheet 2 of 4