
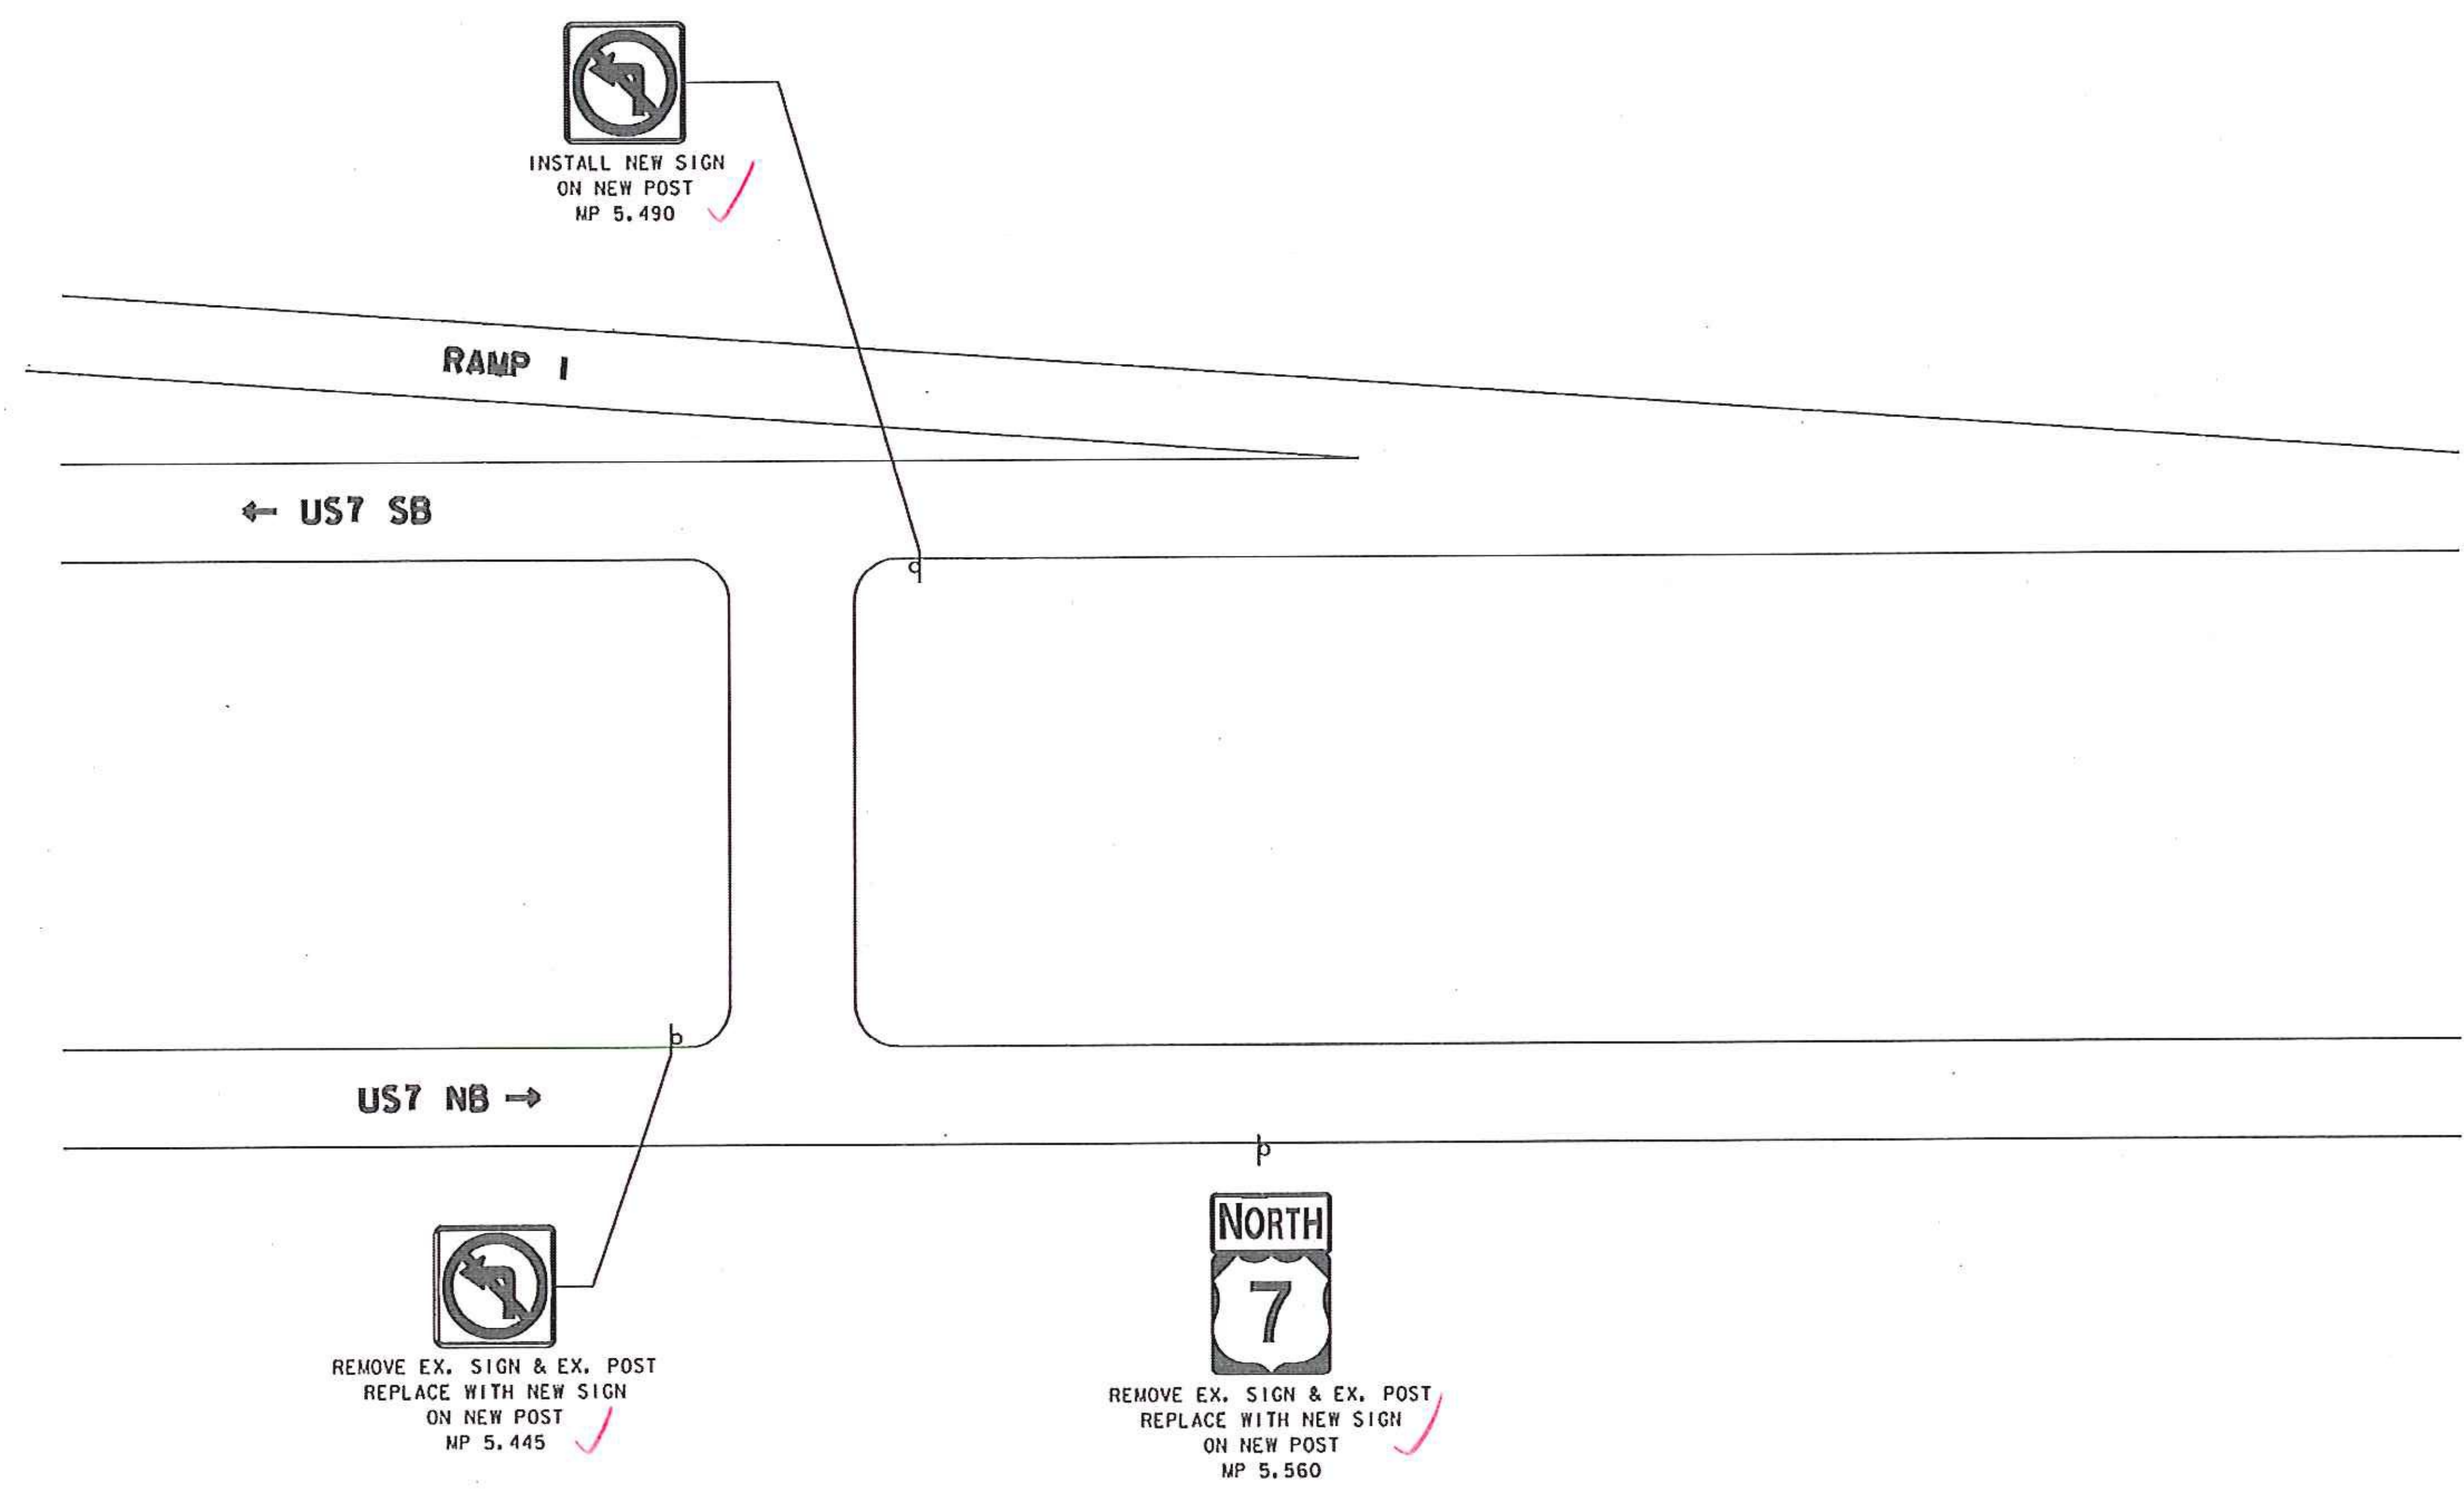


RECORD PLANS

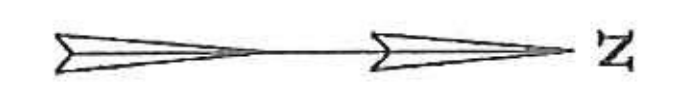

ALL MPs ARE REFERENCED TO THE ROUTE THE SIGN SERVES

Bennington AC NH 019-1 (54).
 Sign Sheets
 Bennington US7
 March 21, 2012
 Not to Scale
 Sheet 3 of 4