


RECORD PLANS

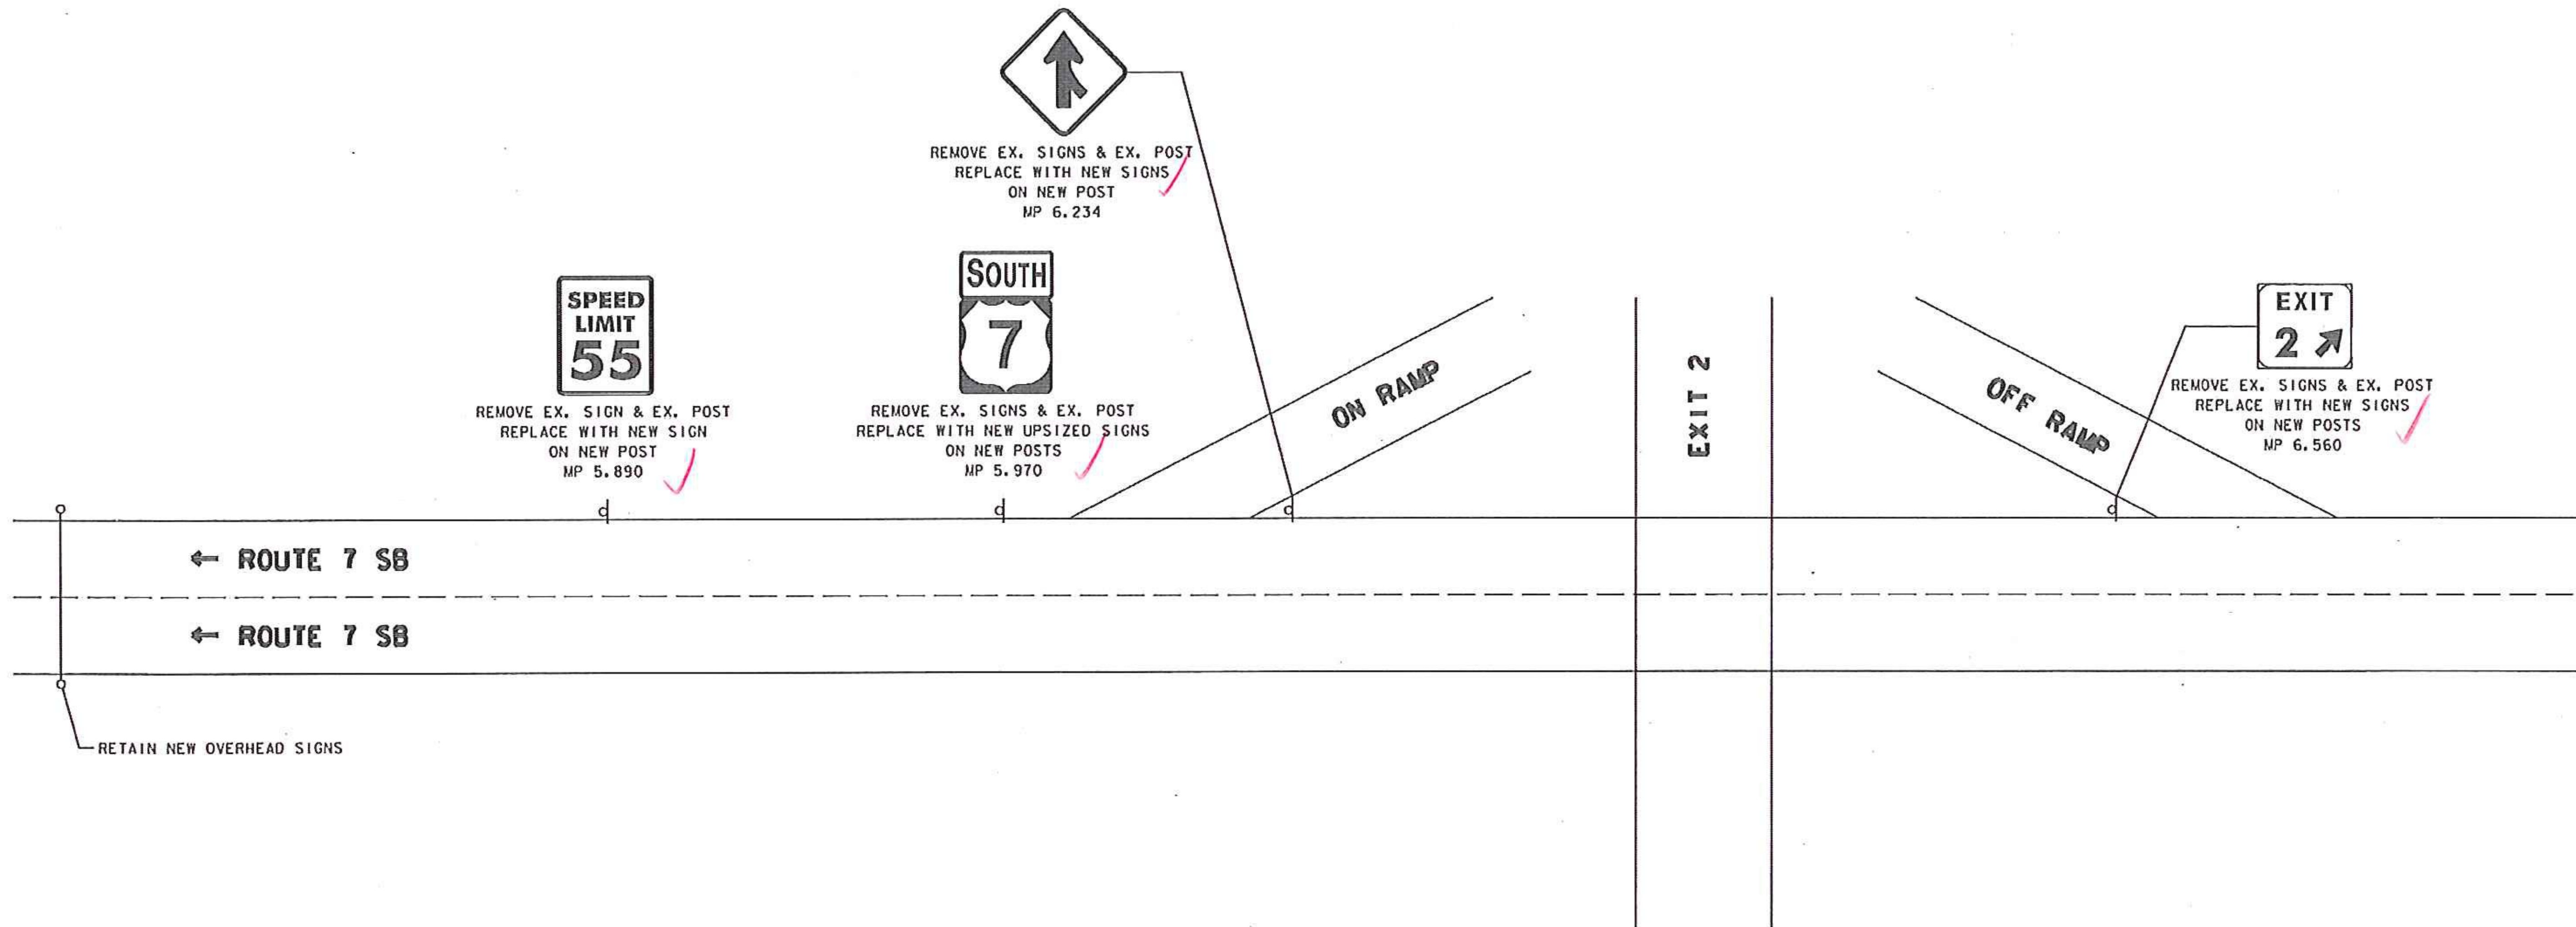

* ALL MPs ARE REFERENCED TO THE ROUTE THE SIGN SERVES
 ** SIGNS REVIEWED FROM EXIT 2 GORE SIGN TO NEW OVERHEAD SIGN STRUCTURE. FURTHER SOUTH ALL SIGNS ARE NEW.