





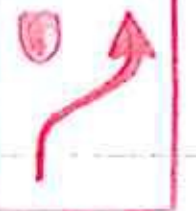
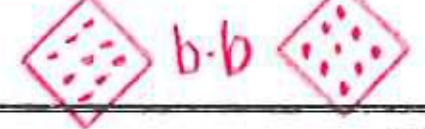


DIRECTION	MILEPOINT	LOCATION CODE (SHEET 2)	SIGN CODE	WIDTH (MM)	HEIGHT (MM)	SHEETING REMARKS	SIGN LEGEND	NEW SIGNS		EXISTING SIGNS				EXIST POST		NUMBER OF NEW POSTS	SQUARE STEEL (MM)			TUBULAR STEEL Ø (mm)				SIGN FRAME REQUIRED	REMARKS	SIGN DETAIL LOCATION		
								"A"	"B"	RETAIN	SALVAGE FROM	SALVAGE TO	REMOVE	RETAIN	REMOVE		44	50	63	75	89	100	125			SHSM	PROJECT SHEET #	STANDARD SHEET #
																	(KG /M)			(KG /M)								
<b>BENNINGTON US7</b>							FY-FLUORESCENT YELLOW FYG-FLUORESCENT YELLOW GREEN															"SHSM"-STANDARD HIGHWAY SIGNS AND MARKINGS						
NB	3.805 ✓	A	VR-041	600	600		THROUGH WAY BEGINS HERE						1		X													
		A	VR-039	600	450								1								Existing Removed							
		B	VR-040	600	600		THROUGH WAY ENDS HERE						1								4ea 9-10-12							
		B	VR-038	600	450								1															
		A	VR-039	600 ✓	450 ✓			9-10-12	0.27 ✓								1	3.7 X					INSTALL SIGNS BACK TO BACK		2			
		B	VR-038	600 ✓	450 ✓													9-10-12										
NB	3.855 ✓	A	W6-1	900	900			9-11-12					1		X						Existing Removed							
		A	W6-1	900 ✓	900 ✓												2	9.0 X							X			
NB	3.895	A	M2-1	525	375								1		X						Existing Removed							
		A	M1-5A	600	600								1								2ea 9-11-12							
		A	M2-1 ✓	525 ✓	375 ✓				0.20 ✓								1	9.9 X					GREEN ON WHITE		X			
		A	VM-078	600 ✓	300 ✓			9-11-12	0.18 ✓									9-11-12					GREEN ON WHITE		2			
		A	M1-5	600 ✓	600 ✓				0.36 ✓																	E-136B		
NB	3.91	J	R4-7	600	750								1		X						Existing Removed							
		J	OM1-1	450	450								2		X						3ea 9-18-12							
<b>SIGN SUMMARY SHEET</b>							SHEET TOTALS	2.09	0.00	0	0	0	9	0	0	4	18.4	0	0.0	0.0	0.0	0.0	PROJECT NAME: Bennington	PROJECT NUMBER: NH 019-1(54)				
							TOWN DIRECTIONAL TOTALS	SM	SM	EA	EA	EA	EA	EA	EA	EA	M	EA	KG	KG	KG	KG	FILE NAME: Bennington US7.xls	PLOT DATE: 3/7/2012				
								43.67	2.25	3	0	0	58	5	28	57	262.2	2			104.0		PROJECT MANAGER: 0	DRAWN BY: T. Guazzoni				
																						DESIGNED BY: T. Guazzoni	CHECKED: 0					
																						BENNINGTON US7 SHEET 1	SHEET 1 OF 10					