


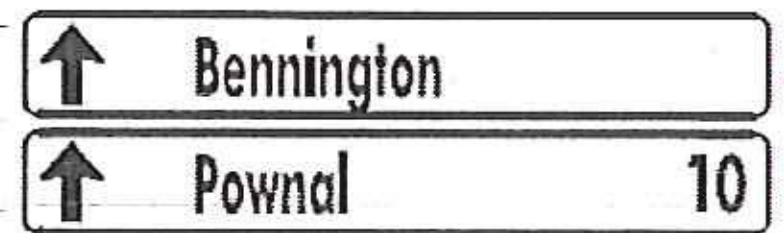
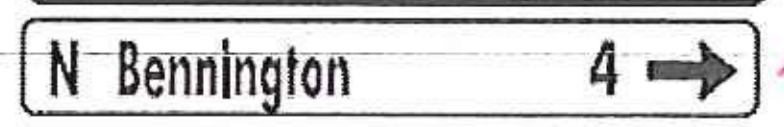




DIRECTION	MILEPOINT	LOCATION CODE (SHEET 2)	SIGN CODE	WIDTH (MM)	HEIGHT (MM)	SHEETING REMARKS	SIGN LEGEND	NEW SIGNS		EXISTING SIGNS			EXIST POST		NUMBER OF NEW POSTS	SQUARE STEEL (MM)			TUBULAR STEEL Ø (mm)				SIGN FRAME REQUIRED	RECORD PLANS	SIGN DETAIL LOCATION						
								"A"	"B"	RETAIN	SALVAGE FROM	SALVAGE TO	REMOVE	RETAIN		REMOVE	44	50	63	FOUNDATION	75	89			100	125	SHSM	PROJECT SHEET #	STANDARD SHEET #		
																	(KG /M)				(KG /M)										
BENNINGTON US7							FY-FLUORESCENT YELLOW FYG-FLUORESCENT YELLOW GREEN																		"SHSM"-STANDARD HIGHWAY SIGNS AND MARKINGS						
SB	4.375	A	M2-1	525	375																										
		A	M1-5A	600	600																										
		A	M2-1	750	525																										
		A	VM-078	900	450																										
		A	M1-5	900	900																										E-136B
SB	4.325 Rt	K	W3-3	900	900		SIGNAL AHEAD																								
		K	W3-3	900	900																										
SB	4.325 Rt	K	W3-3	900	900																										
		F	W3-3	900	900																										
		F	W3-3	900	900																										
SB	4.281	F	VD1-1	1800	300																										
		F	VD1-1A	1800	300																										
		F	VD1-1A	1800	300																										
		F	D9-2	750	750																										
		F	M6-3	750	525																										
SB	4.243	A	M3-3	900	450																										
		A	M3-3	750	375																										
SIGN SUMMARY SHEET							SHEET TOTALS	5.96	0.00	0	0	0	4	1	2	8	36.8	0	0.0	0.0	0.0	0.0	PROJECT NAME: Bennington PROJECT NUMBER: NH 019-1(54)								
VERMONT AGENCY OF TRANSPORTATION							TOWN DIRECTIONAL TOTALS	43.67	2.25	3	0	0	58	5	28	57	262.2	2		104.0			FILE NAME: Bennington US7.xls PROJECT MANAGER: 0 DESIGNED BY: T. Guazzoni BENNINGTON US7 SHEET 8						PLOT DATE: 3/7/2012 DRAWN BY: T. Guazzoni CHECKED: 0 SHEET 8 OF 10		