




RECORD PLANS

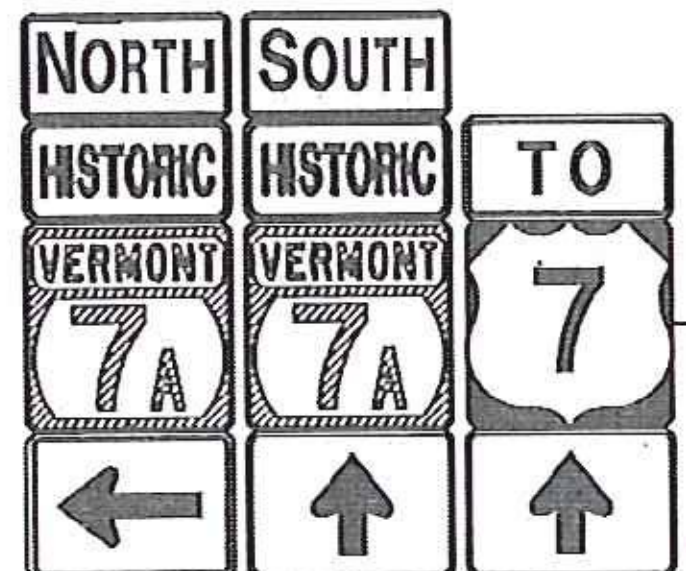


INSTALL NEW SIGNS ON NEW POSTS  
MP 0.080

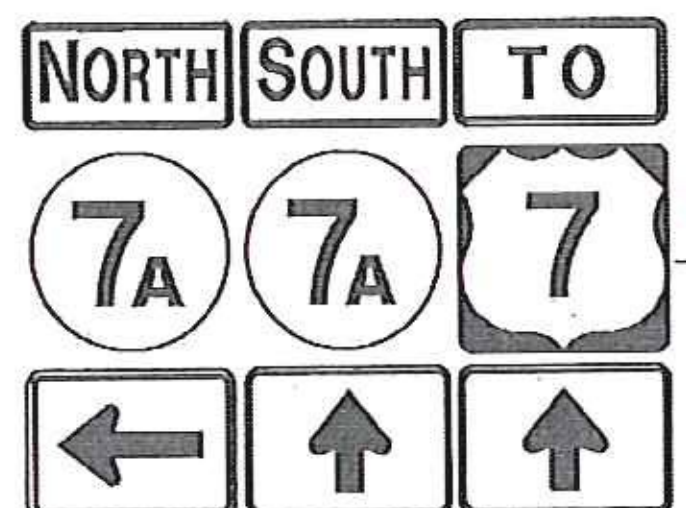


REMOVE EX. SIGNS & EX. POSTS  
PERMANENTLY  
MP 0.090

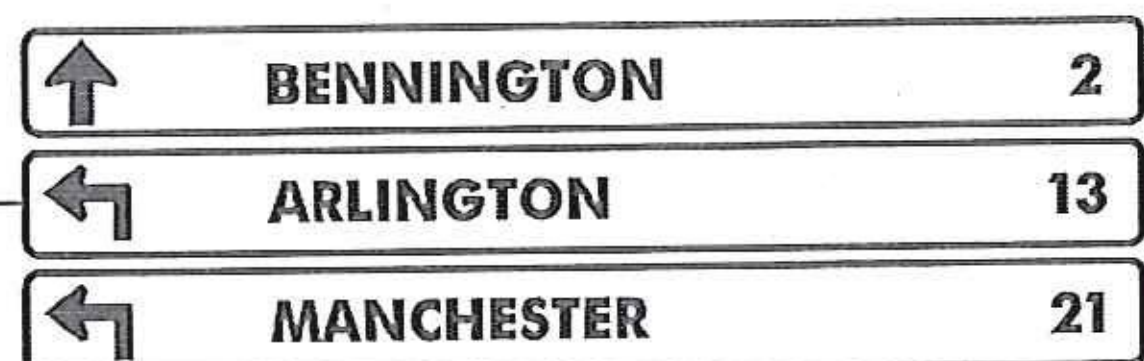

REMOVE EX SIGNS & EX. POSTS  
PERMANENTLY  
MP 0.130

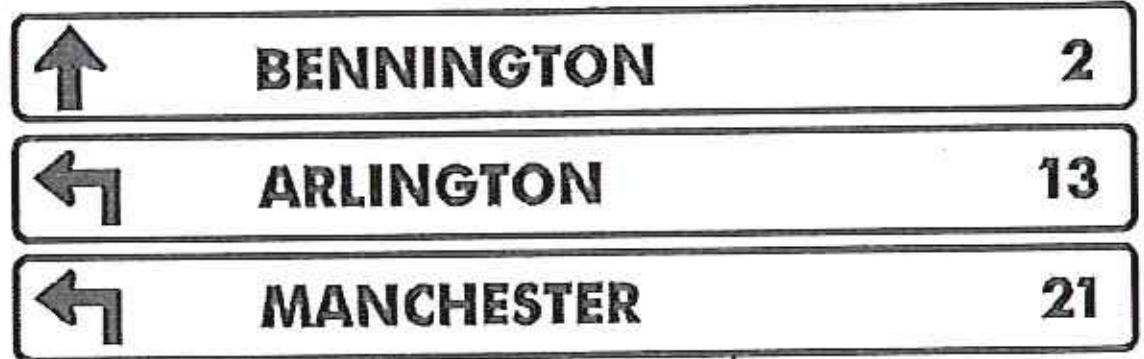

INSTALL NEW SIGNS  
ON NEW POSTS  
MP 0.140

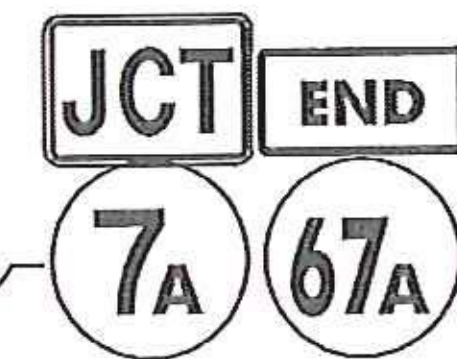

REMOVE EX. SIGNS & EX. POSTS  
PERMANENTLY  
MP 0.185



RECONFIGURE EX. SIGNS  
ON EX. POST  
MP 0.245

↑  
TO 279

PHYLLIS DRIVE

VTRANS  
OFFICE

160' +/-

67A

7A

BRIDGE

NORTH



REMOVE EX. SIGNS & EX. POSTS



REPLACE WITH NEW SIGNS  
ON NEW POSTS  
MP 0.075

- ALL MPs ARE REFERENCED TO THE ROUTE THE SIGN SERVES
- OTHER SIGNS NOT SHOWN ON PLAN ARE NEW