


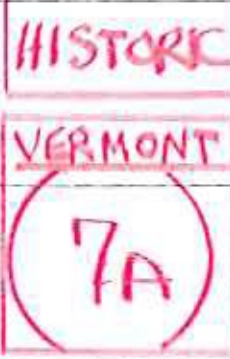












DIRECTION	MILEPOINT	LOCATION CODE (SHEET 2)	SIGN CODE	WIDTH (MM)	HEIGHT (MM)	SHEETING REMARKS	SIGN LEGEND	NEW SIGNS		EXISTING SIGNS				EXIST POST		NUMBER OF NEW POSTS	SQUARE STEEL (MM)			TUBULAR STEEL Ø (mm)				SIGN FRAME REQUIRED	RECORD PLANS	SIGN DETAIL LOCATION		
								"A"	"B"	RETAIN	SALVAGE FROM	SALVAGE TO	REMOVE	RETAIN	REMOVE		44	50	63	75	89	100	125			SHSM	PROJECT SHEET #	STANDARD SHEET #
																	(KG /M)			(KG /M)								
BENNINGTON VT67A NB							FY-FLUORESCENT YELLOW FYG-FLUORESCENT YELLOW GREEN															"SHSM"-STANDARD HIGHWAY SIGNS AND MARKINGS						
NB	0.075	A	M3-1	600	300																							
		A	M1-5A	600	600																							
		A	M3-1	600	300			0.18																				
		A	M1-5	600	600			0.36																		E-136B		
SB	0.245	F	M4-5	600	300																							
		F	VM-078	600	300																							
		F	M1-5	600	600																							
		F	M3-3	600	300																							
		F	M1-5	600	600																							
		F	M6-3	525	375																							
		F	M3-3	600	300																							
		F	M1-5	600	600																							
		F	M4-5	600	300																							
		F	VM-078	600	300																							
		F	M1-5	600	600																							
SIGN SUMMARY SHEET								SHEET TOTALS		0.54	0.00	1	5	5	7	0	2	1	4.6	0	0.0	0.0	0.0	0.0	PROJECT NAME: Bennington PROJECT NUMBER: NH 019-1(54)			
VERMONT AGENCY OF TRANSPORTATION								SM	SM	EA	EA	EA	EA	EA	EA	EA	M	EA	KG	KG	KG	KG	KG	FILE NAME: Bennington VT67A.xls PROJECT MANAGER: 0 DESIGNED BY: T. Guazzoni BENNINGTON VT67A SHEET 1				
TOWN DIRECTIONAL TOTALS								5.83	0.0	1	6	6	27	2	5	6	27.6	0	0.0	0.0	0.0	0.0	PLOT DATE: 3/7/2012 DRAWN BY: T. Guazzoni CHECKED: 0 SHEET 1 OF 4					