



REMOVE EX. SIGNS AND EX. POSTS

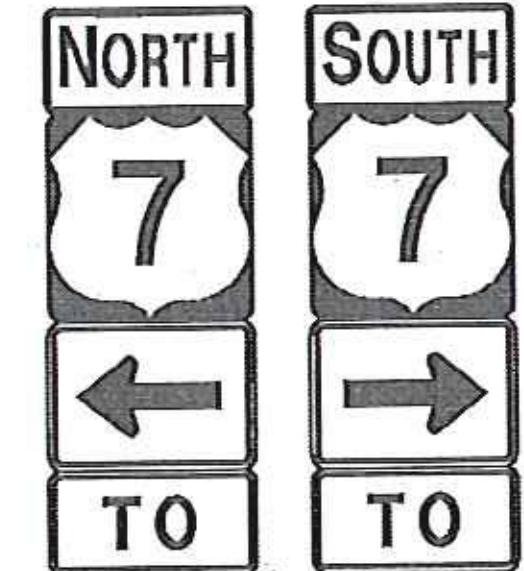

REPLACE WITH NEW SIGNS ON NEW POSTS


### RECORD PLANS

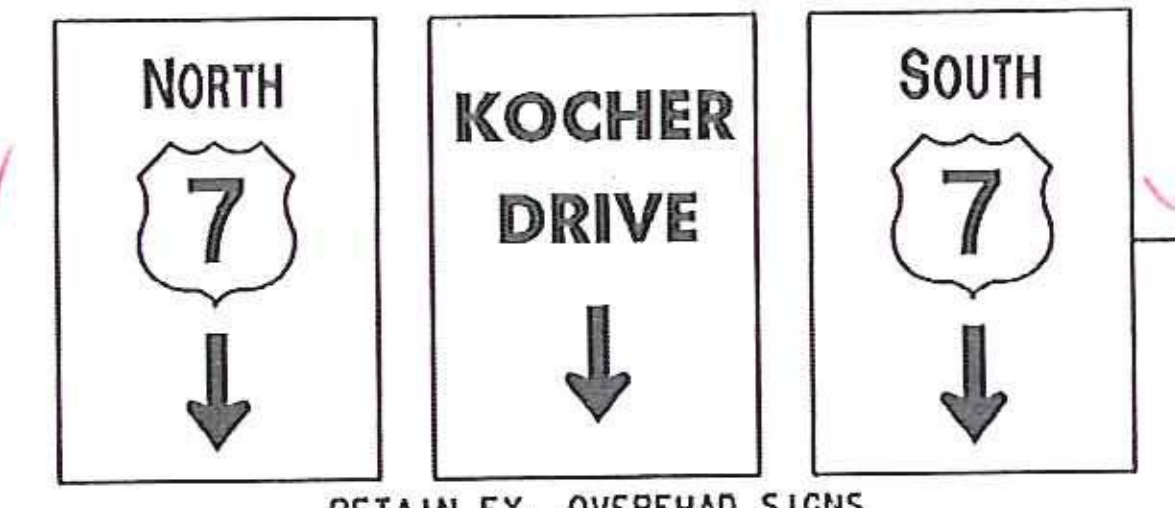

RETAIN EX. OVERHEAD SIGNS




REMOVE EX. SIGN & EX. POST PERMANENTLY

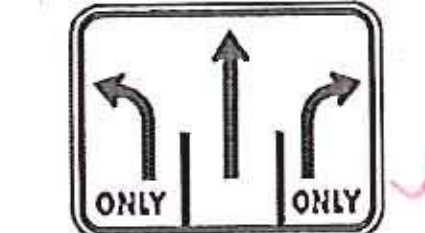

REPLACE WITH NEW SIGN ON NEW POSTS



REMOVE EX. SIGN ON EX. POST

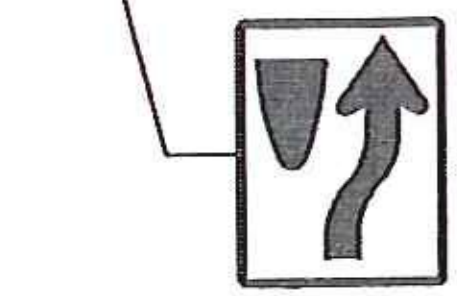


REMOVE EX. SIGNS & EX. POSTS


LEFT LANE MUST TURN LEFT




INSTALL NEW SIGN ABOVE KEEP RIGHT SIGN

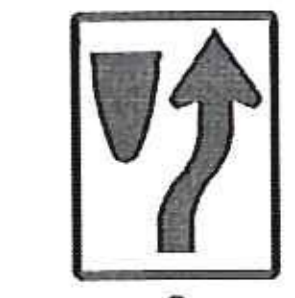

REMOVE EX. SIGNS & POST

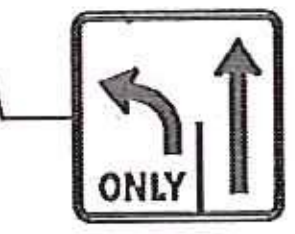

REMOVE EX. SIGN & EX POSTS

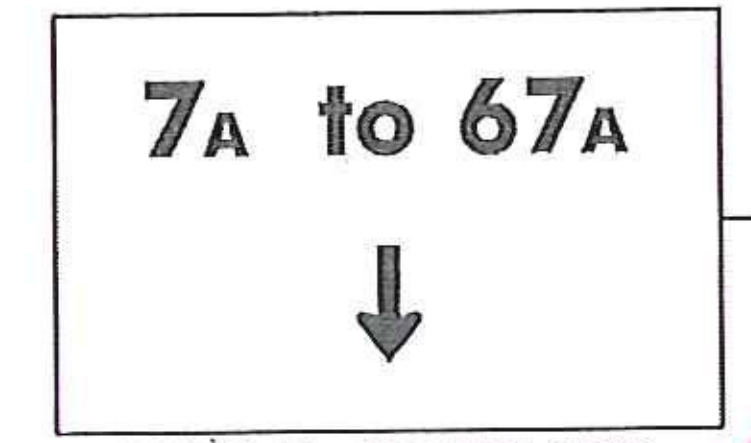

RETAIN EX. OVERHEAD SIGNS

Bennington AC NH 019-1 (54)  
 Sign Sheets  
 Bennington 7A  
 March 21, 2012  
 Not to Scale  
 Sheet 1 of 4

• ALL MPs ARE REFERENCED TO THE ROUTE THE SIGN SERVES