



# RECORD PLANS

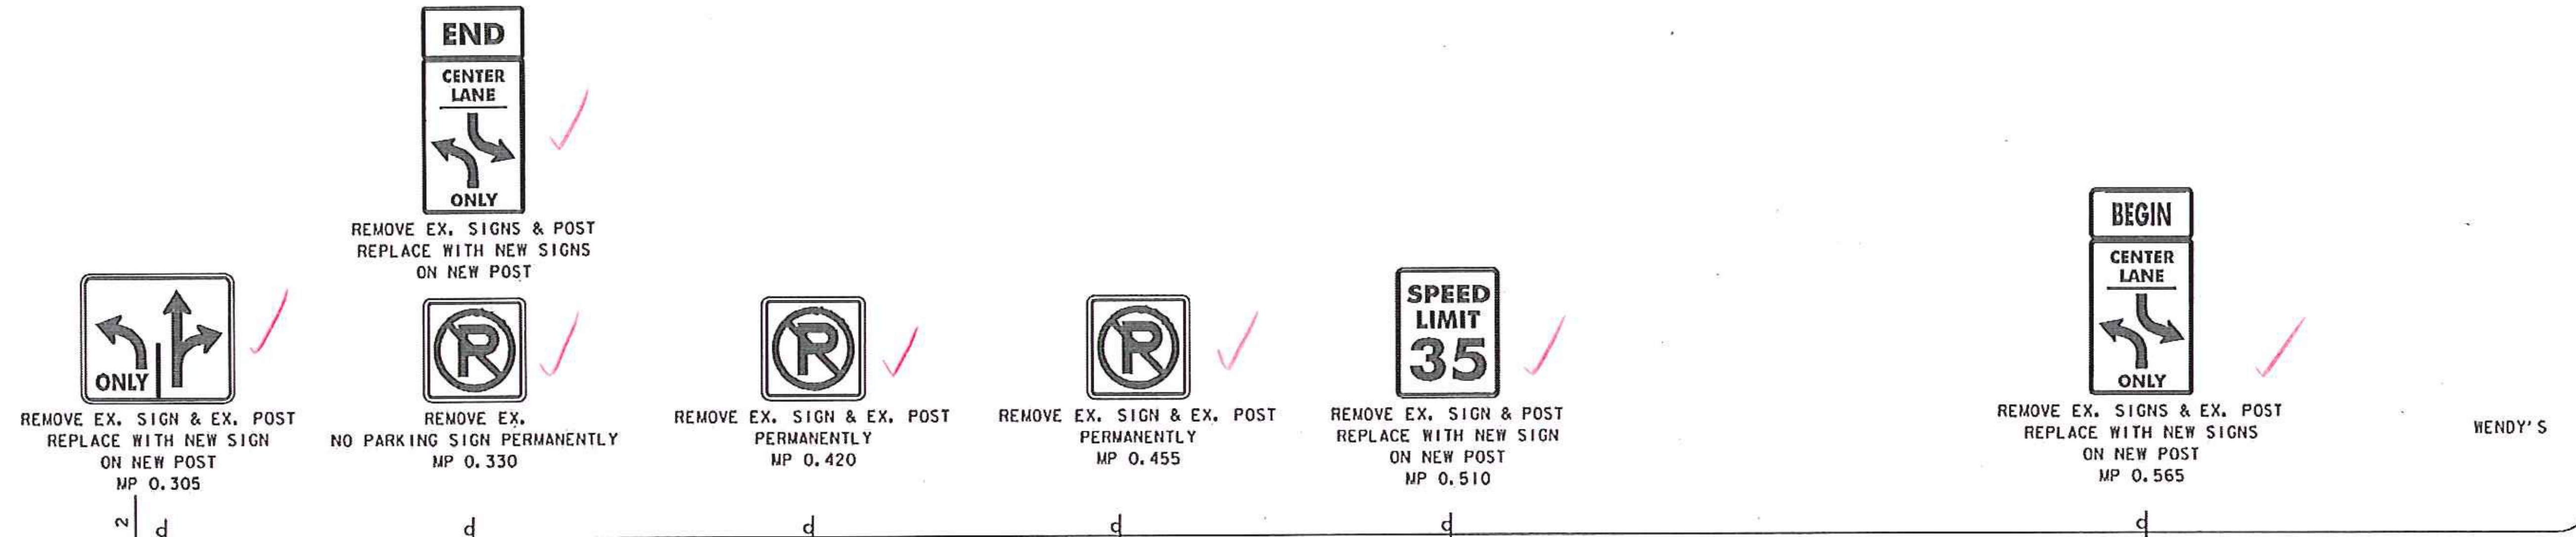

MATCH LINE - SHEET 2

7A

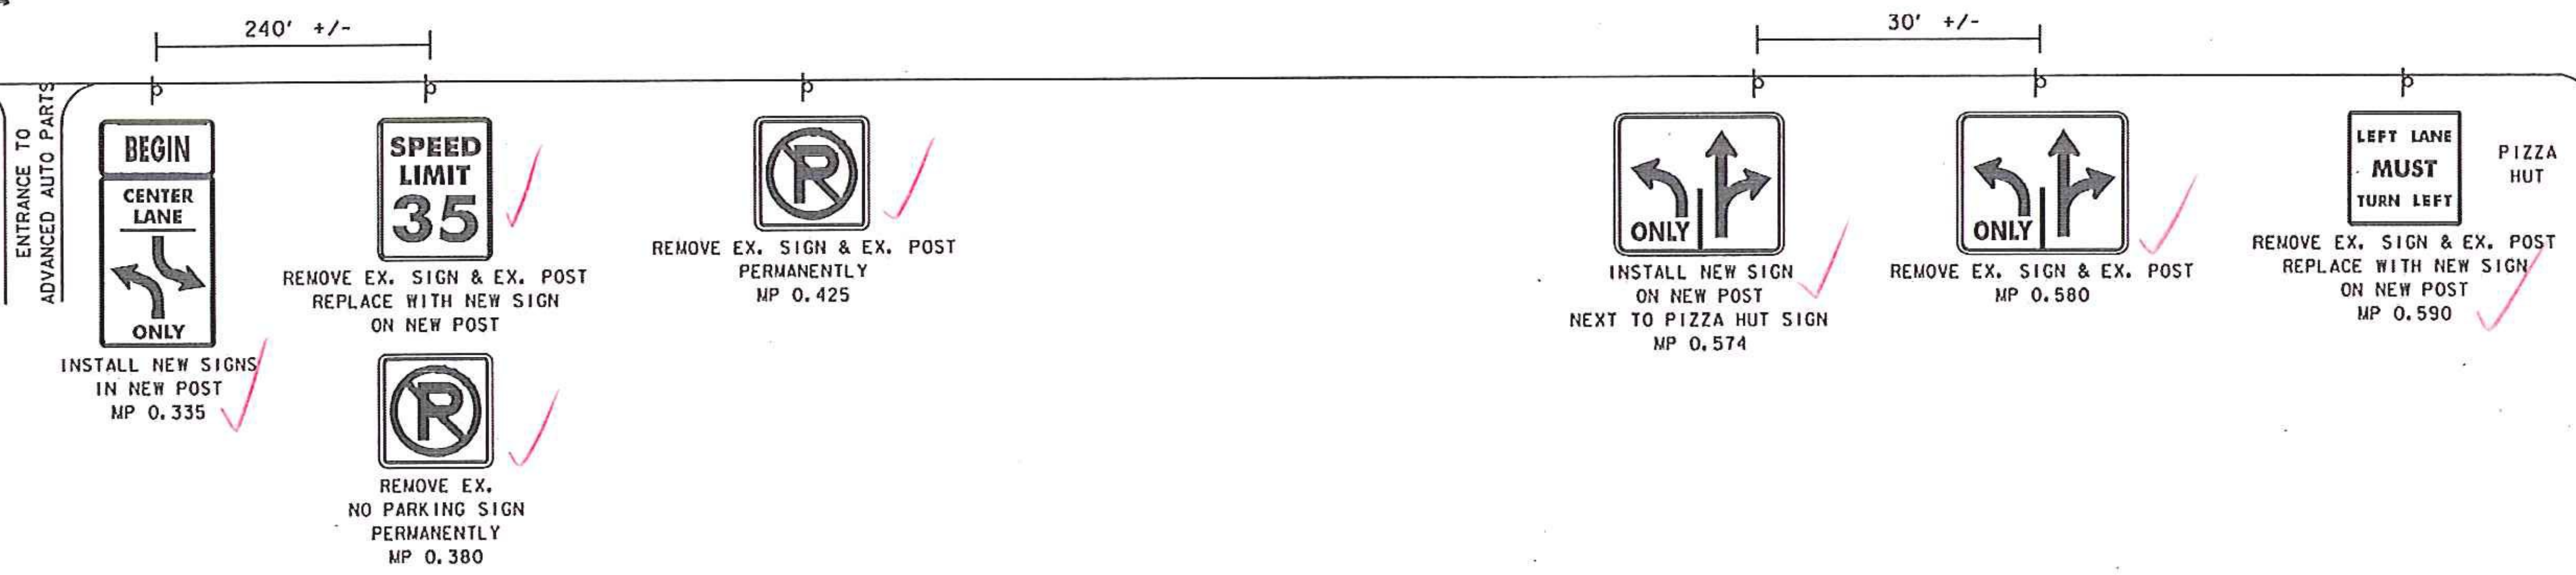

7A

MATCH LINE - SHEET 4

\*ALL MPs ARE REFERENCED TO THE ROUTE THE SIGN SERVES