


# RECORD PLANS

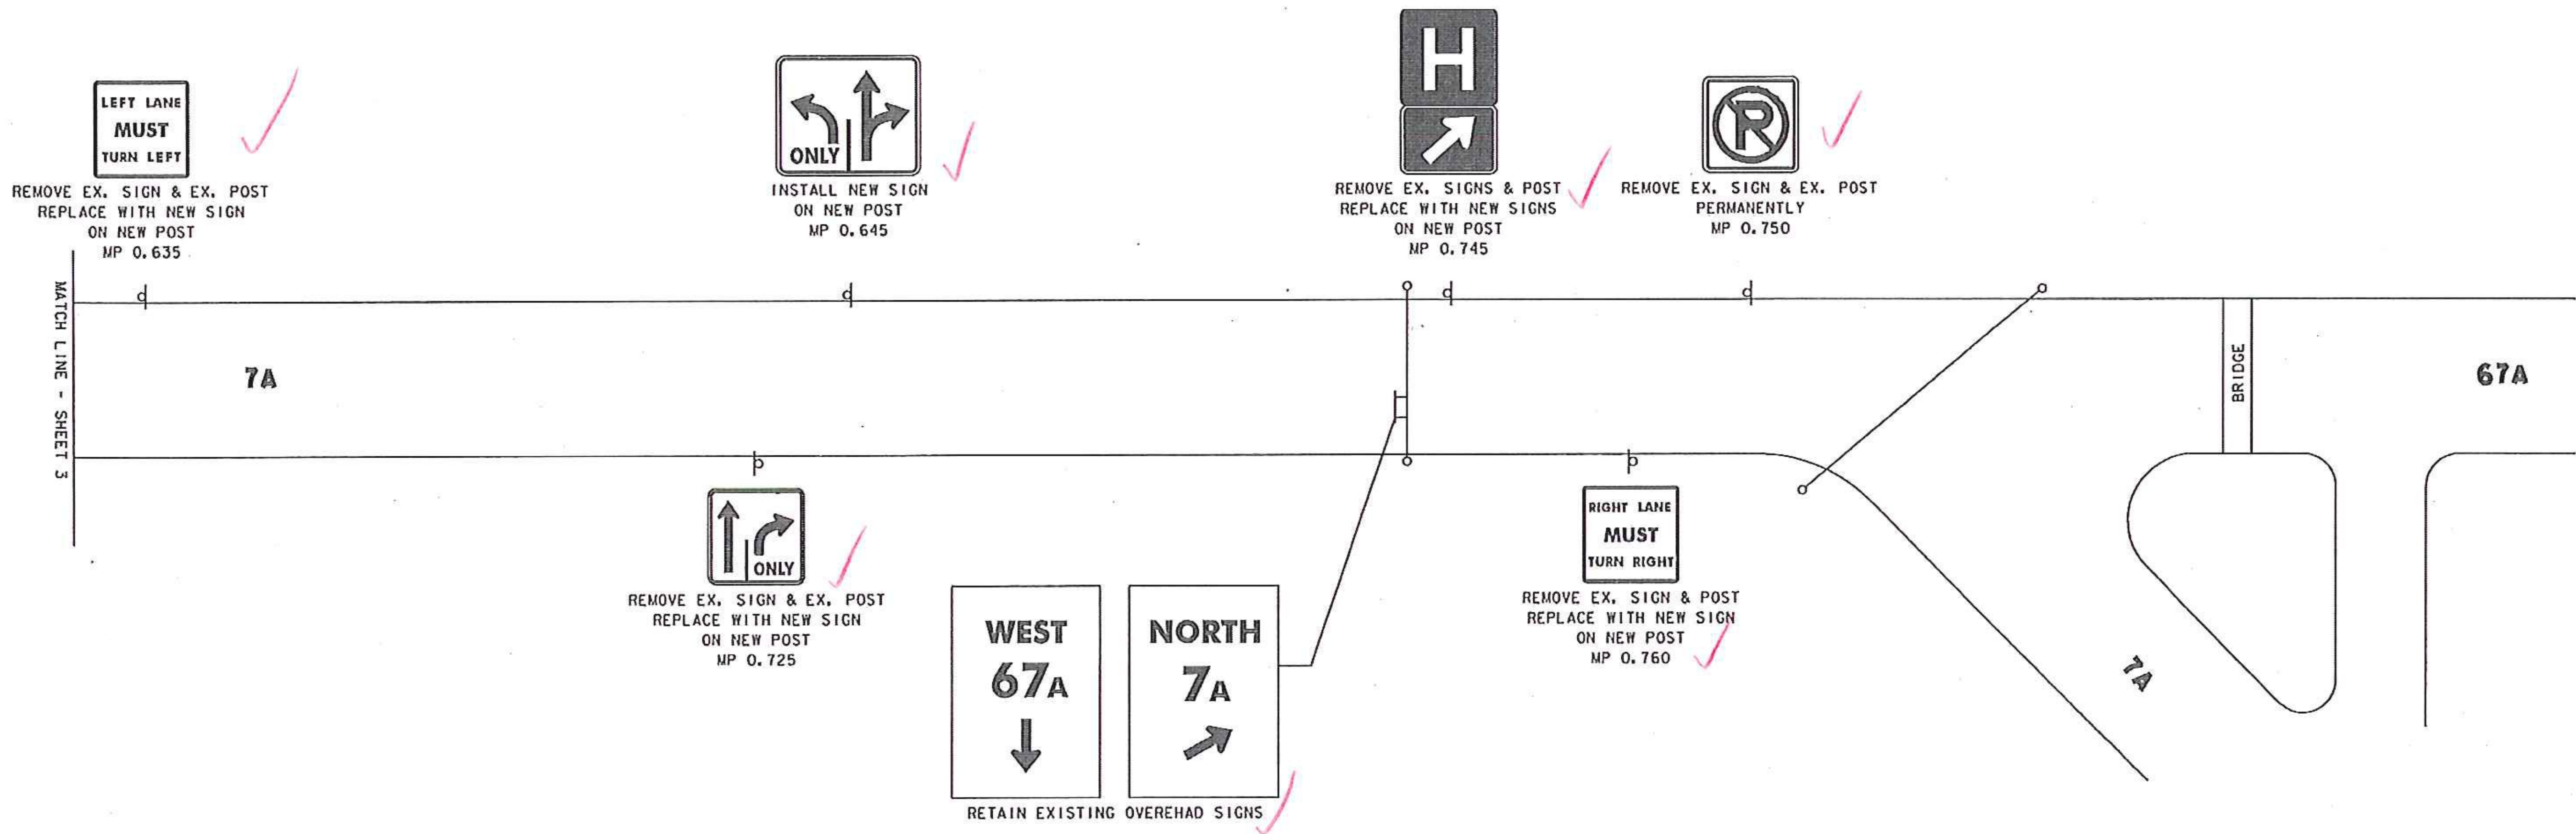

\*ALL MILES ARE REFERENCED TO THE ROUTE THE SIGN SERVES