
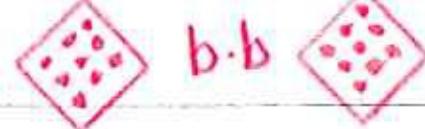







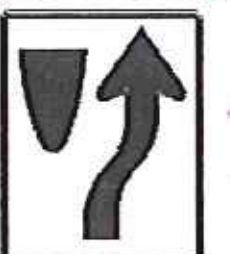






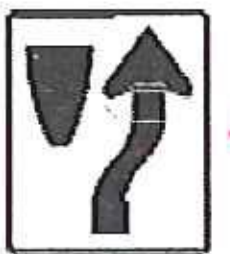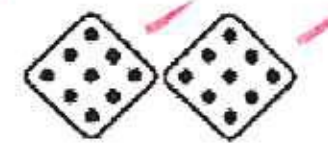

DIRECTION	MILEPOINT	LOCATION CODE (SHEET 2)	SIGN CODE	WIDTH (MM)	HEIGHT (MM)	SHEETING REMARKS	SIGN LEGEND	NEW SIGNS		EXISTING SIGNS				EXIST POST		NUMBER OF NEW POSTS	SQUARE STEEL (MM)			TUBULAR STEEL Ø (mm)				SIGN FRAME REQUIRED	RECORD PLANS REMARKS	SIGN DETAIL LOCATION		
								"A"	"B"	RETAIN	SALVAGE FROM	SALVAGE TO	REMOVE	RETAIN	REMOVE		44	50	63	75	89	100	125			SHSM	PROJECT SHEET #	STANDARD SHEET #
BENNINGTON 7A							FY-FLUORESCENT YELLOW FYG-FLUORESCENT YELLOW GREEN															"SHSM"-STANDARD HIGHWAY SIGNS AND MARKINGS						
NB	0.010	J	R4-7	600	750																							
		J	OM1-1	450	450																							
		J	R3-7L	750	750			0.56																				
		J	R4-7	600	750		Added 	0.45 ✓																	X			
		J	OM1-1	450	450			0.20 ✓																	X			
		K	OM1-1	450	450			0.20 ✓																	X			
							BACK TO BACK																					
NB	0.045	K	R4-7	600	750																							
		K	OM1-1	450	450																							
		K	R3-7L	750	750			0.56 ✓																	X			
		K	R4-7	600	750			0.45 ✓																	X			
		K	OM1-1	450	450			0.20 ✓																	X			
		J	OM1-1	450	450			0.20 ✓																	X			
							BACK TO BACK																					
NB	0.065	A	VR-921L	750	750																							
		A	VR-921L	750	750		ONLY 	0.56 ✓																	E-145A			
NB	0.100	A	R3-7L	750	750																							
		A	R3-7L	750	750			0.56																	X			
SIGN SUMMARY SHEET							SHEET TOTALS	3.40	0.00	0	0	0	8	0	4	4	18.4	0	0.0	0.0	0.0	0.0		PROJECT NAME: Bennington PROJECT NUMBER: NH 019-1(54)				
VERMONT AGENCY OF TRANSPORTATION							TOWN DIRECTIONAL TOTALS	SM	SM	EA	EA	EA	EA	EA	EA	EA	M	EA	KG	KG	KG	KG		FILE NAME: Bennington VT7A.xls PROJECT MANAGER: 0 DESIGNED BY: T. Guazzoni BENNINGTON VT7A SHEET 1				
								17.85	0.0	1	0	0	46	0	26	25	115.0	0		0.0				PLOT DATE: 3/7/2012 DRAWN BY: T. Guazzoni CHECKED: 0 SHEET 1 OF 7				