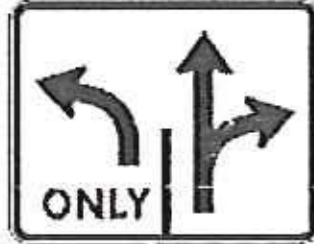



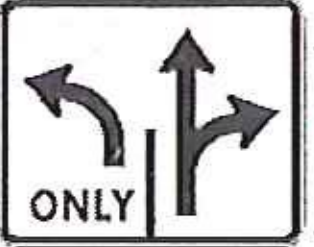



DIRECTION	MILEPOINT	LOCATION CODE (SHEET 2)	SIGN CODE	WIDTH (MM)	HEIGHT (MM)	SHEETING REMARKS	SIGN LEGEND	NEW SIGNS		EXISTING SIGNS				EXIST POST		NUMBER OF NEW POSTS	SQUARE STEEL (MM)			TUBULAR STEEL Ø (mm)				SIGN FRAME REQUIRED	REMARKS	SIGN DETAIL LOCATION			
								"A"	"B"	RETAIN	SALVAGE FROM	SALVAGE TO	REMOVE	RETAIN	REMOVE		44	50	63	FOUNDATION	75	89	100			125	SHSM	PROJECT SHEET #	STANDARD SHEET #
																	(KG /M)				(KG /M)								
BENNINGTON 7A							FY-FLUORESCENT YELLOW FYG-FLUORESCENT YELLOW GREEN															"SHSM"-STANDARD HIGHWAY SIGNS AND MARKINGS							
NB	0.230	A	VR-922L	900	750									1	X							Existing Removed Lea 9-21-12							
		A	VR-922L	900	750			0.68						1												E-145A			
NB	0.335	A	M4-14	600	300																								
		A	R3-9B	600	900			0.54																					
NB	0.380	A	R2-1	600	750									1	X							Existing Removed							
		A	R8-3A	600	600	NO PARKING SYMBOL								1															
		A	R2-1	600	750			0.45						1															
NB	0.425	A	R8-3A	600	600	NO PARKING SYMBOL								1	X							Existing Removed Lea 9-25-12							
NB	0.574	A	VR-922L	900	750			0.68						1													E-145A		
NB	0.580	A	VR-922L	900	750	LEFT "ONLY"/THRU & RIGHT								1	X							Existing Removed Lea 9-25-12							
NB	0.590	A	R3-7L	750	750									1	X							Existing Removed Lea 9-25-12							
		A	R3-7L	750	750			0.56						1															
SIGN SUMMARY SHEET							SHEET TOTALS	3.08	0.00	0	0	0	6	0	5	5	23.0	0	0.0	0.0	0.0	0.0	PROJECT NAME: Bennington PROJECT NUMBER: NH 019-1(54)						
VERMONT AGENCY OF TRANSPORTATION							TOWN DIRECTIONAL TOTALS	17.85	0.0	1	0	0	46	0	26	25	115.0	0	0.0	0.0	0.0	0.0	FILE NAME: Bennington VT7A.xls PROJECT MANAGER: 0 DESIGNED BY: T. Guazzoni BENNINGTON VT7A SHEET 2						
																						PLOT DATE: 3/7/2012 DRAWN BY: T. Guazzoni CHECKED: 0 SHEET 2 OF 7							