





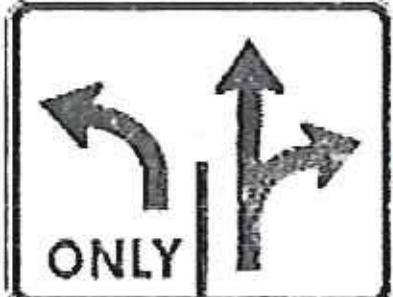
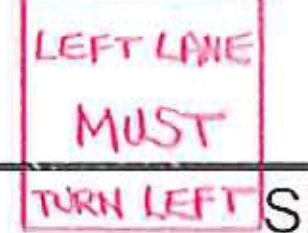


DIRECTION	MILEPOINT	LOCATION CODE (SHEET 2)	SIGN CODE	WIDTH (MM)	HEIGHT (MM)	SHEETING REMARKS	SIGN LEGEND	NEW SIGNS		EXISTING SIGNS			EXIST POST		NUMBER OF NEW POSTS	SQUARE STEEL (MM)			TUBULAR STEEL Ø (mm)				SIGN FRAME REQUIRED	RECORD PLANS REMARKS	SIGN DETAIL LOCATION			
								"A"	"B"	RETAIN	SALVAGE FROM	SALVAGE TO	REMOVE	RETAIN		REMOVE	44	50	63	75	89	100			125	SHSM	PROJECT SHEET #	STANDARD SHEET #
																	(KG /M)			(KG /M)								
BENNINGTON 7A							FY-FLUORESCENT YELLOW FYG-FLUORESCENT YELLOW GREEN															"SHSM"-STANDARD HIGHWAY SIGNS AND MARKINGS						
																							Contract signs					
NB	0.725	A	VR-921R	750	750																	Existing Removed Lea 9-25-12						
		A	VR-921R	750	750			0.56														9-25-12 4.1 X			E-145A			
NB	0.760	A	R3-7R	750	750																	Existing Removed Lea 9-25-12						
		A	R3-7R	750	750			0.56														9-25-12 4.1 X		X				
SB	0.750	F	R8-3A	600	600		NO PARKING SYMBOL															Existing Removed Lea 9-25-12						
SB	0.745	F	D9-2	600	600																	Existing Removed						
		F	D9-2A	525	375																	2 ea 9-25-12						
		F	D9-2	600	600																	4.3 X 9-25-12		X				
		F	M6-3	525	375																	0.20 9-25-12		X				
SB	0.645	F	VR-922L	900	750																	9-25-12 4.1 X			E-145A			
SB	0.635	F	R3-7L	750	750																	Existing Removed Lea 9-25-12						
SIGN SUMMARY SHEET							SHEET TOTALS	2.36	0.00	0	0	0	6	0	5	4	18.4	0	0.0	0.0	0.0	0.0	PROJECT NAME: Bennington PROJECT NUMBER: NH 019-1(54)					
VERMONT AGENCY OF TRANSPORTATION							TOWN DIRECTIONAL TOTALS	17.85	0.0	1	0	0	46	0	26	25	115.0	0	0.0	0.0	0.0	FILE NAME: Bennington VT7A.xls PROJECT MANAGER: 0 DESIGNED BY: T. Guazzoni BENNINGTON VT7A SHEET 3	PLOT DATE: 3/7/2012 DRAWN BY: T. Guazzoni CHECKED 0 SHEET 3 OF 7					