

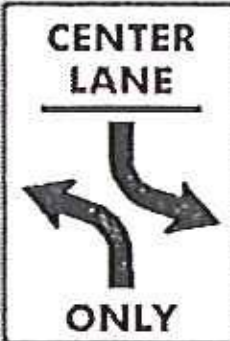

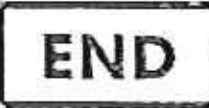
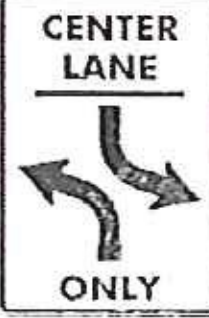



DIRECTION	MILEPOINT	LOCATION CODE (SHEET 2)	SIGN CODE	WIDTH (MM)	HEIGHT (MM)	SHEETING REMARKS	SIGN LEGEND	NEW SIGNS		EXISTING SIGNS				EXIST POST		NUMBER OF NEW POSTS	SQUARE STEEL (MM)			TUBULAR STEEL Ø (mm)				SIGN FRAME REQUIRED	RECORD PLANS REMARKS	SIGN DETAIL LOCATION																					
								"A"	"B"	RETAIN	SALVAGE FROM	SALVAGE TO	REMOVE	RETAIN	REMOVE		44	50	63	75	89	100	125			SHSM	PROJECT SHEET #	STANDARD SHEET #																			
																	(KG /M)			(KG /M)																											
BENNINGTON 7A							FY-FLUORESCENT YELLOW FYG-FLUORESCENT YELLOW GREEN															"SHSM"-STANDARD HIGHWAY SIGNS AND MARKINGS																									
SB	0.635	F	R3-7L	750	750			0.56						1				9-25-12 4.1 X							X																						
SB	0.565	F	VR-644	600	300									1																																	
		F	R3-9B	600	900									1																																	
		F	M4-14	600	300			0.18						1												X																					
		F	R3-9B	600	900			0.54																		X																					
SB	0.510	F	R2-1	600	750									1																																	
		F	R2-1	600	750			0.45						1												X																					
SB	0.455	F	R8-3A	600	600		NO PARKING SYMBOL							1																																	
SB	0.420	F	R8-3A	600	600		NO PARKING SYMBOL							1																																	
SB	0.330	F	M4-6	600	300									1																																	
		F	R3-9B	600	900									1																																	
		F	R8-3A	600	600		NO PARKING SYMBOL							1																																	
		F	M4-6	600	300			0.18						1												X																					
		F	R3-9B	600	900			0.54																		X																					
SB	0.305	F	VR-922L	36	30									1																																	
SIGN SUMMARY SHEET							SHEET TOTALS	2.45	0.00	0	0	0	9	0	6	4	18.4	0	0.0	0.0	0.0	0.0	0.0	0.0	0.0	0.0	0.0	0.0																			
VERMONT AGENCY OF TRANSPORTATION							TOWN DIRECTIONAL TOTALS	17.85	0.0	1	0	0	45	0	26	25	115.0	0	0.0	0.0	0.0	0.0	0.0	0.0	0.0	0.0	0.0	0.0																			
																					PROJECT NAME:	Bennington		PLOT DATE:	3/7/2012																						
																					PROJECT NUMBER:	NH 019-1(54)		DRAWN BY:	T. Guazzoni																						
																					FILE NAME:	Bennington VT7A.xls		CHECKED:	0																						
																					DESIGNED BY:	T. Guazzoni		SHEET:	4		OF:	7																			
																					BENNINGTON VT7A SHEET 4																										