


(1) 4T1 - FABRIC TROUGH
4 x 660 x 3 PLY
(22 Dia Holes Match Bolt to 32 mm Flange)

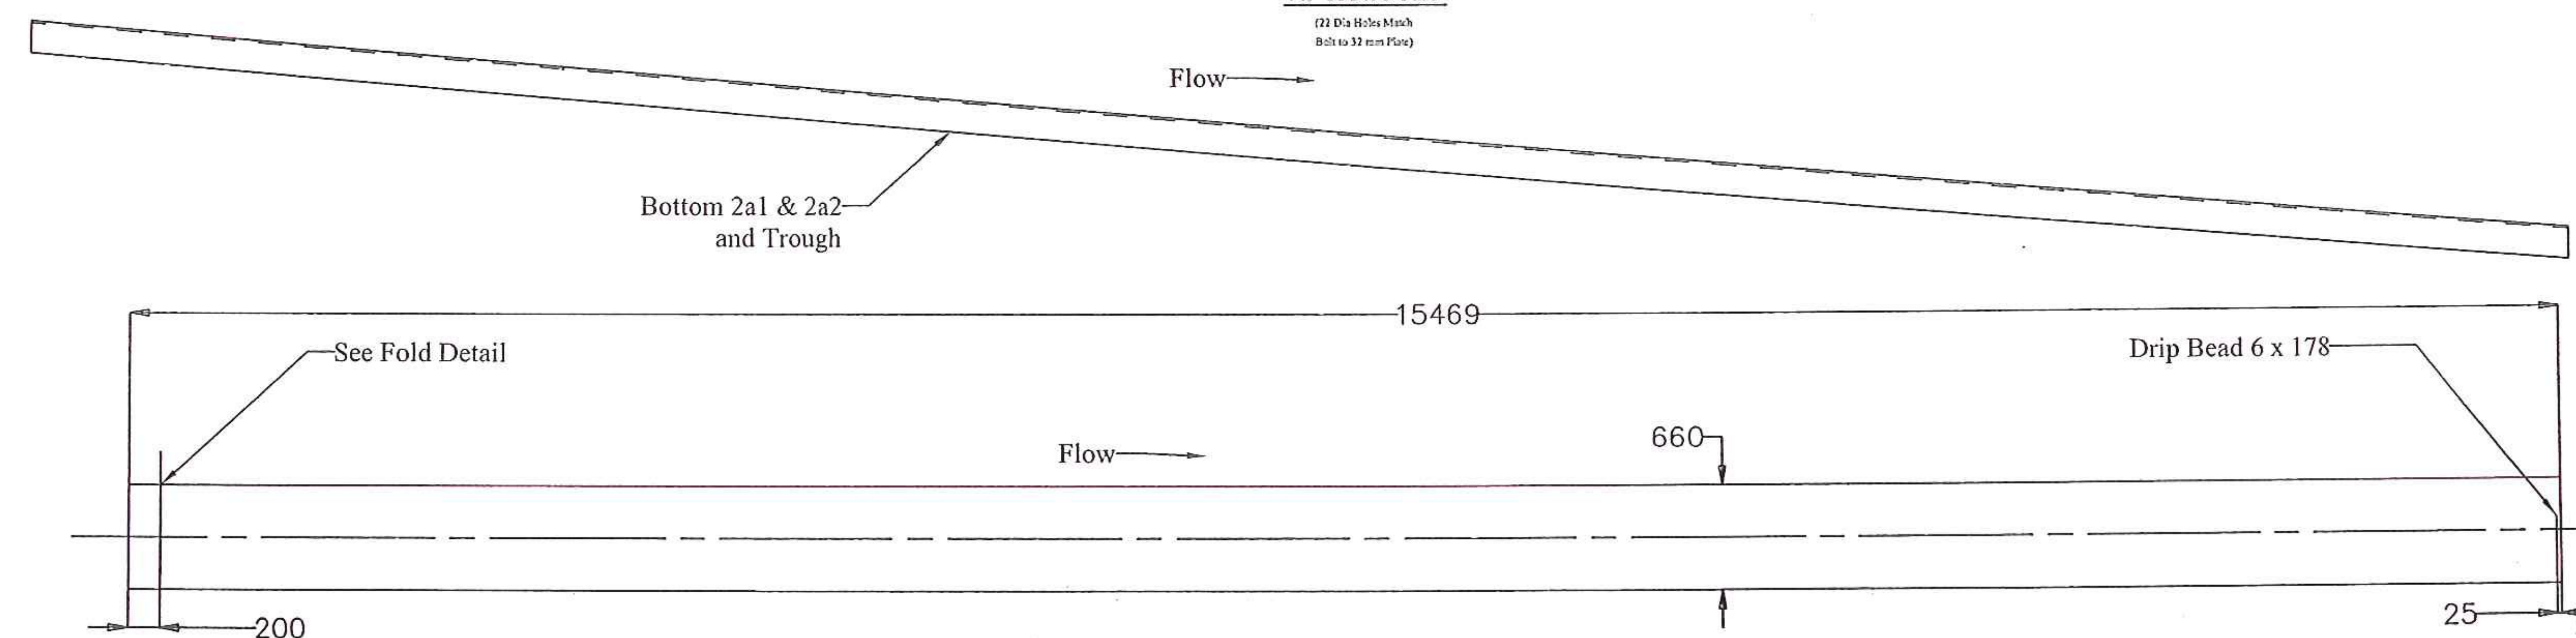

(1) 4T2 - FABRIC TROUGH
4 x 660 x 3 PLY
(22 Dia Holes Match Bolt to 32 mm Flange)

ALL DRAWINGS ARE REVIEWED UNLESS NOTED OTHERWISE


NO EXCEPTION TAKEN	<input checked="" type="checkbox"/>
REVISE AS NOTED RESUBMISSION NOT REQUIRED	<input type="checkbox"/>
REVISE AS NOTED RESUBMISSION REQUIRED	<input type="checkbox"/>
REJECTED	<input type="checkbox"/>

DATE 7/21/10

SIGNATURE Michael Christie

REVIEW BY STANTEC IS FOR THE SOLE PURPOSE OF ASCERTAINING GENERAL CONFORMITY WITH DESIGN. CONTRACTOR IS RESPONSIBLE FOR DIMENSIONS, FABRICATION AND CONSTRUCTION METHODS, COORDINATION OF SUB-TRADES, DETAIL DESIGN OF COMPONENTS, AND ERRORS OR OMISSIONS ON SHOP DRAWINGS.

METRIC

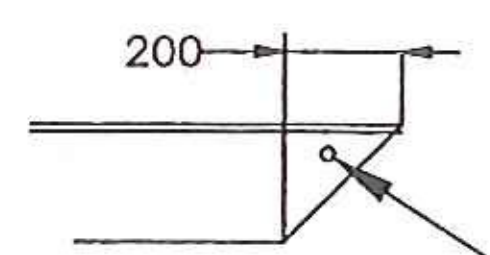

2 Bolts 13 x 25
w/ 2 Washers & Nut (Typ)

FOLDED TROUGH DETAIL

BILL OF MATERIALS				
QTY	MARK	SHAPE	LENGTH	REMARKS
1	4T1	FABRIC TROUGH (ABUT 1)		
1		Preformed Fabric Material 3 Ply x 660 x 16002		
2		Bolt 13 x 25 Lg with 2 Washers and Nut		
1	4T2	FABRIC TROUGH (ABUT 1)		
1		Preformed Fabric Material 3 Ply x 660 x 15469		
2		Bolt 13 x 25 Lg with 2 Washers and Nut		

REV NO.	DATE	DESCRIPTION
1	7-14-2010	REVISED PER APPROVAL COMMENTS
0	6-21-2010	SUBMITTED FOR APPROVAL

HOLES AS NOTED

MATERIAL: AASHTO M 270M/M270 GRADE 250 GALV

DRAWING COVERS

TROUGH LAYOUT - BRIDGE 14A

PROJECT	BENNINGTON
LOCATION	RAMP G/S OVER VT ROUTE 279 WB
ENGINEER	STATE OF VERMONT AOT / STANTEC
CUSTOMER	MILLER CONSTRUCTION

MERRIMACK SHEET METAL

119 HALL STREET
CONCORD NH 03301

Tel. 603.224.7766
Fax 603.224.7925

DRAWN BY:	RL
CHECKED BY:	JD
JOB NO.:	#3374
DWG.:	F4