




STATE OF VT.



VERMONT AGENCY OF TRANSPORTATION

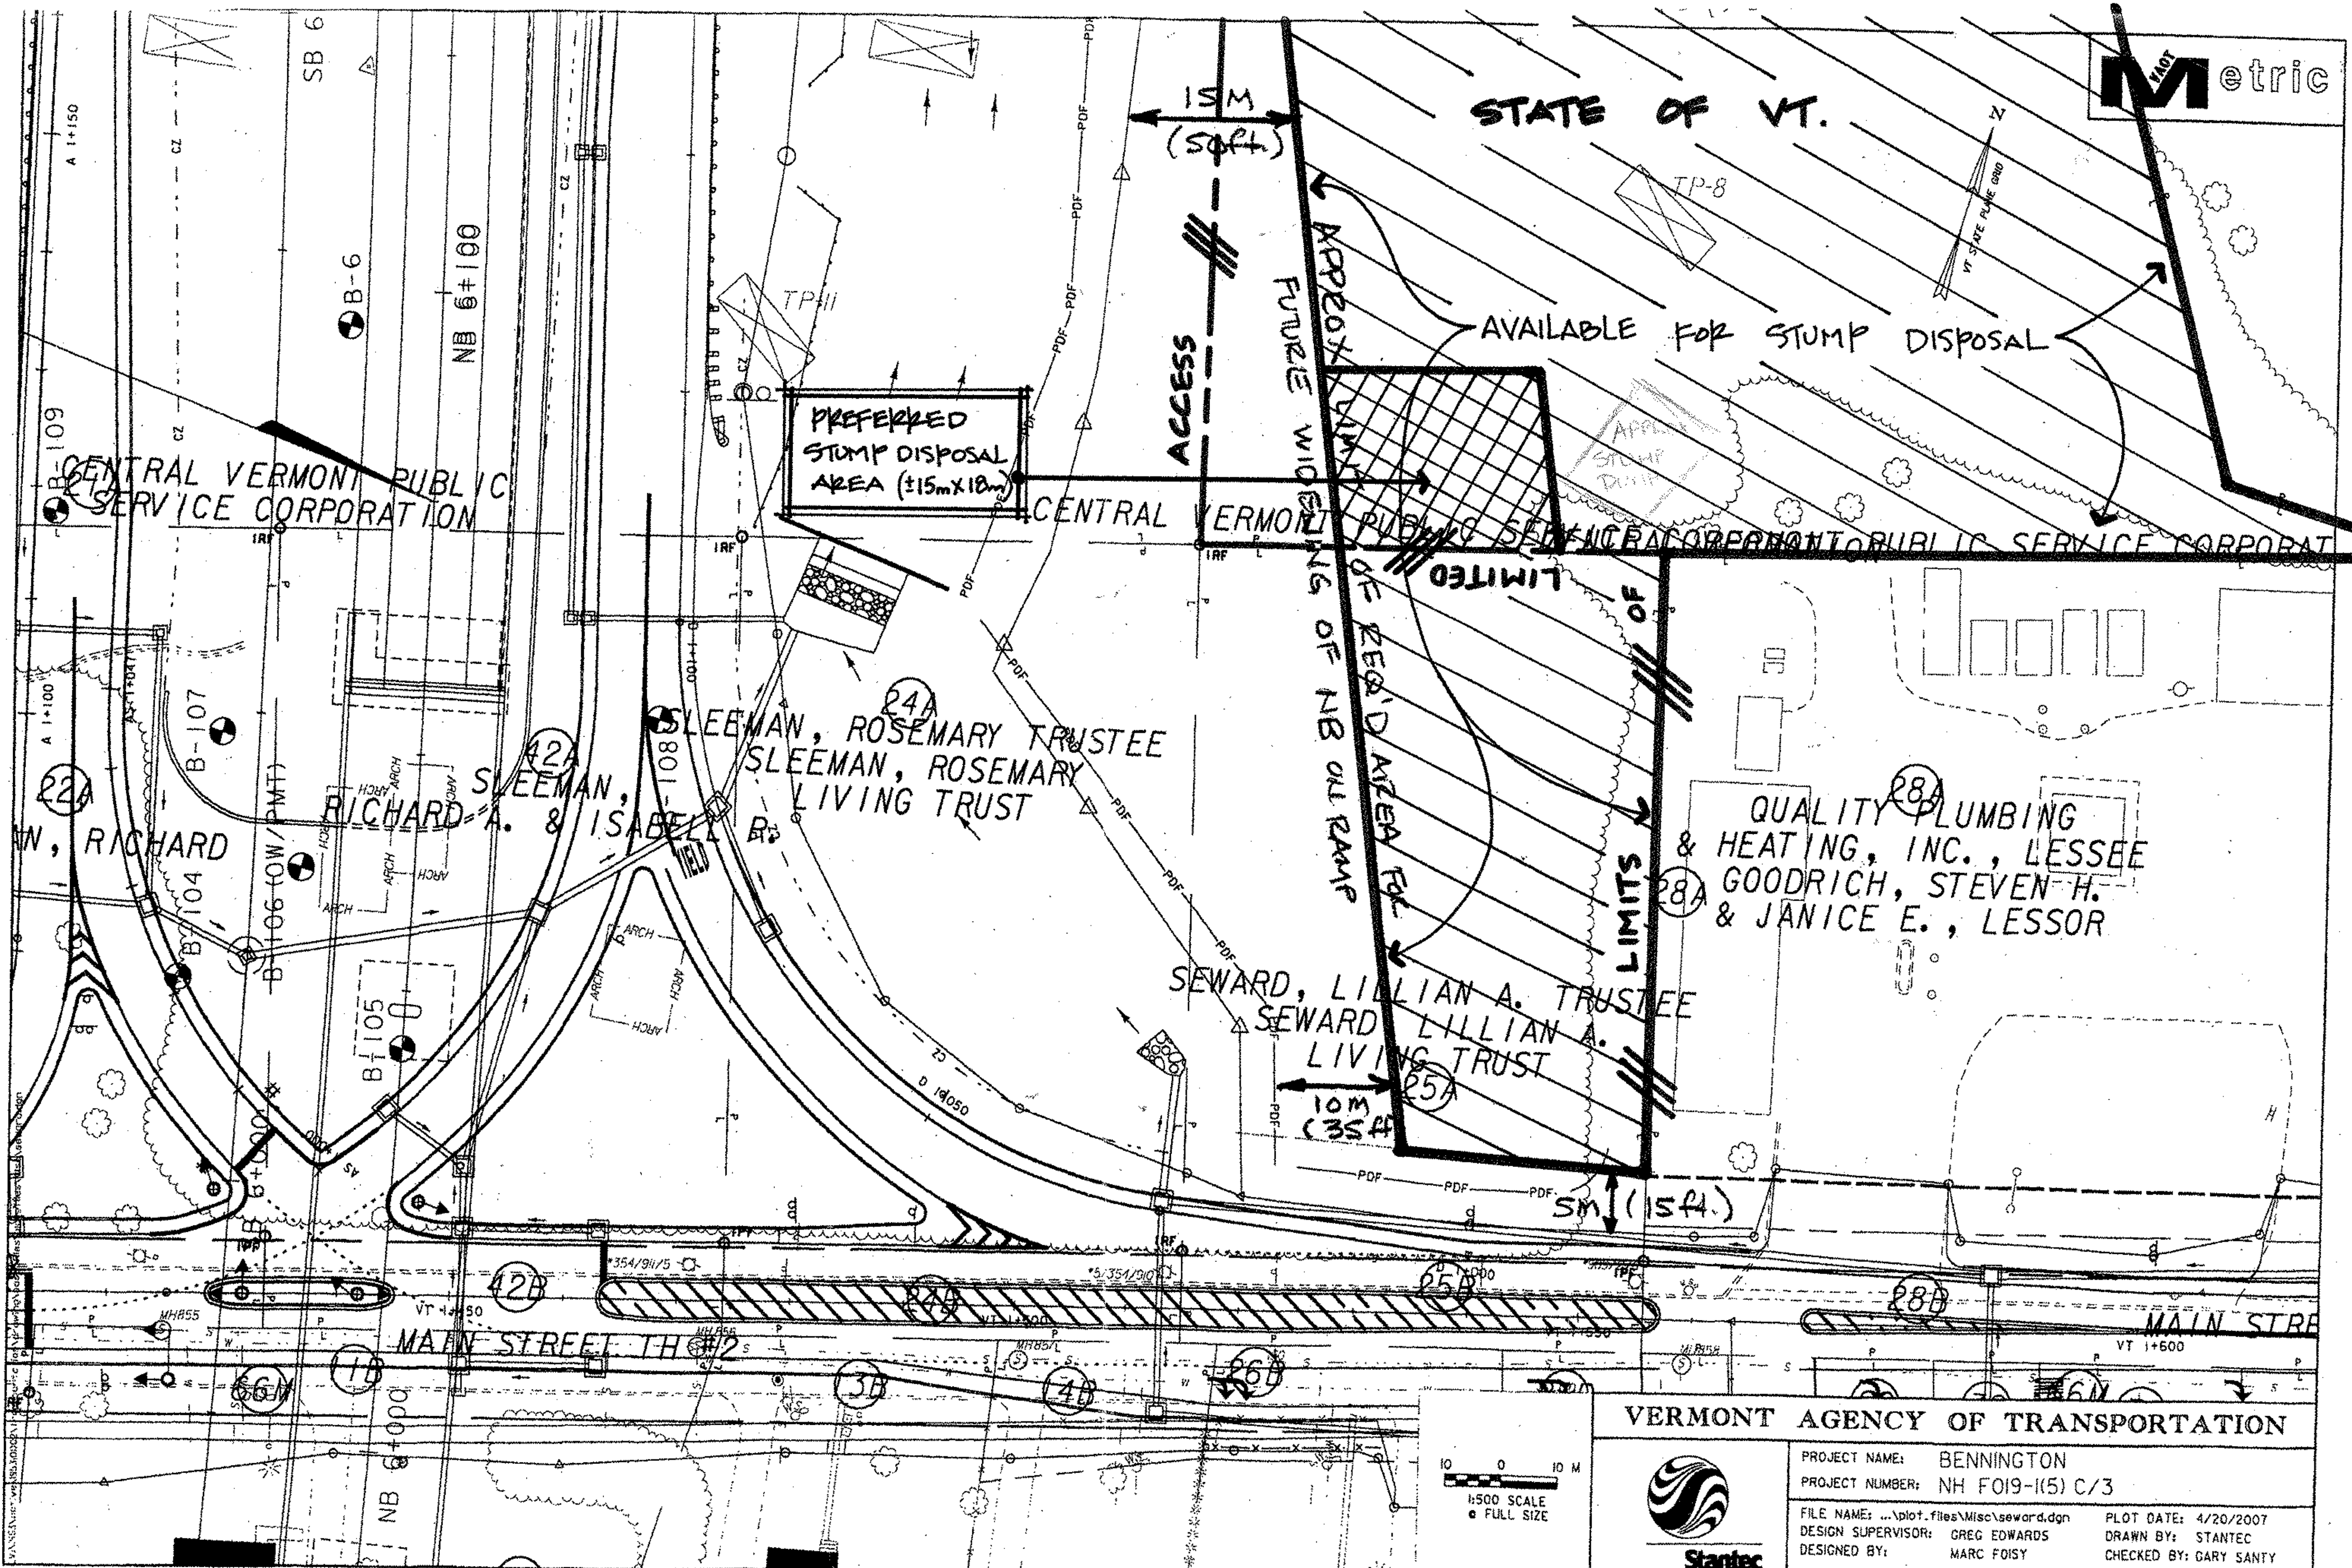

PROJECT NAME:	BENNINGTON	PLOT DATE:	4/20/2007
PROJECT NUMBER:	NH FO19-1(5) C/3	DRAWN BY:	STANTEC
FILE NAME:	...plot_files\Misc\seward.dgn	CHECKED BY:	GARY SANTY
DESIGN SUPERVISOR:	GREG EDWARDS	SHEET	OF
DESIGNED BY:	MARC FOISY		

