



BL 2+060

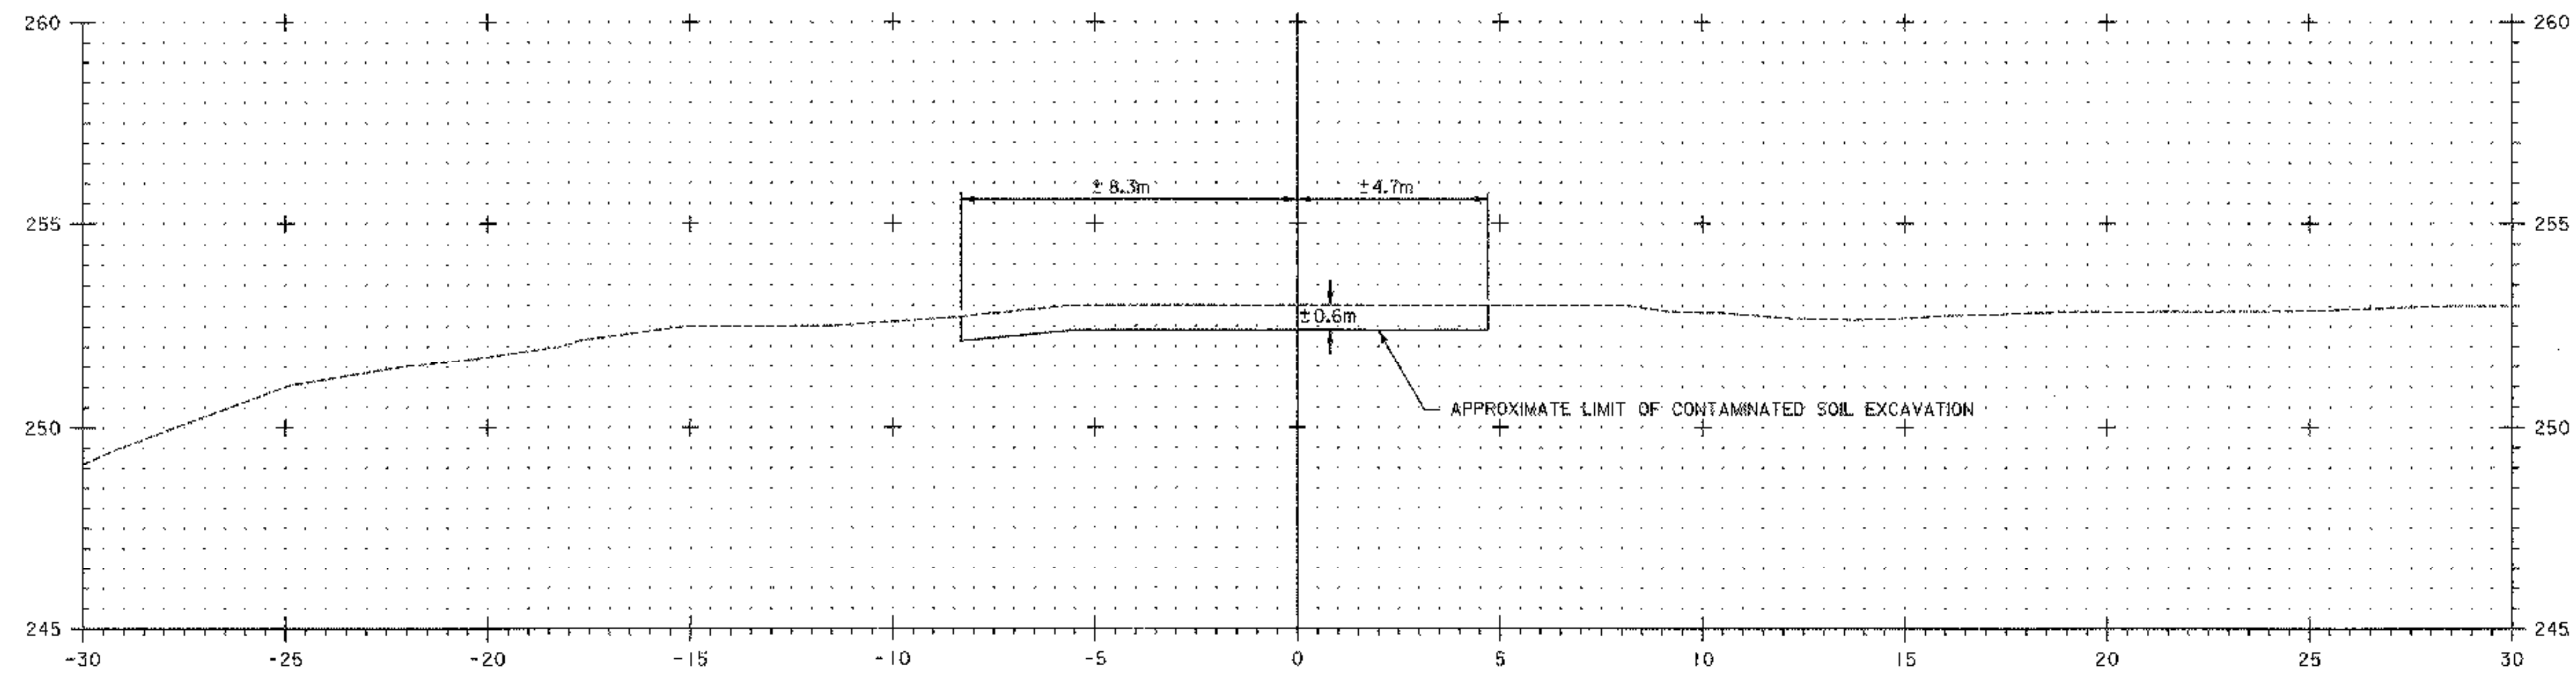

BL 2+040

SEE PROJECT FILES

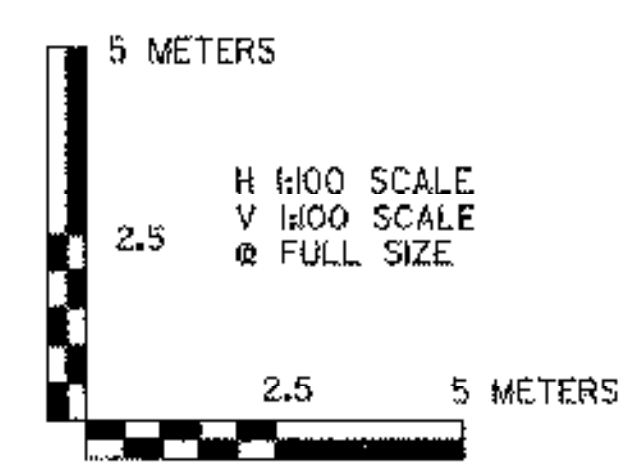

VERMONT AGENCY OF TRANSPORTATION	
	PROJECT NAME: BENNINGTON PROJECT NUMBER: NH 019-1(55)
	FILE NAME: ...z307c5xs_baseline.ptf DESIGN SUPERVISOR: GREG EDWARDS DESIGNED BY: MARC FOISY BASELINE CROSS SECTIONS BL-02
PLOT DATE: 3/28/2008 DRAWN BY: STANTEC CHECKED BY: GARY SANTY SHEET 18 OF 19	

V:\9853\acrive\9853w002\transportation\drawing\cont\plot\plot_5\plot_5\files\z307c5xs_baseline.ptf