


604.412 REHAB DROP INLETS,  
CATCH BASINS OR MANHOLES

I+57 RT - NO WORK  
II+41RT  
I2+26 RT - NO WORK  
I2+41LT - NO WORK

SCOPE OF WORK:  
COLD PLANING & RESURFACING, PAVEMENT MARKINGS  
& OTHER INCIDENTALS

12/20/10  
S. HUNT

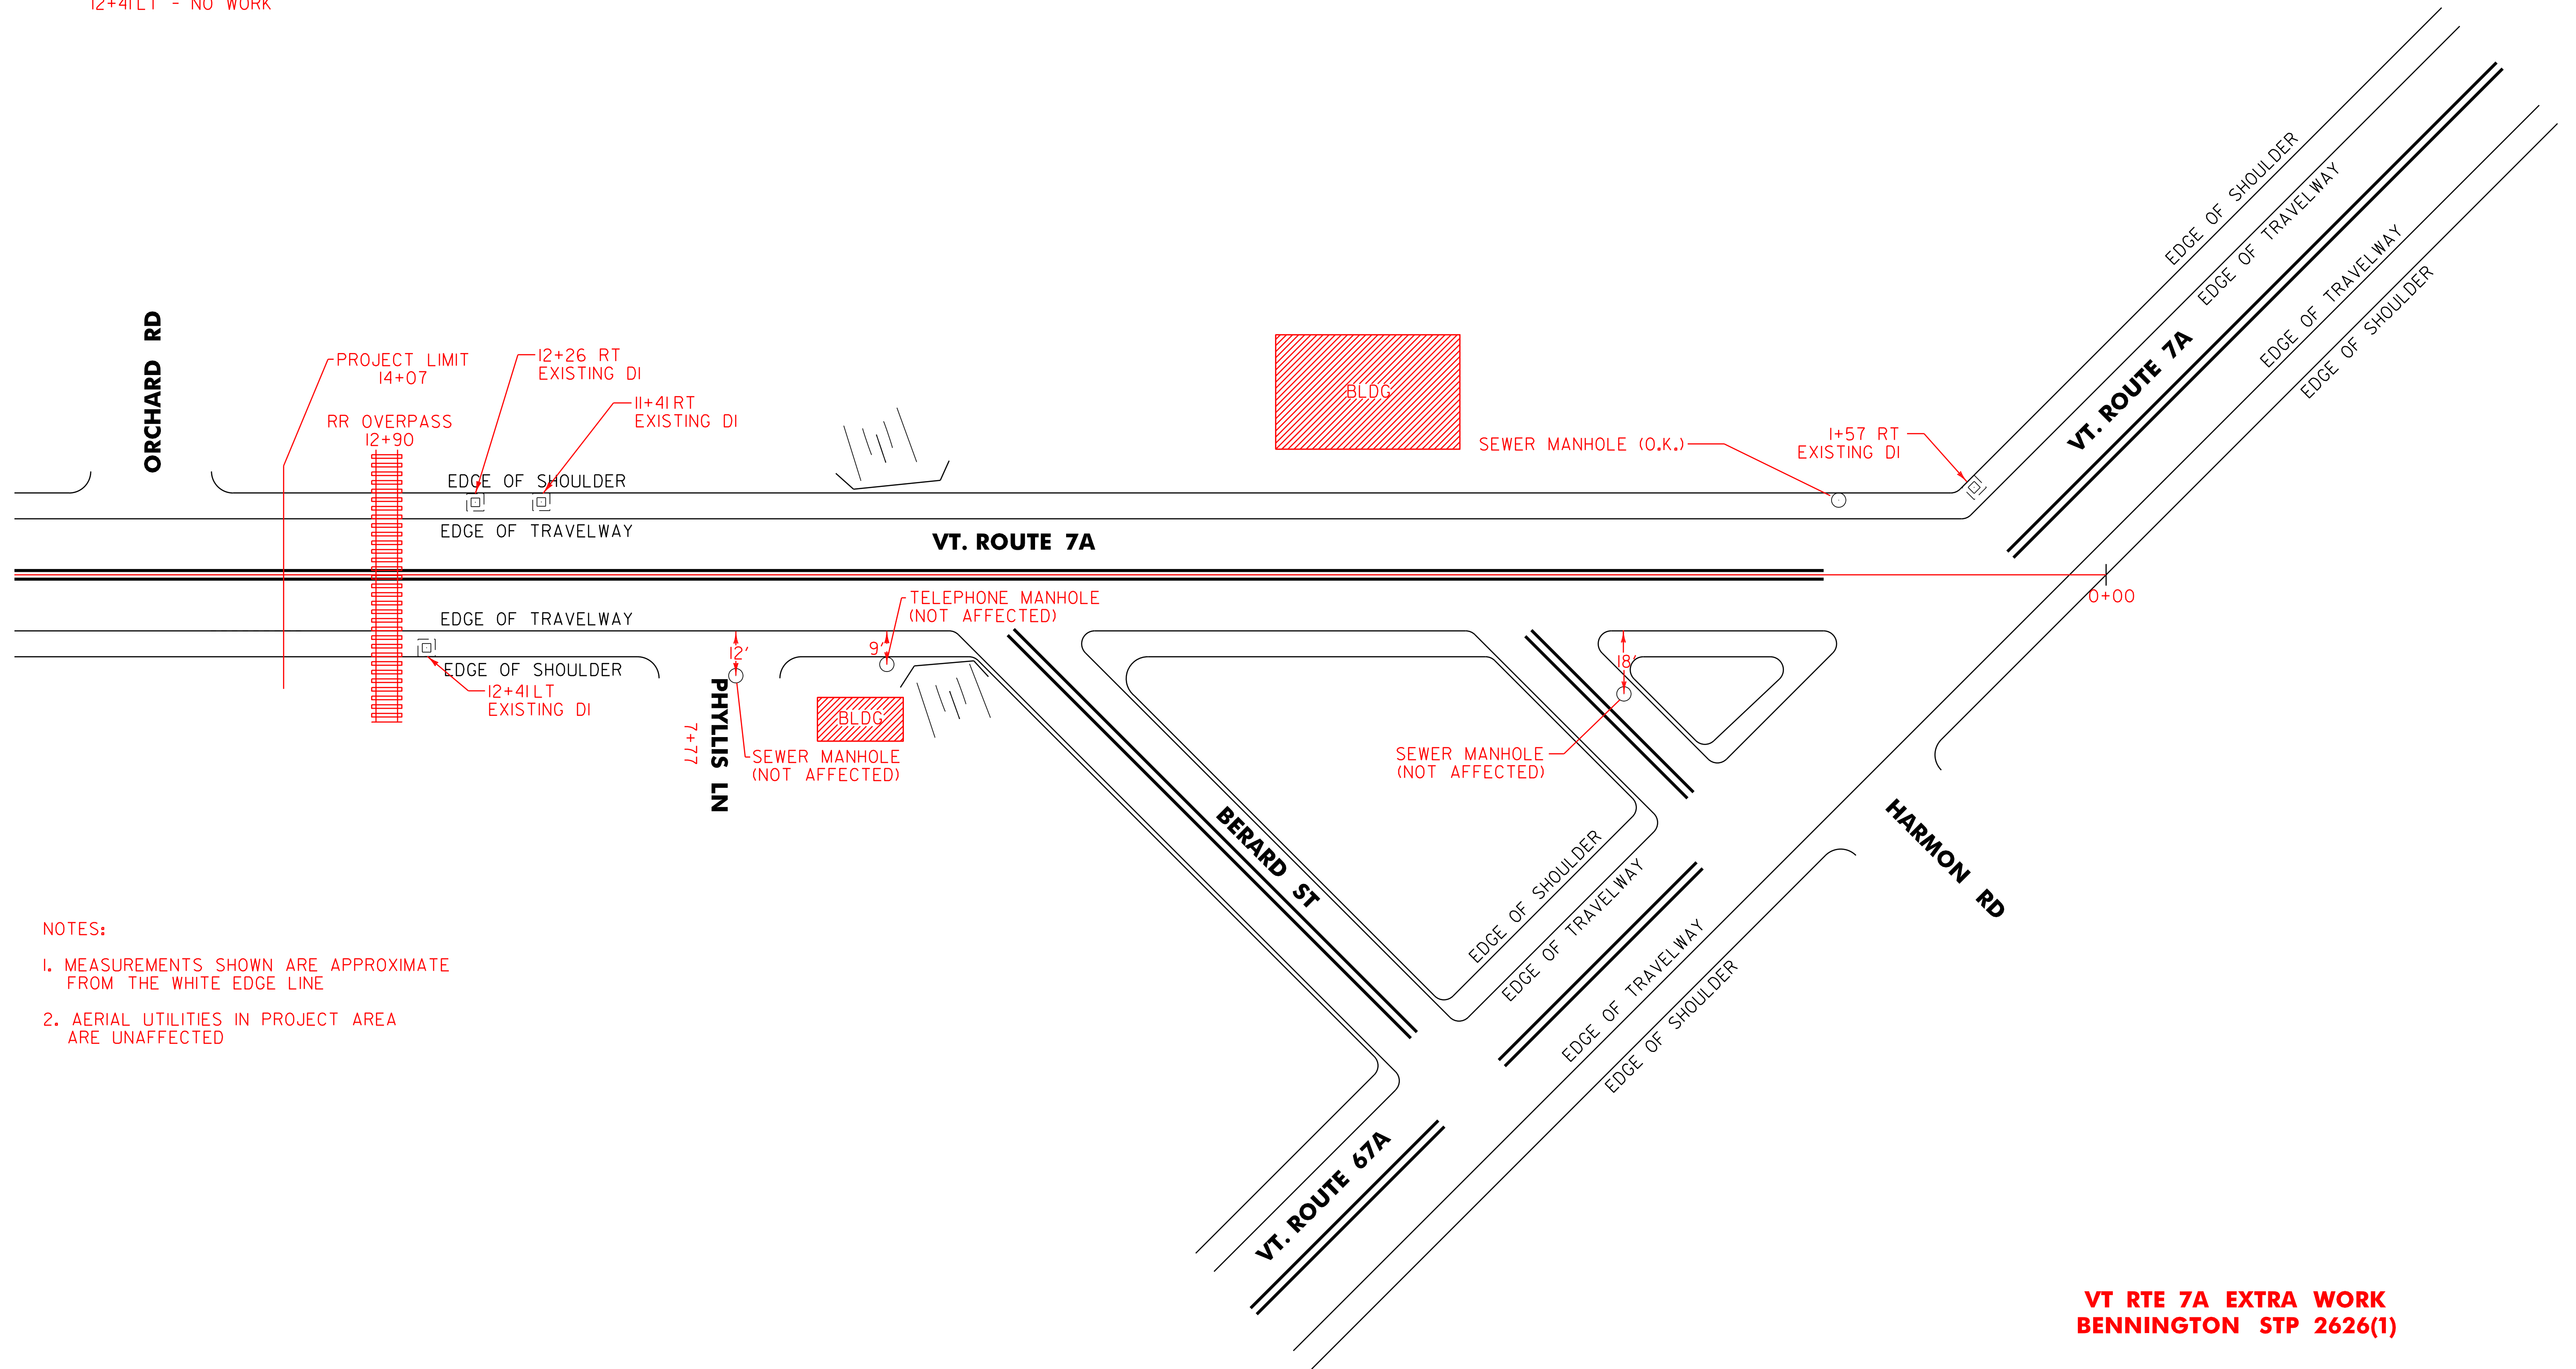

NOTES:

1. MEASUREMENTS SHOWN ARE APPROXIMATE FROM THE WHITE EDGE LINE
2. AERIAL UTILITIES IN PROJECT AREA ARE UNAFFECTED

**VT RTE 7A EXTRA WORK  
BENNINGTON STP 2626(1)**

NOT TO SCALE

<b>PROJECT LAYOUT SHEET</b>	PROJECT NAME: BENNINGTON (EXTRA WORK)	
	PROJECT NUMBER: STP 2626(1)	
	FILE NAME: p06b220.dgn	PLOT DATE: 07-MAY-2012 14:2
	PROJECT LEADER:	DRAWN BY:
DESIGNED BY:	CHECKED BY:	
DWG. NO. p06b212+cp.i	SHEET 18A	OF 69