

646.402 DURABLE 4 INCH WHITE LINE, THERMOPLASTIC
 (ALL LINES WILL INCLUDE EDGE LINE BREAKS AND RADIUS FOR TOWN HIGHWAYS)
 VT. ROUTE 67A:
 STA 5+50.00 - STA 10+00.00 EDGE LINE LT/RT
 STA 5+50.00 - STA 6+95.00 DOTTED LANE LINE RT
 STA 6+95.00 - STA 8+40.00 SOLID LANE LINE RT

646.602 TEMPORARY 4 INCH WHITE LINE, PAINT
 (ALL LINES WILL INCLUDE EDGE LINE BREAKS AND RADIUS FOR TOWN HIGHWAYS)
 VT. ROUTE 67A:
 STA 5+50.00 - STA 10+00.00 EDGE LINE LT/RT
 STA 5+50.00 - STA 6+95.00 DOTTED LANE LINE RT
 STA 6+95.00 - STA 8+40.00 SOLID LANE LINE RT

646.492 DURABLE LETTER OR SYMBOL, THERMOPLASTIC
 VT. ROUTE 67A:
 STA 7+01.00 RT ARROW (1 EA)
 STA 7+45.50 RT "O,N,L,Y" (4 EA)
 STA 7+92.00 RT ARROW (1 EA)
 STA 8+44.80 LT, TH-102, "S,T,O,P" (4 EA)

646.692 TEMPORARY LETTER OR SYMBOL, PAINT
 VT. ROUTE 67A:
 STA 7+01.00 RT ARROW (2 EA)
 STA 7+92.00 RT ARROW (2 EA)
 STA 8+44.80 LT, TH-102, "S,T,O,P" (8 EA)


675.50 REMOVING SIGNS AS SHOWN - 13
 675.60 ERECTING SALVAGED SIGNS AS SHOWN - 2

646.412 DURABLE 4 INCH YELLOW LINE, THERMOPLASTIC
 (ALL LINES WILL INCLUDE C/L BREAKS FOR TOWN HIGHWAYS) S=SOLID, D=DASHED
 VT. ROUTE 67A:
 STA 5+50.00 - STA 10+00.00 MEDIAN EDGE LINE LT/RT
 STA 8+44.80 DOUBLE SOLID LT, TH-102

646.612 TEMPORARY 4 INCH YELLOW LINE, PAINT
 (ALL LINES WILL INCLUDE C/L BREAKS FOR TOWN HIGHWAYS) S=SOLID, D=DASHED
 VT. ROUTE 67A:
 STA 5+50.00 - STA 10+00.00 MEDIAN EDGE LINE LT/RT
 STA 8+44.80 DOUBLE SOLID LT, TH-102

646.482 DURABLE 24 INCH STOP BAR, THERMOPLASTIC
 VT. ROUTE 67A:
 STA 8+44.80 LT, TH-102

646.682 TEMPORARY 24 INCH STOP BAR, PAINT
 VT. ROUTE 67A:
 STA 8+44.80 LT, TH-102

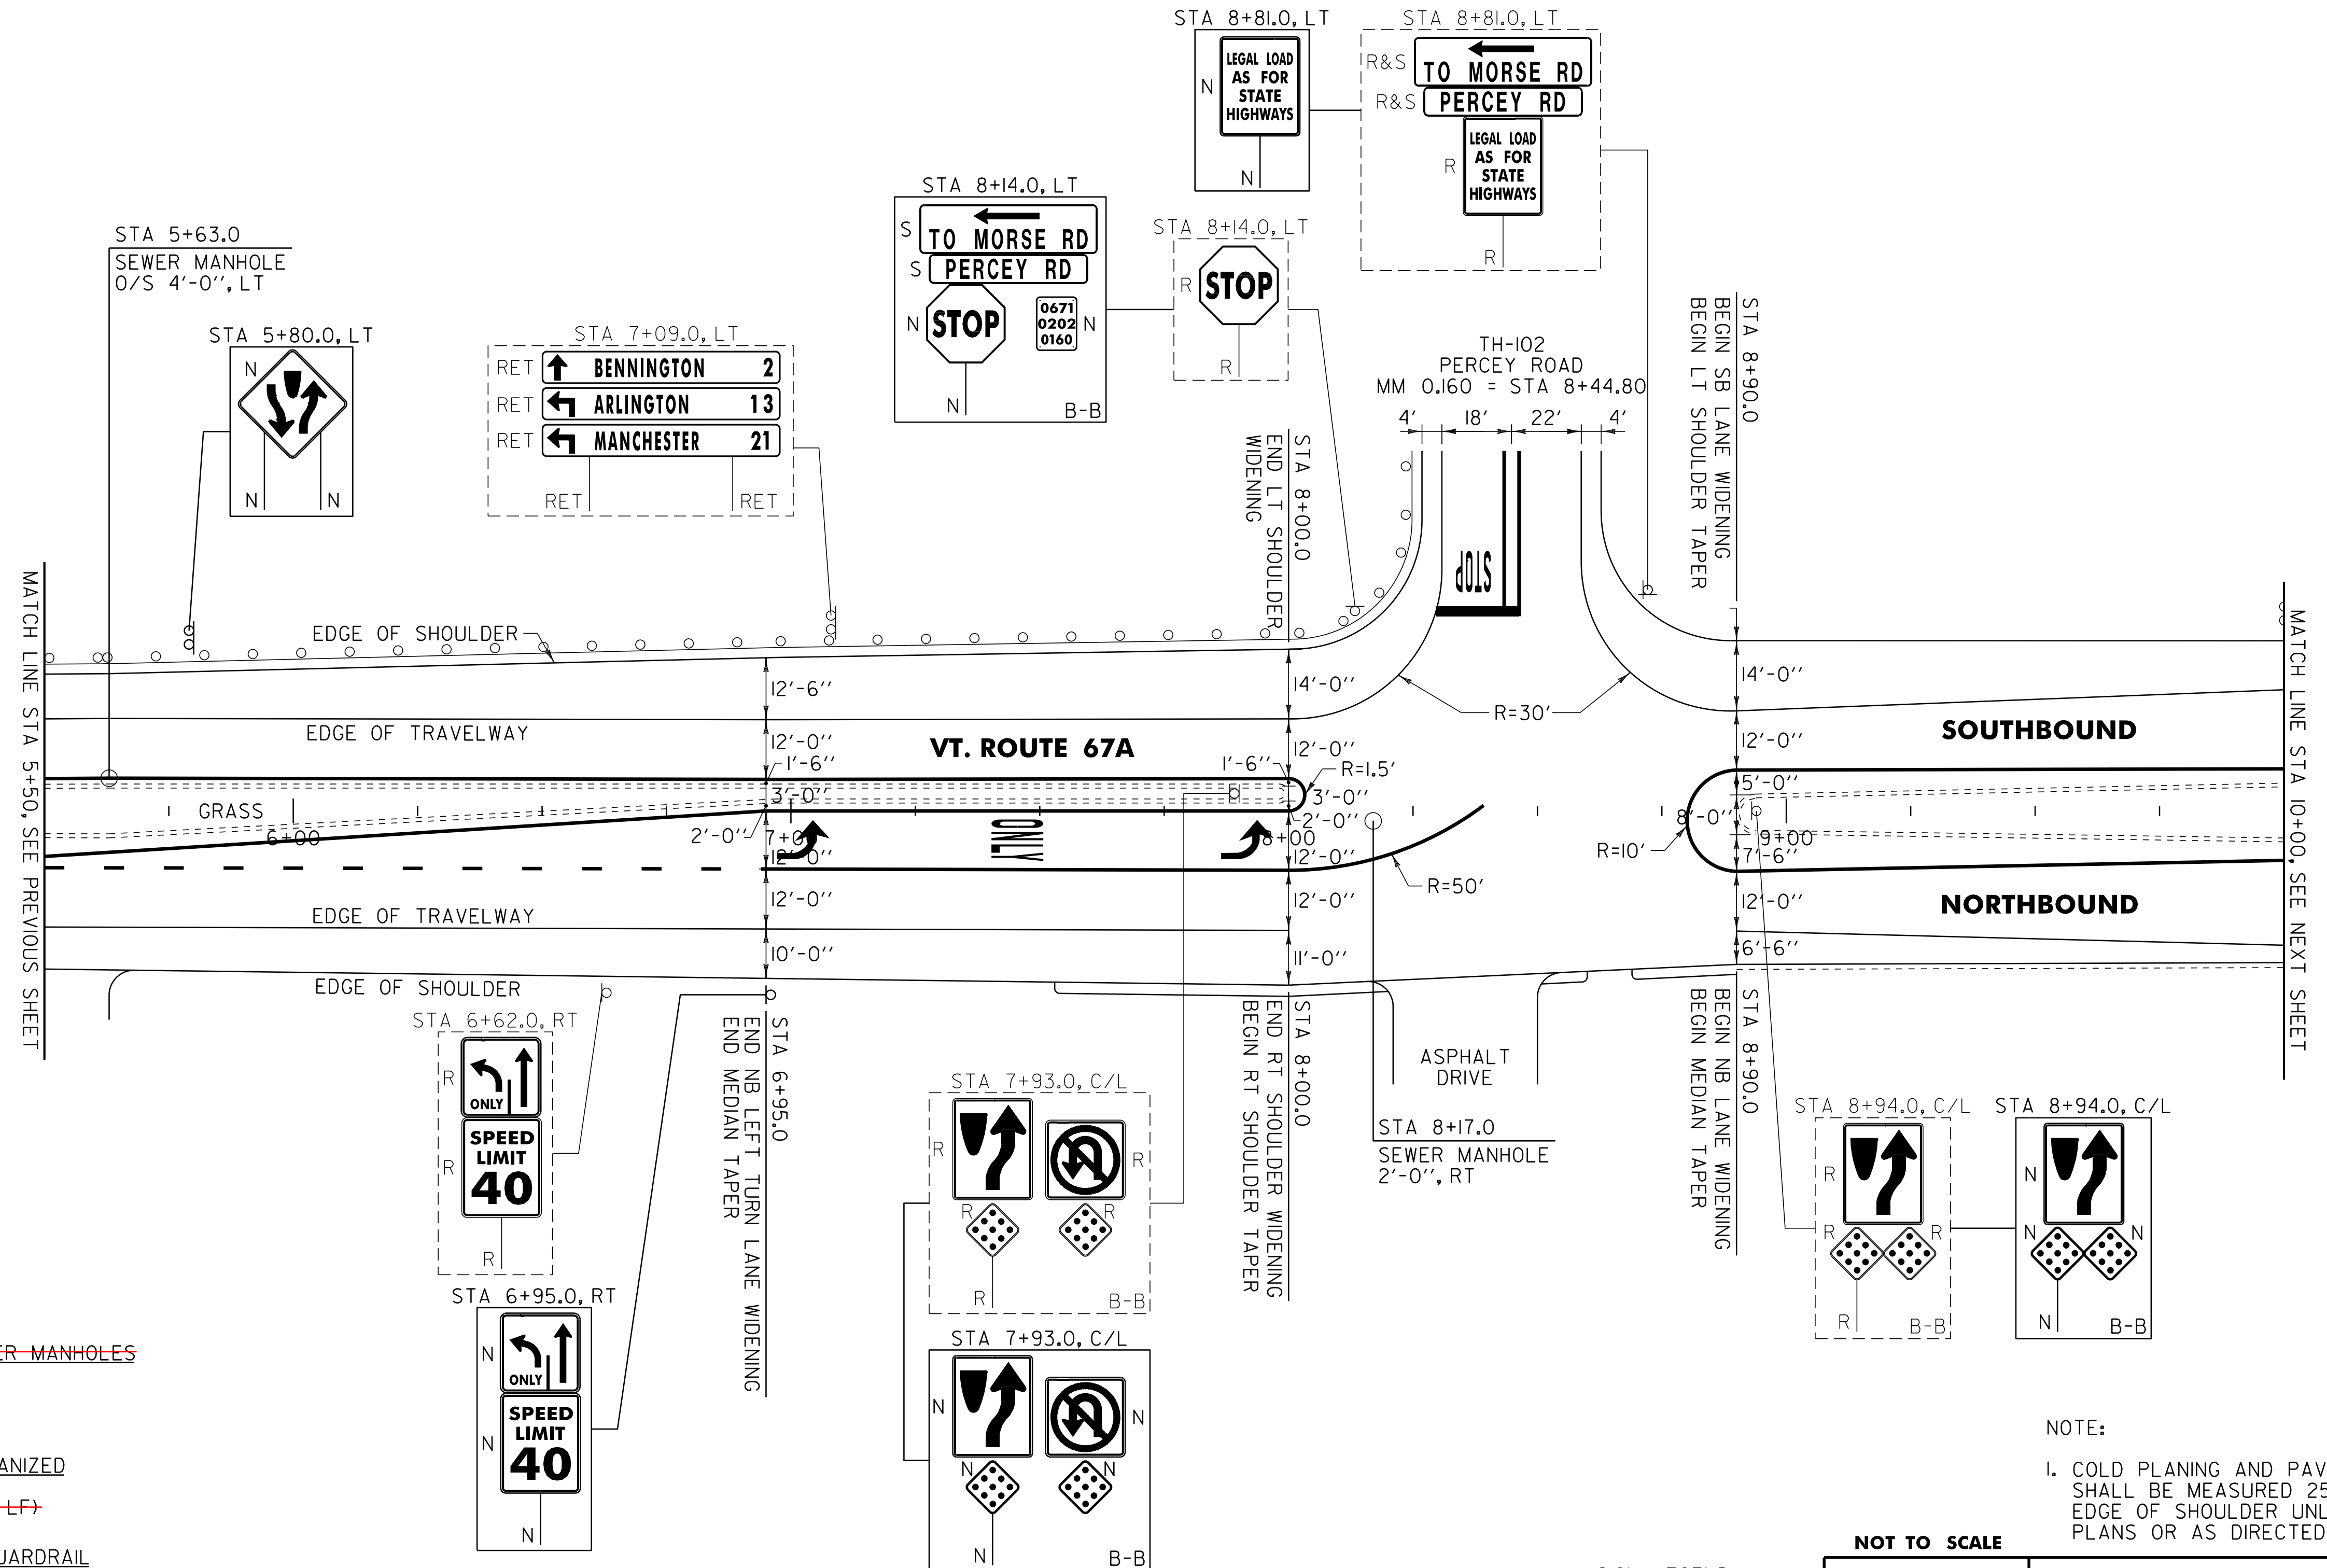

~~604.42 CHANGING ELEVATION OF SEWER MANHOLES~~
 VT. ROUTE 67A:
 STA 5+63.0 LT
 STA 8+17.0 RT
 SEE NOTE, SHEET 19

621.20 STEEL BEAM GUARDRAIL, GALVANIZED
 VT. ROUTE 67A:
 STA 5+50.0 - STA 8+22.0 LT (412.5 LF)
 8+28.0

621.80 REMOVAL AND DISPOSAL OF GUARDRAIL
 VT. ROUTE 67A:
 STA 5+50.0 - STA 8+22.0 LT (407.0 LF)
 8+28.0

646.81 PAINTED CURB
 VT. ROUTE 67A:
 STA 5+50.0 - STA 5+95.0 RT (45.0 LF)
 STA 6+65.0 - STA 8+00.0 LT (273.0 LF)
 STA 8+90.0 - STA 9+20.0 LT/RT (68.0 LF)

NOTE:
 1. COLD PLANING AND PAVING LIMIT ON ALL TOWN HIGHWAYS SHALL BE MEASURED 25 FT BACK FROM VT. ROUTE 67A EDGE OF SHOULDER UNLESS DENOTED OTHERWISE ON THE PLANS OR AS DIRECTED BY THE RESIDENT ENGINEER.

SIGN LEGEND
 R = REMOVE
 S = SALVAGE
 N = NEW
 RET = RETAIN
 B-B = BACK TO BACK
 EXISTING = - - - - -
 NEW = _____

PROJECT LAYOUT SHEET #2	PROJECT NAME: BENNINGTON	PLOT DATE: 07-MAY-2012 14:2
	PROJECT NUMBER: STP 2626(1)	DRAWN BY: C.A.K.
	FILE NAME: p06b220.dgn	CHECKED BY: D.E.G.
	PROJECT LEADER: D.E.G.	DWG. NO. p06b220i02.i
	DESIGNED BY: M.J.L.	SHEET 20 OF 69

NOT TO SCALE