

646.402 DURABLE 4 INCH WHITE LINE, THERMOPLASTIC  
 (ALL LINES WILL INCLUDE EDGE LINE BREAKS AND RADIUS FOR TOWN HIGHWAYS)  
 VT. ROUTE 67A:  
 STA 10+00.00 - STA 15+00.00 EDGE LINE LT/RT  
 STA 12+20.00 - STA 15+00.00 DASHED LANE LINE RT  
 STA 13+00.00 - STA 14+80.00 DOTTED LANE LINE RT  
 STA 13+00.00 - STA 14+80.00 DOTTED LANE LINE RT  
 STA 13+65.00 - STA 15+00.00 DASHED LANE LINE LT  
 STA 14+80.00 - STA 15+00.00 SOLID LANE LINE RT  
 STA 14+80.00 - STA 15+00.00 SOLID LANE LINE RT


646.602 TEMPORARY 4 INCH YELLOW LINE, PAINT  
 (ALL LINES WILL INCLUDE EDGE LINE BREAKS AND RADIUS FOR TOWN HIGHWAYS)  
 VT. ROUTE 67A:  
 STA 10+00.00 - STA 15+00.00 EDGE LINE LT/RT  
 STA 12+20.00 - STA 15+00.00 DASHED LANE LINE RT  
 STA 13+00.00 - STA 14+80.00 DOTTED LANE LINE RT  
 STA 13+00.00 - STA 14+80.00 DOTTED LANE LINE RT  
 STA 13+65.00 - STA 15+00.00 DASHED LANE LINE LT  
 STA 14+80.00 - STA 15+00.00 SOLID LANE LINE RT  
 STA 14+80.00 - STA 15+00.00 SOLID LANE LINE RT

646.492 DURABLE LETTER OR SYMBOL, THERMOPLASTIC  
 VT. ROUTE 67A:  
 STA 14+82.00 C/L ARROW (1EA)  
 STA 14+82.00 RT ARROW (1EA)  
 646.692 TEMPORARY LETTER OR SYMBOL, PAINT  
 VT. ROUTE 67A:  
 STA 14+82.00 C/L ARROW (2 EA)  
 STA 14+82.00 RT ARROW (2 EA)

646.412 DURABLE 4 INCH YELLOW LINE, THERMOPLASTIC  
 (ALL LINES WILL INCLUDE C/L BREAKS FOR TOWN HIGHWAYS) S=SOLID, D=DASHED  
 VT. ROUTE 67A:  
 STA 10+00.00 - STA 15+00.00 MEDIAN EDGE LINE LT/RT

646.612 TEMPORARY 4 INCH YELLOW LINE, PAINT  
 (ALL LINES WILL INCLUDE C/L BREAKS FOR TOWN HIGHWAYS) S=SOLID, D=DASHED  
 VT. ROUTE 67A:  
 STA 10+00.00 - STA 15+00.00 MEDIAN EDGE LINE LT/RT

646.442 DURABLE 8 INCH WHITE LINE, THERMOPLASTIC  
 VT. ROUTE 67A:  
 STA 10+25.0 - STA 10+37.0 FIRE HYDRANT, NO PARKING, RT

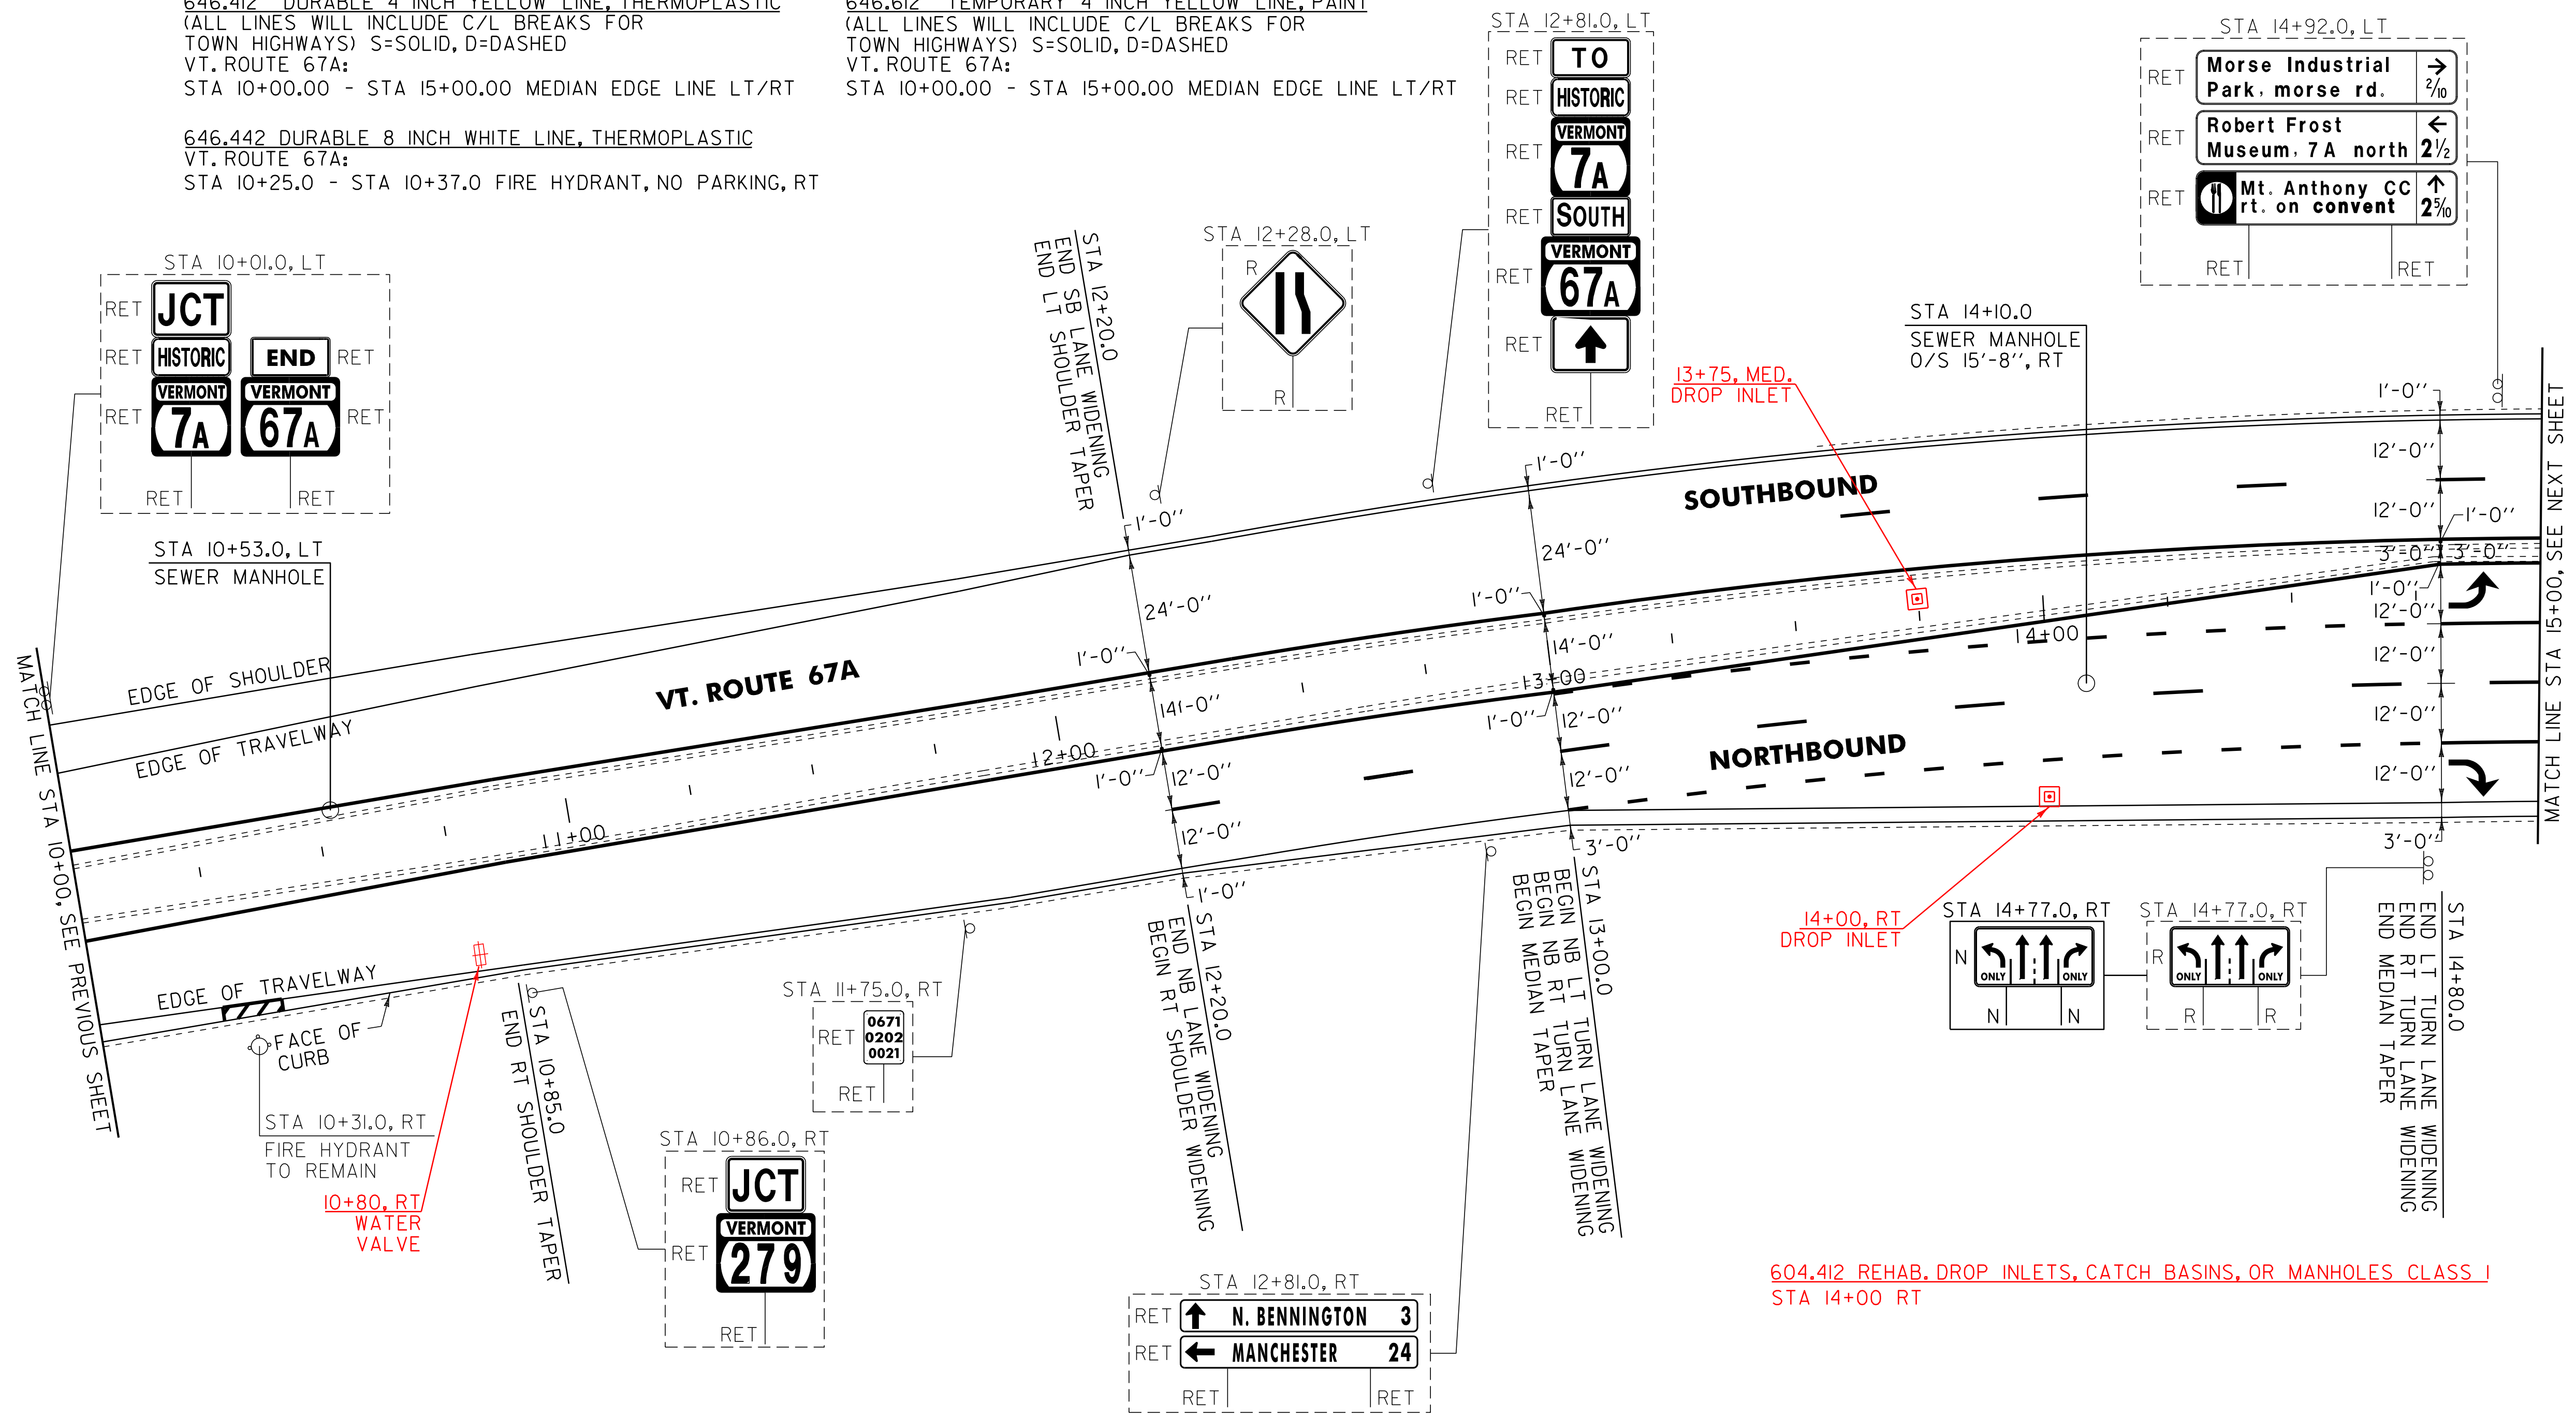

604.42 CHANGING ELEVATION OF SEWER MANHOLES  
 VT. ROUTE 67A:  
 STA 10+53.0 LT  
 STA 14+10.0 RT  
 • SEE NOTE SHEET 19

646.81 PAINTED CURB  
 VT. ROUTE 67A:  
 STA 12+70.0 - STA 13+30.0 LT (60.0 LF)  
 STA 12+70.0 - STA 13+30.0 RT (60.0 LF)  
 STA 14+50.0 - STA 15+00.0 LT (100.0 LF)

SIGN LEGEND  
 R = REMOVE  
 S = SALVAGE  
 N = NEW  
 RET = RETAIN  
 B-B = BACK TO BACK  
 EXISTING = - - - - -  
 NEW = \_\_\_\_\_

NOTE:  
 1. SEE SHEET 8 FOR FIRE HYDRANT PAVEMENT MARKING DETAIL.

<b>PROJECT LAYOUT SHEET #3</b>	<b>NOT TO SCALE</b>		
	PROJECT NAME:	BENNINGTON	
	PROJECT NUMBER:	STP 2626(1)	
	FILE NAME:	p06b220.dgn	
PROJECT LEADER:	D.E.G.	PLOT DATE:	07-MAY-2012 14:2
DESIGNED BY:	M.J.L.	DRAWN BY:	C.A.K.
DWG. NO.	p06b220103.i	CHECKED BY:	D.E.G.
		SHEET	21 OF 69