

**646.402 DURABLE 4 INCH WHITE LINE, THERMOPLASTIC**  
 (ALL LINES WILL INCLUDE EDGE LINE BREAKS AND RADIUS FOR TOWN HIGHWAYS)  
 VT. ROUTE 67A:  
 STA 15+00.00 - STA 20+00.00 EDGE LINE LT/RT  
 STA 15+00.00 - STA 16+29.00 DASHED LANE LINE LT  
 STA 15+00.00 - STA 16+29.00 SOLID LANE LINE RT  
 STA 15+00.00 - STA 16+29.00 DASHED LANE LINE RT  
 STA 15+00.00 - STA 16+29.00 SOLID LANE LINE RT  
 STA 16+79.04 SOLID LANE LINE LT, VT ROUTE 279 EB  
 STA 16+84.32 SOLID LANE LINE RT, TH-I13  
 STA 17+09.00 - STA 17+60.00 SOLID EDGE LINE LT  
 STA 17+42.00 - STA 19+05.00 SOLID LANE LINE LT  
 STA 17+42.00 - STA 20+00.00 DASHED LANE LINE LT  
 STA 17+42.00 - STA 20+00.00 DASHED LANE LINE RT  
 STA 18+45.00 - STA 19+05.00 SOLID EDGE LINE LT  
 STA 19+05.00 - STA 20+00.00 DOTTED LANE LINE LT  
 STA 19+05.00 - STA 20+00.00 DOTTED LANE LINE RT

**646.442 DURABLE 8 INCH WHITE LINE, THERMOPLASTIC**  
 (ALL LINES WILL INCLUDE EDGE LINE BREAKS AND RADIUS FOR TOWN HIGHWAYS)  
 VT. ROUTE 67A:  
 STA 17+60.0 - STA 17+95.0 GORE HATCHING LT  
 STA 17+60.0 - STA 18+45.0 GORE AREA EDGE LINE LT  
**646.452 DURABLE 8 INCH YELLOW LINE, THERMOPLASTIC**  
 (ALL LINES WILL INCLUDE EDGE LINE BREAKS AND RADIUS FOR TOWN HIGHWAYS)  
 VT. ROUTE 67A:  
 STA 17+10.0 - STA 17+60.0 SLIP RAMP HATCHING LT  
**675.50 REMOVING SIGNS**  
 AS SHOWN - 18  
**675.60 ERECTING SALVAGED SIGNS**  
 AS SHOWN - 1


**646.412 DURABLE 4 INCH YELLOW LINE, THERMOPLASTIC**  
 (ALL LINES WILL INCLUDE C/L BREAKS FOR TOWN HIGHWAYS) S=SOLID, D=DASHED  
 VT. ROUTE 67A:  
 STA 15+00.0 - STA 20+00.00 MEDIAN EDGE LINE LT  
 STA 16+79.04 MEDIAN EDGE LINE LT, VT ROUTE 279 EB  
 STA 16+84.32 MEDIAN EDGE LINE RT, TH-I13  
 STA 17+10.00 - STA 17+60.00 SLIP RAMP EDGE LINE LT  
 STA 17+42.00 - STA 20+00.00 MEDIAN EDGE LINE LT/RT  
**646.482 DURABLE 24 INCH STOP BAR, THERMOPLASTIC**  
 VT. ROUTE 67A:  
 STA 16+29.00 LT/RT  
 STA 16+79.04 LT, VT ROUTE 279 EB  
 STA 16+84.32 RT, TH-I13  
 STA 17+42.0 LT

**646.492 DURABLE LETTER OR SYMBOL, THERMOPLASTIC**  
 VT. ROUTE 67A:  
 STA 15+14.0 C/L "O,N,L,Y" (4 EA)  
 STA 15+14.0 RT "O,N,L,Y" (4 EA)  
 STA 16+16.0 RT ARROW (1 EA)  
 STA 16+20.0 C/L ARROW (1 EA)  
 STA 16+79.04 LT, VT ROUTE 279 EB ARROW (1 EA)  
 STA 16+79.04 LT, VT ROUTE 279 EB ARROW (2 EA)  
 STA 16+84.32 RT, TH-I13 ARROW (1 EA)  
 STA 16+84.32 RT, TH-I13 "O,N,L,Y" (4 EA)  
 STA 16+84.32 RT, TH-I13 ARROW (2 EA)  
 STA 17+30.0 LT YIELD LINE (6 EA)  
 STA 17+51.0 LT ARROW (1 EA)  
 STA 18+69.0 LT "O,N,L,Y" (4 EA)  
 STA 18+59.0 LT ARROW (1 EA)  
 STA 19+01.0 LT ARROW (1 EA)  
 STA 19+01.0 LT ARROW (1 EA)

**646.612 TEMPORARY 4 INCH YELLOW LINE, PAINT**  
 (ALL LINES WILL INCLUDE C/L BREAKS FOR TOWN HIGHWAYS) S=SOLID, D=DASHED  
 VT. ROUTE 67A:  
 STA 15+00.0 - STA 20+00.00 MEDIAN EDGE LINE LT  
 STA 16+79.04 MEDIAN EDGE LINE LT, VT ROUTE 279 EB  
 STA 16+84.32 MEDIAN EDGE LINE RT, TH-I13  
 STA 17+10.00 - STA 17+60.00 SLIP RAMP EDGE LINE LT  
 STA 17+42.00 - STA 20+00.00 MEDIAN EDGE LINE LT/RT  
**646.682 TEMPORARY 24 INCH STOP BAR, PAINT**  
 VT. ROUTE 67A:  
 STA 16+29.00 LT/RT  
 STA 16+79.04 LT, VT ROUTE 279 EB  
 STA 16+84.32 RT, TH-I13  
 STA 17+42.0 LT

**646.692 TEMPORARY LETTER OR SYMBOL, PAINT**  
 VT. ROUTE 67A:  
 STA 16+16.0 RT ARROW (2 EA)  
 STA 16+20.0 C/L ARROW (2 EA)  
 STA 16+79.04 LT VT ROUTE 279 EB, ARROW (4 EA)  
 STA 16+79.04 LT VT ROUTE 279 EB, ARROW (2 EA)  
 STA 16+84.32 RT TH-I13 ARROW (4 EA)  
 STA 16+84.32 RT ARROW (2 EA)  
 STA 17+30.0 LT YIELD LINE (12 EA)  
 STA 17+51.0 LT ARROW (2 EA)  
 STA 18+59.0 LT ARROW (2 EA)  
 STA 19+01.0 LT ARROW (2 EA)  
 STA 19+01.0 LT ARROW (2 EA)

~~604.412, 604.415, 604.418 REHAB. DROP INLETS, CATCH BASINS, OR MANHOLES CLASS I, II, OR III (SEE NOTE 2)~~  
 VT. ROUTE 67A:  
 STA 15+98.0 LT 16+30.0 LT  
 STA 16+94.0 LT NO WORK  
 STA 17+28.0 LT NO WORK  
 STA 18+15.0 LT NO WORK  
 STA 19+31.0 LT NO WORK  
~~629.20 ADJUST ELEVATION OF VALVE BOX~~  
 VT. ROUTE 67A:  
 STA 15+25.0 RT  
 STA 17+86.0 LT  
 \* SEE NOTE, SHEET 19

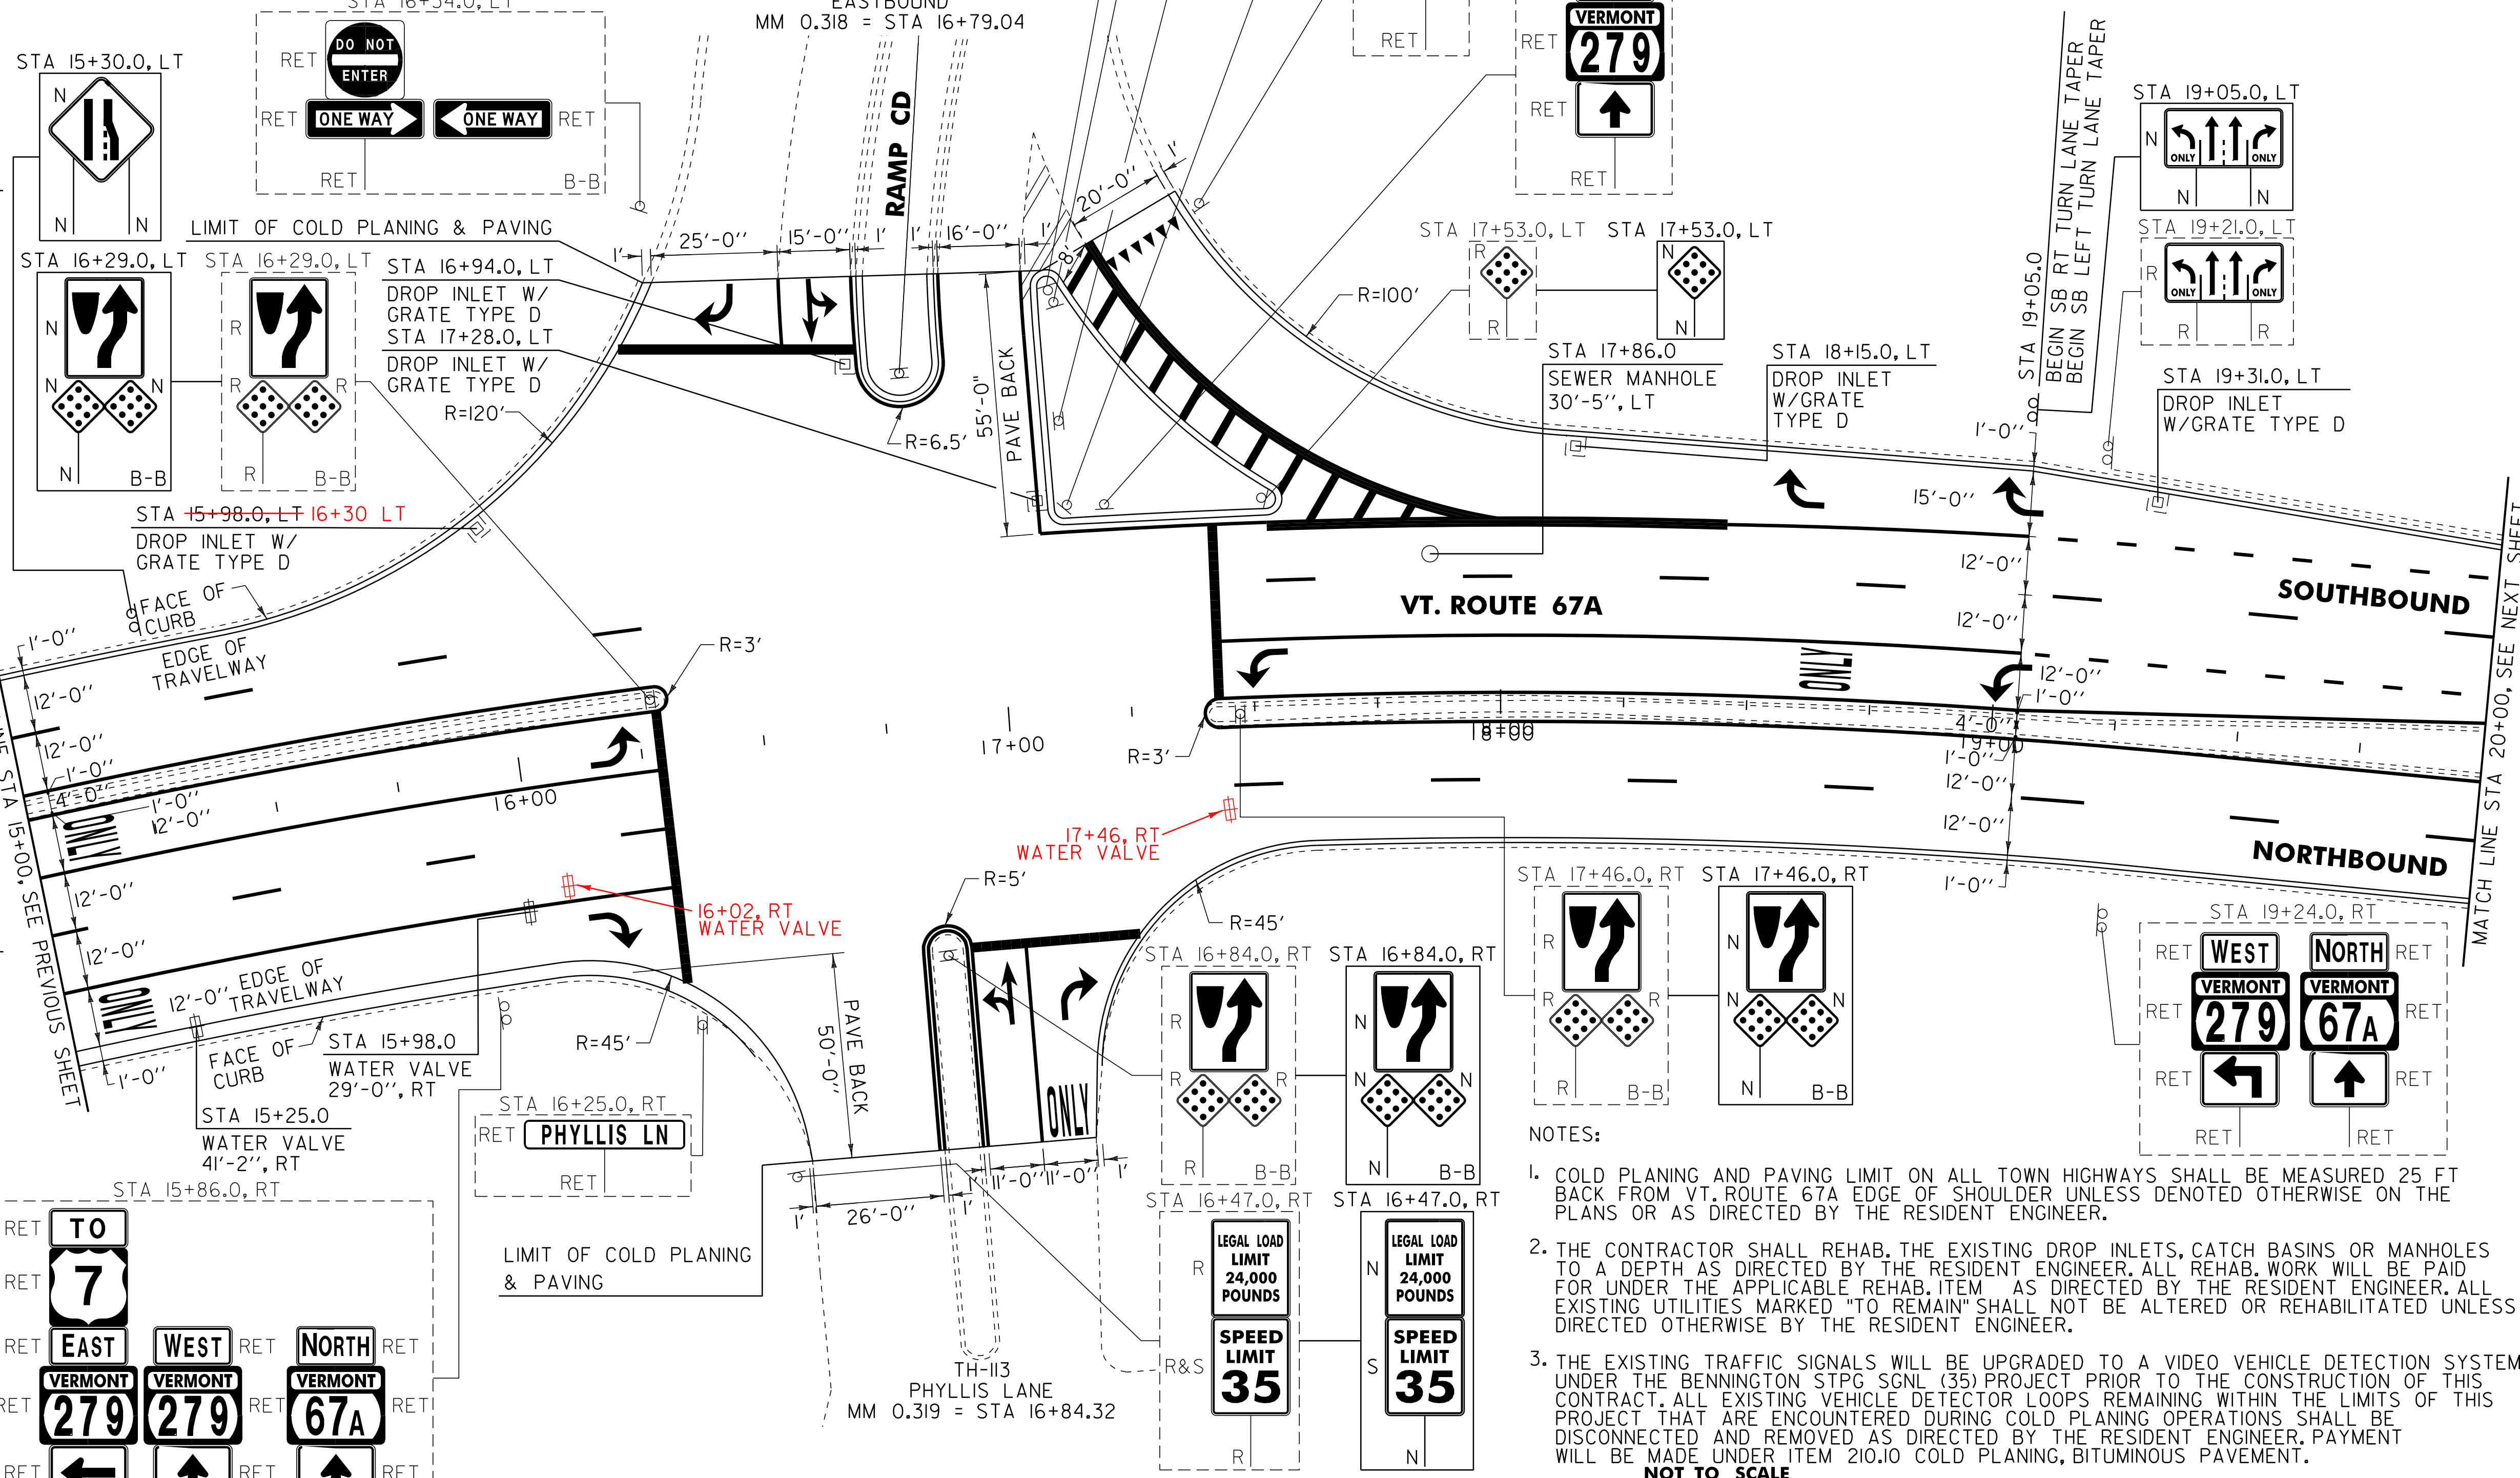

**646.81 PAINTED CURB**  
 VT. ROUTE 67A:  
 STA 15+00.0 - STA 16+30.0 LT (263.0 LF)  
 STA 16+79.04 LT, VT. ROUTE 279 (85.0 LF)  
 STA 16+84.32 RT, TH-I13 (70.0 LF)  
 STA 17+10.0 - STA 17+57.0 LT (164.0 LF)  
 STA 17+40.0 - STA 19+45.0 LT/RT (414.0 LF)

**646.81 PAINTED CURB**  
 VT. ROUTE 67A:  
 STA 15+00.0 - STA 16+30.0 LT (263.0 LF)  
 STA 16+79.04 LT, VT. ROUTE 279 (85.0 LF)  
 STA 16+84.32 RT, TH-I13 (70.0 LF)  
 STA 17+10.0 - STA 17+57.0 LT (164.0 LF)  
 STA 17+40.0 - STA 19+45.0 LT/RT (414.0 LF)

**SIGN LEGEND**  
 R = REMOVE  
 S = SALVAGE  
 N = NEW  
 RET = RETAIN  
 B-B = BACK TO BACK  
 EXISTING =   
 NEW =

**PROJECT LAYOUT SHEET #4**

**NOT TO SCALE**

PROJECT NAME: BENNINGTON	PROJECT NUMBER: STP 2626(1)	FILE NAME: p06b220.dgn	PLOT DATE: 07-MAY-2012 14:2
PROJECT LEADER: D.E.G.	DESIGNED BY: M.J.L.	DWG. NO. p06b220104.i	DRAWN BY: C.A.K.
			CHECKED BY: D.E.G.
			SHEET 22 OF 69