


646.402 DURABLE 4 INCH WHITE LINE, THERMOPLASTIC
 (ALL LINES WILL INCLUDE EDGE LINE BREAKS AND RADIUS FOR TOWN HIGHWAYS)
 VT. ROUTE 67A:
 STA 25+00.00 - STA 30+00.00 EDGE LINE LT/RT
 STA 25+00.00 - STA 25+20.00 DOTTED LANE LINE RT
 STA 25+00.00 - STA 26+66.00 DASHED LANE LINE LT
 STA 25+00.00 - STA 26+66.00 SOLID LANE LINE RT
 STA 25+00.00 - STA 26+66.00 DASHED LANE LINE RT
 STA 25+20.00 - STA 26+66.00 SOLID LANE LINE RT
 STA 27+35.04 SOLID LANE LINE LT, VT ROUTE 279 WB
 STA 27+35.04 SOLID LANE LINE RT, BENNINGTON PLAZA
 STA 27+57.00 - STA 28+24.00 SOLID LANE LINE LT
 STA 27+88.00 - STA 29+70.00 SOLID LANE LINE LT
 STA 27+88.00 - STA 30+00.00 DASHED LANE LINE LT
 STA 27+88.00 - STA 30+00.00 DASHED LANE LINE RT
 STA 29+10.00 - STA 29+70.00 SOLID EDGE LINE LT
 STA 29+70.00 - STA 30+00.00 DOTTED LANE LINE LT
 STA 29+70.00 - STA 30+00.00 DOTTED LANE LINE LT

646.412 DURABLE 4 INCH YELLOW LINE, THERMOPLASTIC
 (ALL LINES WILL INCLUDE C/L BREAKS FOR TOWN HIGHWAYS) S=SOLID, D=DASHED
 VT. ROUTE 67A:
 STA 25+00.00 - STA 30+00.00 MEDIAN EDGE LINE LT/RT
 STA 27+60.00 - STA 28+24.00 SLIP RAMP EDGE LINE LT
 STA 27+35.04 MEDIAN EDGE LINE LT, VT ROUTE 279 WB
 STA 27+35.04 MEDIAN EDGE LINE RT, BENNINGTON PLAZA

675.50 REMOVING SIGNS
 AS SHOWN - #8 20
 675.60 ERECTING SALVAGED SIGNS
 AS SHOWN - I

MATCH LINE STA 25+00. SEE PREVIOUS SHEET

NOTES:
 1. COLD PLANING AND PAVING LIMIT ON ALL TOWN HIGHWAYS SHALL BE MEASURED 25 FT BACK FROM VT. ROUTE 67A EDGE OF SHOULDER UNLESS DENOTED OTHERWISE ON THE PLANS OR AS DIRECTED BY THE RESIDENT ENGINEER.
 2. THE CONTRACTOR SHALL REHAB. THE EXISTING DROP INLETS, CATCH BASINS OR MANHOLES TO A DEPTH AS DIRECTED BY THE RESIDENT ENGINEER. ALL REHAB. WORK WILL BE PAID FOR UNDER THE APPLICABLE REHAB. ITEM AS DIRECTED BY THE RESIDENT ENGINEER. ALL EXISTING UTILITIES MARKED "TO REMAIN" SHALL NOT BE ALTERED OR REHABILITATED UNLESS DIRECTED OTHERWISE BY THE RESIDENT ENGINEER. PAVING LIMIT ON ALL TOWN HIGHWAYS SHALL BE MEASURED 25 FT BACK FROM VT. ROUTE 67A EDGE OF SHOULDER
 3. THE EXISTING TRAFFIC SIGNALS WILL BE UPGRADED TO A VIDEO VEHICLE DETECTION SYSTEM UNDER THE BENNINGTON STPG SGNL (35) PROJECT PRIOR TO THE CONSTRUCTION OF THIS CONTRACT. ALL EXISTING VEHICLE DETECTOR LOOPS REMAINING WITHIN THE LIMITS OF THIS PROJECT THAT ARE ENCOUNTERED DURING COLD PLANING OPERATIONS SHALL BE DISCONNECTED AND REMOVED AS DIRECTED BY THE RESIDENT ENGINEER. PAYMENT WILL BE MADE UNDER ITEM 210.10 COLD PLANING, BITUMINOUS PAVEMENT.

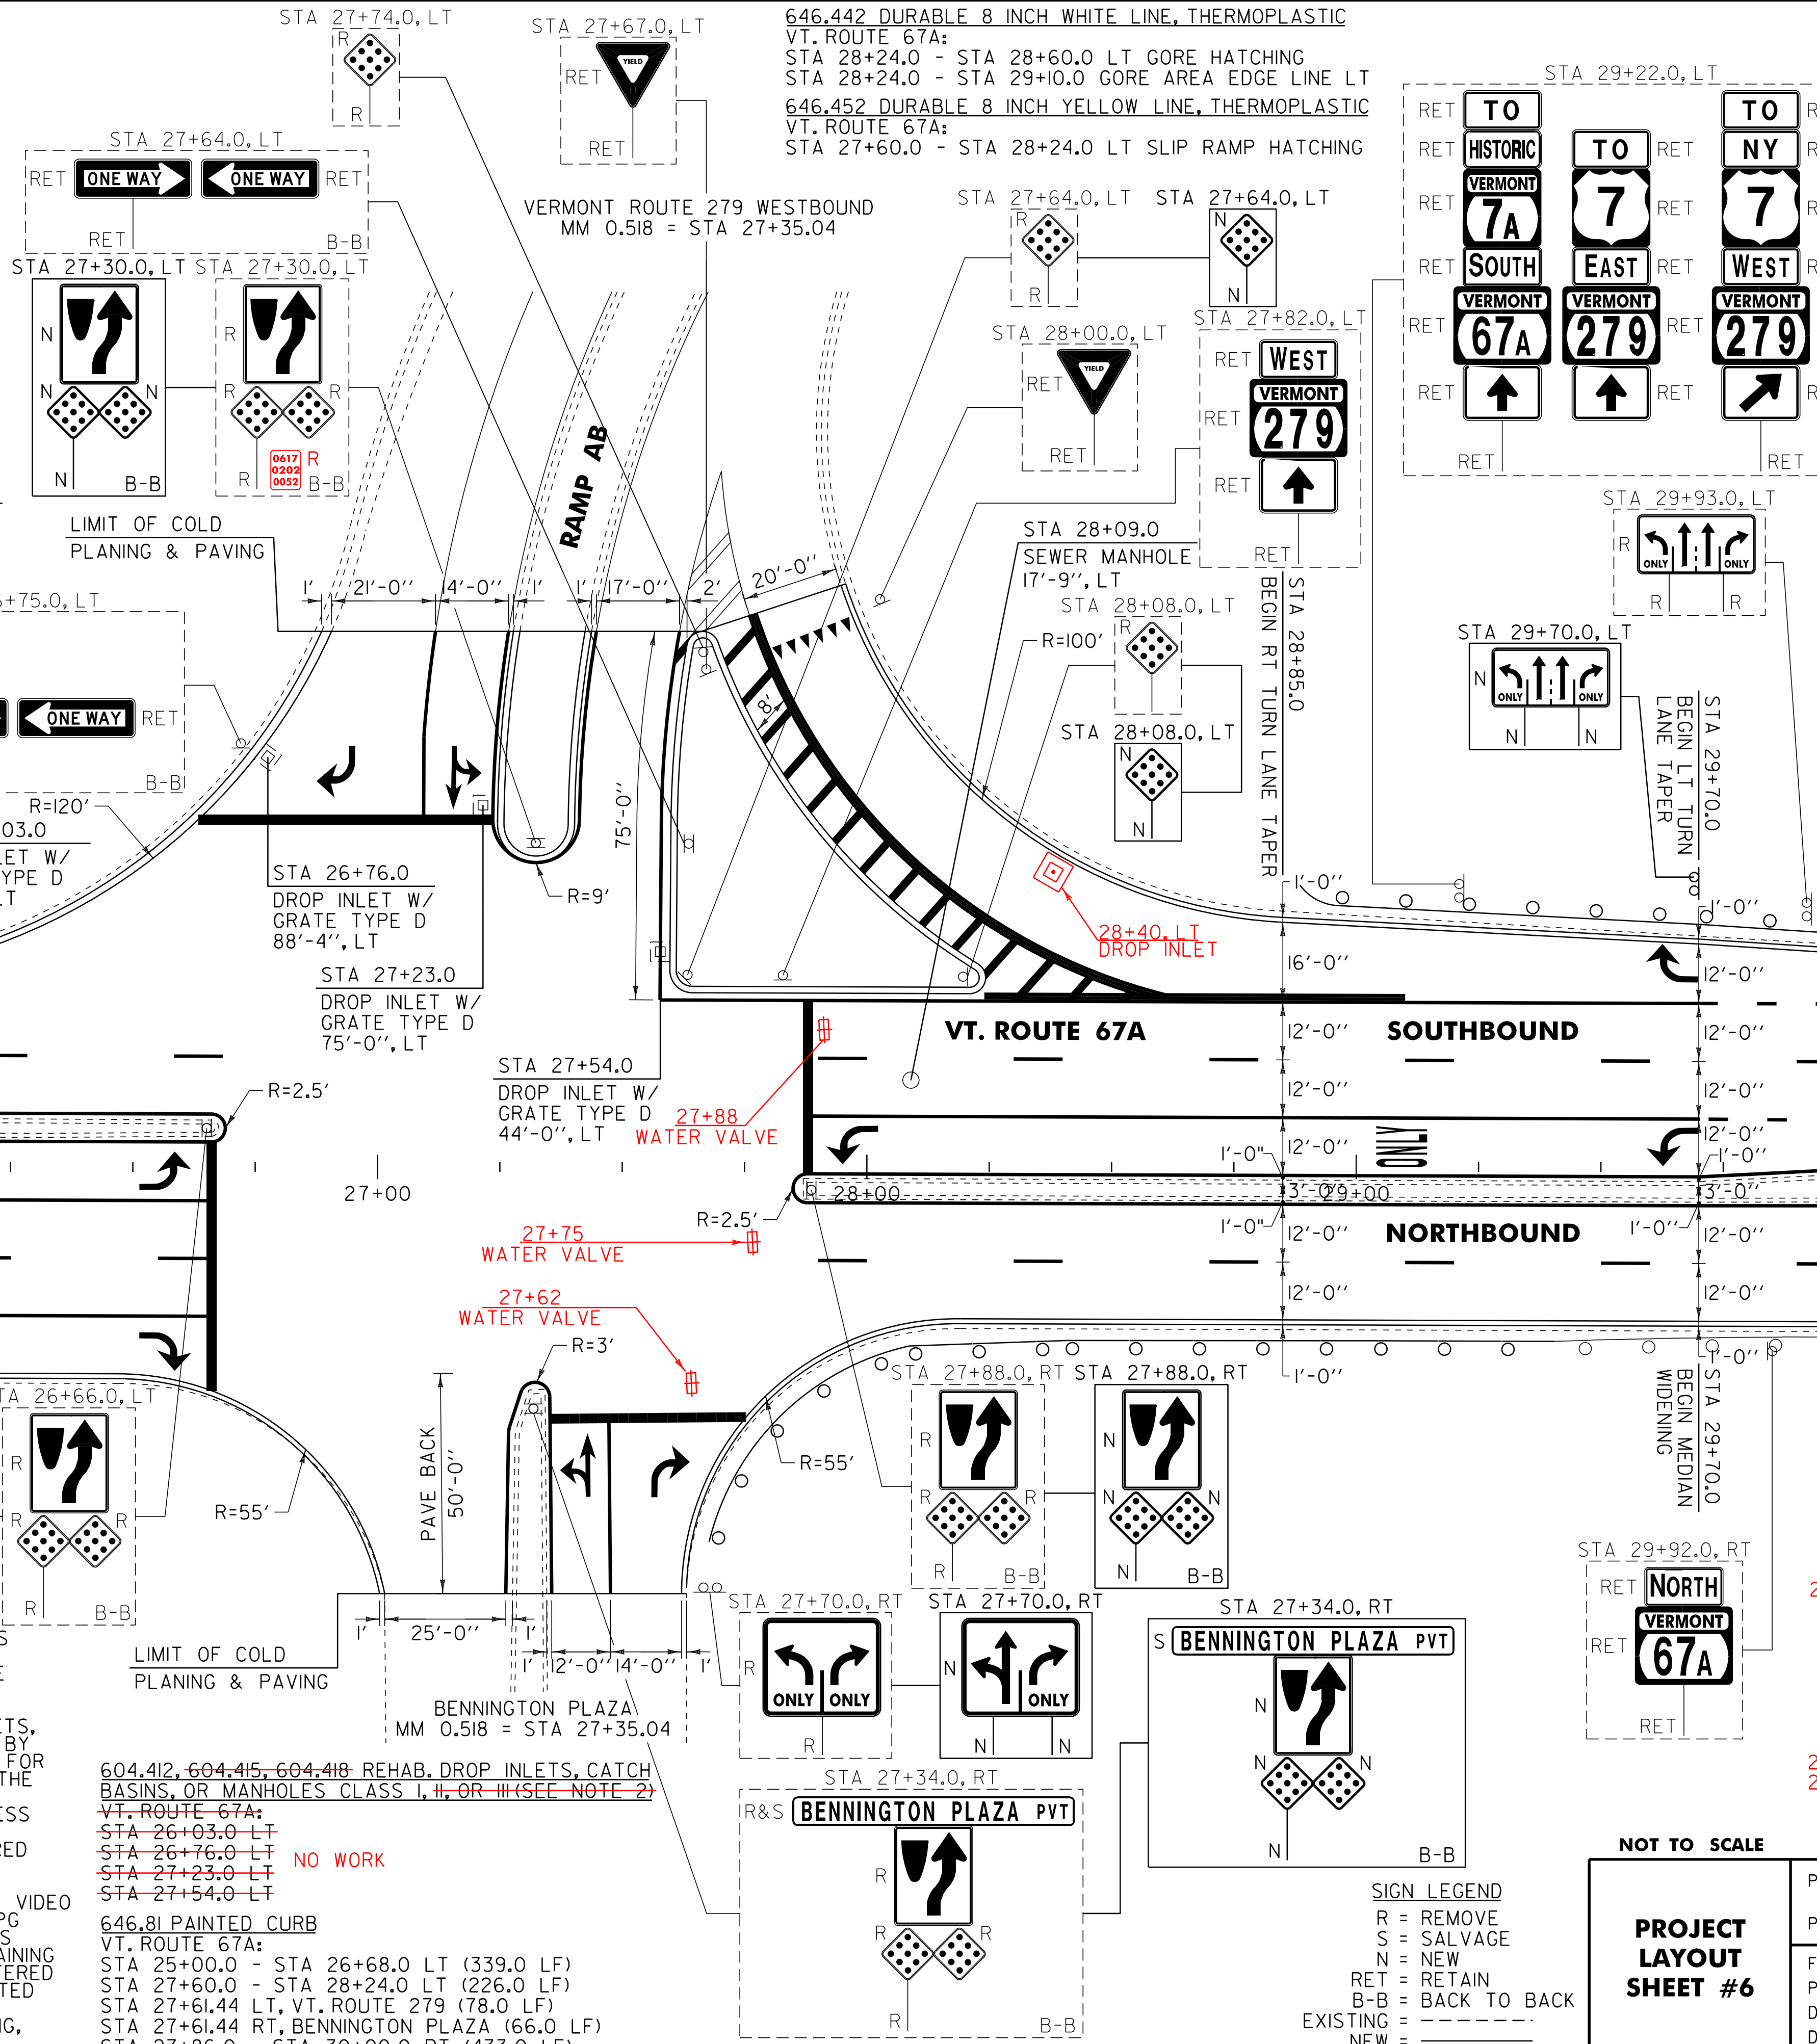

604.412, 604.415, 604.418 REHAB. DROP INLETS, CATCH BASINS, OR MANHOLES CLASS I, II, OR III (SEE NOTE 2)
 VT. ROUTE 67A:
~~STA 26+03.0 LT~~
~~STA 26+76.0 LT~~
~~STA 27+23.0 LT~~
~~STA 27+54.0 LT~~
 NO WORK
 646.81 PAINTED CURB
 VT. ROUTE 67A:
 STA 25+00.0 - STA 26+68.0 LT (339.0 LF)
 STA 27+60.0 - STA 28+24.0 LT (226.0 LF)
 STA 27+61.44 LT, VT. ROUTE 279 (78.0 LF)
 STA 27+61.44 RT, BENNINGTON PLAZA (66.0 LF)
 STA 27+86.0 - STA 30+00.0 RT (433.0 LF)

646.442 DURABLE 8 INCH WHITE LINE, THERMOPLASTIC
 VT. ROUTE 67A:
 STA 28+24.0 - STA 28+60.0 LT GORE HATCHING
 STA 28+24.0 - STA 29+10.0 GORE AREA EDGE LINE LT
 646.452 DURABLE 8 INCH YELLOW LINE, THERMOPLASTIC
 VT. ROUTE 67A:
 STA 27+60.0 - STA 28+24.0 LT SLIP RAMP HATCHING

646.482 DURABLE 24 INCH STOP BAR, THERMOPLASTIC
 VT. ROUTE 67A:
 STA 26+66.0 LT/RT
 STA 27+35.04 LT, VT ROUTE 279 WB
 STA 27+35.04 RT, BENNINGTON PLAZA
 STA 27+88.0 LT
 646.492 DURABLE LETTER OR SYMBOL, THERMOPLASTIC
 VT. ROUTE 67A:
 STA 25+25.0 RT, ARROW (1 EA)
 STA 25+39.0 C/L, "O,N,L,Y" (4 EA)
 STA 25+69.0 RT, "O,N,L,Y" (4 EA)
 STA 26+13.0 RT, "O,N,L,Y" (4 EA)
 STA 26+57.0 C/L, ARROW (1 EA)
 STA 26+57.0 RT, ARROW (1 EA)
 STA 27+35.04 LT, VT ROUTE 279 WB, ARROW (1 EA)
 STA 27+35.04 LT, VT ROUTE 279 WB, ARROW (2 EA)
 STA 27+35.04 RT, BENNINGTON PLAZA, ARROW (1 EA)
 STA 27+35.04 RT, BENNINGTON PLAZA, ARROW (2 EA)
 STA 27+90.0 LT, YIELD LINE (6 EA)
 STA 27+97.0 LT, ARROW (1 EA)
 STA 29+34.0 LT, "O,N,L,Y" (4 EA)
 STA 29+66.0 LT, ARROW (1 EA)
 STA 29+66.0 LT, ARROW (1 EA)

646.602 TEMPORARY 4 INCH WHITE LINE, PAINT
 (ALL LINES WILL INCLUDE EDGE LINE BREAKS AND RADIUS FOR TOWN HIGHWAYS)
 VT. ROUTE 67A:
 STA 25+00.00 - STA 30+00.00 EDGE LINE LT/RT
 STA 25+00.00 - STA 25+20.00 DOTTED LANE LINE RT
 STA 25+00.00 - STA 26+66.00 DASHED LANE LINE LT
 STA 25+00.00 - STA 26+66.00 SOLID LANE LINE RT
 STA 25+00.00 - STA 26+66.00 DASHED LANE LINE RT
 STA 25+20.00 - STA 26+66.00 SOLID LANE LINE RT
 STA 27+35.04 SOLID LANE LINE LT, VT ROUTE 279 WB
 STA 27+35.04 SOLID LANE LINE RT, BENNINGTON PLAZA
 STA 27+57.00 - STA 28+24.00 SOLID LANE LINE LT
 STA 27+88.00 - STA 29+70.00 SOLID LANE LINE LT
 STA 27+88.00 - STA 30+00.00 DASHED LANE LINE LT
 STA 27+88.00 - STA 30+00.00 DASHED LANE LINE RT
 STA 29+10.00 - STA 29+70.00 SOLID EDGE LINE LT
 STA 29+70.00 - STA 30+00.00 DOTTED LANE LINE LT
 STA 29+70.00 - STA 30+00.00 DOTTED LANE LINE LT

646.612 TEMPORARY 4 INCH YELLOW LINE, PAINT
 (ALL LINES WILL INCLUDE C/L BREAKS FOR TOWN HIGHWAYS) S=SOLID, D=DASHED
 VT. ROUTE 67A:
 STA 25+00.00 - STA 30+00.00 MEDIAN EDGE LINE LT/RT
 STA 27+35.04 MEDIAN EDGE LINE LT, VT ROUTE 279 WB
 STA 27+35.04 MEDIAN EDGE LINE RT, BENNINGTON PLAZA
 STA 27+60.00 - STA 28+24.00 SLIP RAMP EDGE LINE LT

646.682 TEMPORARY 24 INCH STOP BAR, PAINT
 VT. ROUTE 67A:
 STA 26+66.0 LT/RT
 STA 27+35.04 LT, VT ROUTE 279 WB
 STA 27+35.04 RT, BENNINGTON PLAZA
 STA 27+88.0 LT
 646.692 TEMPORARY LETTER OR SYMBOL, PAINT
 VT. ROUTE 67A:
 STA 26+57.0 C/L, ARROW (2 EA)
 STA 26+57.0 RT, ARROW (2 EA)
 STA 27+35.04 LT, VT ROUTE 279 WB, ARROW (2 EA)
 STA 27+35.04 LT, VT ROUTE 279 WB, ARROW (4 EA)
 STA 27+35.04 RT, BENNINGTON PLAZA, ARROW (2 EA)
 STA 27+35.04 RT, BENNINGTON PLAZA, ARROW (4 EA)
 STA 27+90.0 LT, YIELD LINE (12 EA)
 STA 27+97.0 LT, ARROW (2 EA)
 STA 29+66.0 LT, ARROW (2 EA)
 STA 29+66.0 LT, ARROW (2 EA)

621.20 STEEL BEAM GUARDRAIL, GALVANIZED
 VT. ROUTE 67A:
 STA 27+64.0 - STA 30+00.0 RT (238.0 LF)
 STA 28+88.5 - STA 30+00.0 LT (113.5 LF)
 621.60 ANCHOR FOR STEEL BEAM RAIL
 VT. ROUTE 67A:
 STA 27+70.5 RT 28+20
 STA 28+95.0 LT 29+40
 621.80 REMOVAL AND DISPOSAL OF GUARDRAIL
 VT. ROUTE 67A:
 STA 27+64.0 - STA 30+00.0 RT (236.0 LF)
 STA 28+98.0 - STA 30+00.0 LT (102.0 LF)
 604.42 CHANGING ELEVATION OF SEWER MANHOLES
 VT. ROUTE 67A:
 STA 28+09.0 LT * SEE NOTE, SHEET 19

SIGN LEGEND
 R = REMOVE
 S = SALVAGE
 N = NEW
 RET = RETAIN
 B-B = BACK TO BACK
 EXISTING = - - - - -
 NEW = _____

NOT TO SCALE
PROJECT LAYOUT SHEET #6

PROJECT NAME: BENNINGTON
 PROJECT NUMBER: STP 2626(1)
 FILE NAME: p06b220.dgn
 PROJECT LEADER: D.E.G.
 DESIGNED BY: M.J.L.
 DWG. NO. p06b220106.i
 PLOT DATE: 07-MAY-2012 14:2
 DRAWN BY: C.A.K.
 CHECKED BY: D.E.G.
 SHEET 24 OF 69