

646.402 DURABLE 4 INCH WHITE LINE, THERMOPLASTIC
 (ALL LINES WILL INCLUDE EDGE LINE BREAKS AND RADIUS FOR TOWN HIGHWAYS)
 VT. ROUTE 67A:
 STA 39+00.00 - STA 44+00.00 EDGE LINE LT/RT
 STA 39+00.00 - STA 39+70.00 DOTTED LANE LINE LT
 STA 39+00.00 - STA 42+95.00 DASHED LANE LINE LT


646.412 DURABLE 4 INCH YELLOW LINE, THERMOPLASTIC
 (ALL LINES WILL INCLUDE C/L BREAKS FOR TOWN HIGHWAYS) S=SOLID, D=DASHED
 VT. ROUTE 67A:
 STA 39+00.00 - STA 40+90.00 MEDIAN EDGE LINE LT/RT
 STA 40+90.00 - STA 44+00.00 DOUBLE SOLID MEDIAN LT/RT

646.602 TEMPORARY 4 INCH WHITE LINE, PAINT
 (ALL LINES WILL INCLUDE EDGE LINE BREAKS AND RADIUS FOR TOWN HIGHWAYS)
 VT. ROUTE 67A:
 STA 39+00.00 - STA 44+00.00 EDGE LINE LT/RT
 STA 39+00.00 - STA 39+70.00 DOTTED LANE LINE LT
 STA 39+00.00 - STA 42+95.00 DASHED LANE LINE LT

646.612 TEMPORARY 4 INCH YELLOW LINE, PAINT
 (ALL LINES WILL INCLUDE C/L BREAKS FOR TOWN HIGHWAYS) S=SOLID, D=DASHED
 VT. ROUTE 67A:
 STA 39+00.00 - STA 40+90.00 MEDIAN EDGE LINE LT/RT
 STA 40+90.00 - STA 44+00.00 DOUBLE SOLID MEDIAN LT/RT

646.452 DURABLE 8 INCH YELLOW LINE, THERMOPLASTIC
 VT. ROUTE 67A:
 STA 40+90.00 - STA 44+00.00 HATCHED MEDIAN LT/RT

675.50 REMOVING SIGNS AS SHOWN - 4

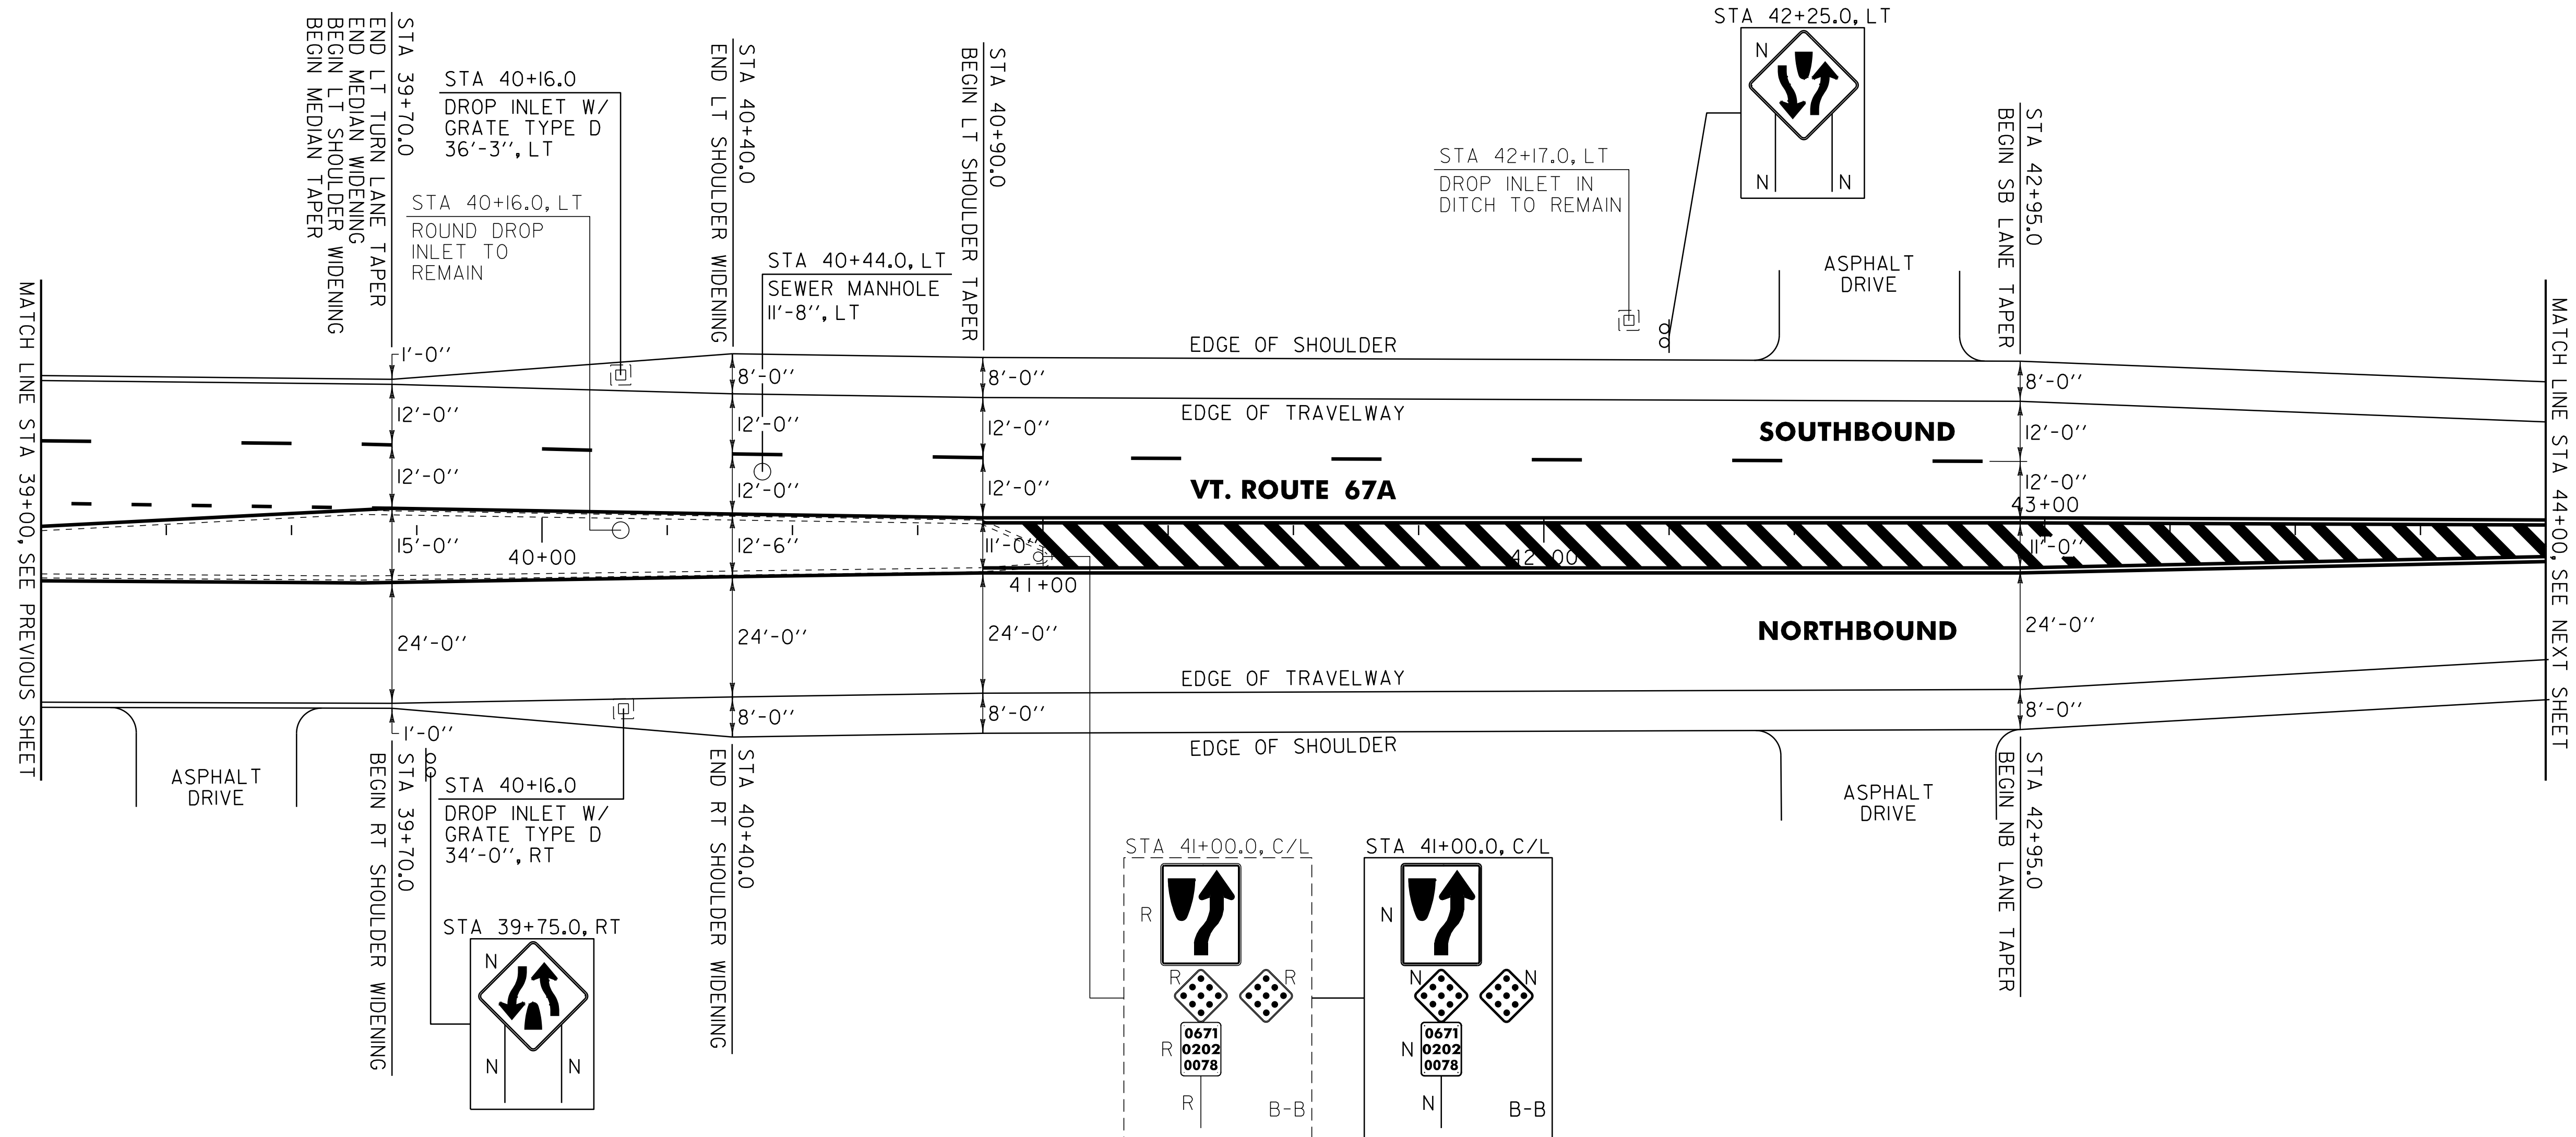

604.412, ~~604.415~~, ~~604.418~~ REHAB. DROP INLETS, CATCH BASINS, OR MANHOLES CLASS I, II, OR III (SEE NOTE 1)
 VT. ROUTE 67A:
 STA 40+16.0 LT
 STA 40+16.0 RT

~~604.42 CHANGING ELEVATION OF SEWER MANHOLES~~
 VT. ROUTE 67A:
 STA 40+44.0 LT

646.81 PAINTED CURB
 VT. ROUTE 67A:
 STA 39+40.0 - STA 40+00.0 LT (120.0 LF)
 STA 40+70.0 - STA 41+00.0 LT/RT (63.0 LF)

NOTE:

- THE CONTRACTOR SHALL REHAB. THE EXISTING DROP INLETS, CATCH BASINS OR MANHOLES TO A DEPTH AS DIRECTED BY THE RESIDENT ENGINEER. ALL REHAB. WORK WILL BE PAID FOR UNDER THE APPLICABLE REHAB. ITEM AS DIRECTED BY THE RESIDENT ENGINEER. ALL EXISTING UTILITIES MARKED "TO REMAIN" SHALL NOT BE ALTERED OR REHABILITATED UNLESS DIRECTED OTHERWISE BY THE RESIDENT ENGINEER.

SIGN LEGEND
 R = REMOVE
 S = SALVAGE
 N = NEW
 RET = RETAIN
 B-B = BACK TO BACK
 EXISTING = - - - - -
 NEW = _____

NOT TO SCALE

PROJECT LAYOUT SHEET #9	PROJECT NAME: BENNINGTON	PLOT DATE: 07-MAY-2012 14:2
	PROJECT NUMBER: STP 2626(1)	DRAWN BY: C.A.K.
	FILE NAME: p06b220.dgn	CHECKED BY: D.E.G.
	DESIGNED BY: M.J.L.	SHEET 27 OF 69