

646.402 DURABLE 4 INCH WHITE LINE, THERMOPLASTIC
 (ALL LINES WILL INCLUDE EDGE LINE BREAKS AND
 RADIUS FOR TOWN HIGHWAYS)
 VT. ROUTE 67A:
 STA 44+00.00 - STA 49+50.00 EDGE LINE LT/RT


646.602 TEMPORARY 4 INCH WHITE LINE, PAINT
 (ALL LINES WILL INCLUDE EDGE LINE BREAKS AND
 RADIUS FOR TOWN HIGHWAYS)
 VT. ROUTE 67A:
 STA 44+00.00 - STA 49+50.00 EDGE LINE LT/RT

646.452 DURABLE 8 INCH YELLOW LINE, THERMOPLASTIC
 VT. ROUTE 67A:
 STA 44+00.00 - STA 46+45.00 HATCHED MEDIAN LT/RT

675.50 REMOVING SIGNS
 AS SHOWN - 1

646.412 DURABLE 4 INCH YELLOW LINE, THERMOPLASTIC
 (ALL LINES WILL INCLUDE C/L BREAKS FOR
 TOWN HIGHWAYS) S=SOLID, D=DASHED
 VT. ROUTE 67A:
 STA 46+45.00 - STA 49+50.00 LT C RT
 S - S
 STA 44+00.00 - STA 46+45.00 DOUBLE SOLID MEDIAN LT/RT

646.612 TEMPORARY 4 INCH YELLOW LINE, PAINT
 (ALL LINES WILL INCLUDE C/L BREAKS FOR
 TOWN HIGHWAYS) S=SOLID, D=DASHED
 VT. ROUTE 67A:
 STA 46+45.00 - STA 49+50.00 LT C RT
 S - S
 STA 44+00.00 - STA 46+45.00 DOUBLE SOLID MEDIAN LT/RT

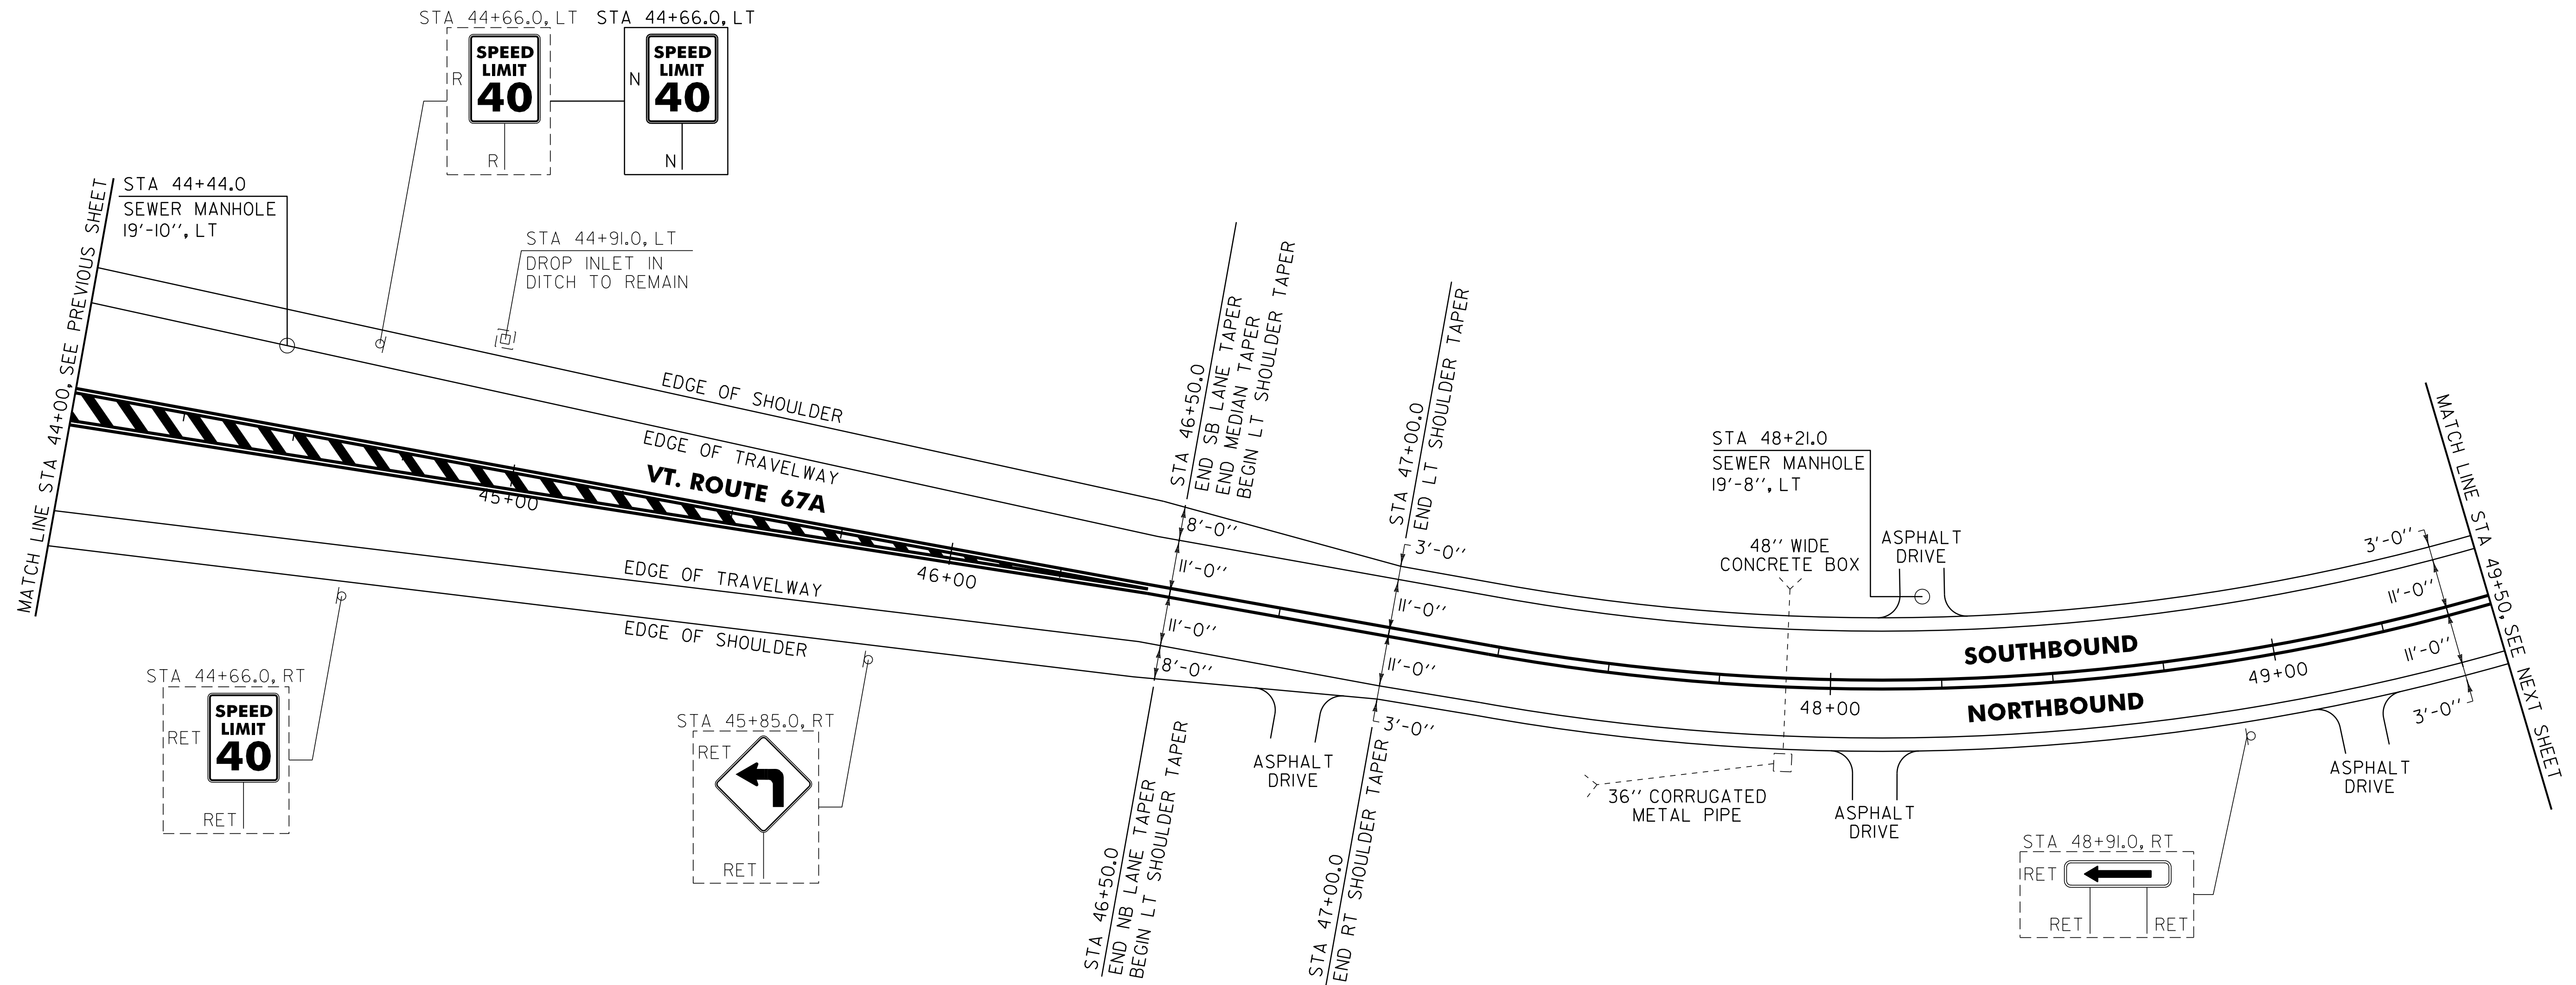

~~604.42 CHANGING ELEVATION OF SEWER MANHOLES
 VT. ROUTE 67A:
 STA 44+44.0 LT
 STA 48+21.0 LT~~ • SEE NOTE,
 SHEET 19

SIGN LEGEND
 R = REMOVE
 S = SALVAGE
 N = NEW
 RET = RETAIN
 B-B = BACK TO BACK
 EXISTING = - - - - -
 NEW = _____

NOT TO SCALE	
PROJECT LAYOUT SHEET #10	PROJECT NAME: BENNINGTON
	PROJECT NUMBER: STP 2626(1)
	FILE NAME: p06b220.dgn
	PLOT DATE: 07-MAY-2012 14:2
	PROJECT LEADER: D.E.G.
	DESIGNED BY: M.J.L.
	DWG. NO. p06b220i0.i
	CHECKED BY: D.E.G.
	SHEET 28 OF 69