

646.402 DURABLE 4 INCH WHITE LINE, THERMOPLASTIC  
 (ALL LINES WILL INCLUDE EDGE LINE BREAKS AND  
 RADIUS FOR TOWN HIGHWAYS)  
 VT. ROUTE 67A:  
 STA 55+00.00 - STA 61+00.00 EDGE LINE LT/RT

646.602 TEMPORARY 4 INCH WHITE LINE, PAINT  
 (ALL LINES WILL INCLUDE EDGE LINE BREAKS AND  
 RADIUS FOR TOWN HIGHWAYS)  
 VT. ROUTE 67A:  
 STA 55+00.00 - STA 61+00.00 EDGE LINE LT/RT

646.482 DURABLE 24 INCH STOP BAR, THERMOPLASTIC  
 VT. ROUTE 67A:  
 STA 55+44.00 LT, TH-26  
 STA 55+54.56 RT, TH-II

646.682 TEMPORARY 24 INCH STOP BAR, PAINT  
 VT. ROUTE 67A:  
 STA 55+44.00 LT, TH-26  
 STA 55+54.56 RT, TH-II

675.50 REMOVING SIGNS  
 AS SHOWN - 8-9


646.412 DURABLE 4 INCH YELLOW LINE, THERMOPLASTIC  
 (ALL LINES WILL INCLUDE C/L BREAKS FOR  
 TOWN HIGHWAYS) S=SOLID, D=DASHED  
 VT. ROUTE 67A:  
 STA 55+00.00 - STA 61+00.00 LT ☉ RT  
 S - S

646.612 TEMPORARY 4 INCH YELLOW LINE, PAINT  
 (ALL LINES WILL INCLUDE C/L BREAKS FOR  
 TOWN HIGHWAYS) S=SOLID, D=DASHED  
 VT. ROUTE 67A:  
 STA 55+00.00 - STA 61+00.00 LT ☉ RT  
 S - S

646.492 DURABLE LETTER OR SYMBOL, THERMOPLASTIC  
 VT. ROUTE 67A:  
 STA 55+44+00 LT, TH-26, "S,T,O,P" (4 EA)  
 STA 55+54.56 RT, TH-II, "S,T,O,P" (4 EA)

646.692 TEMPORARY LETTER OR SYMBOL, PAINT  
 VT. ROUTE 67A:  
 STA 55+44+00 LT, TH-26, "S,T,O,P" (8 EA)  
 STA 55+54.56 RT, TH-II, "S,T,O,P" (8 EA)

675.60 ERECTING SALVAGED SIGNS  
 AS SHOWN - 3

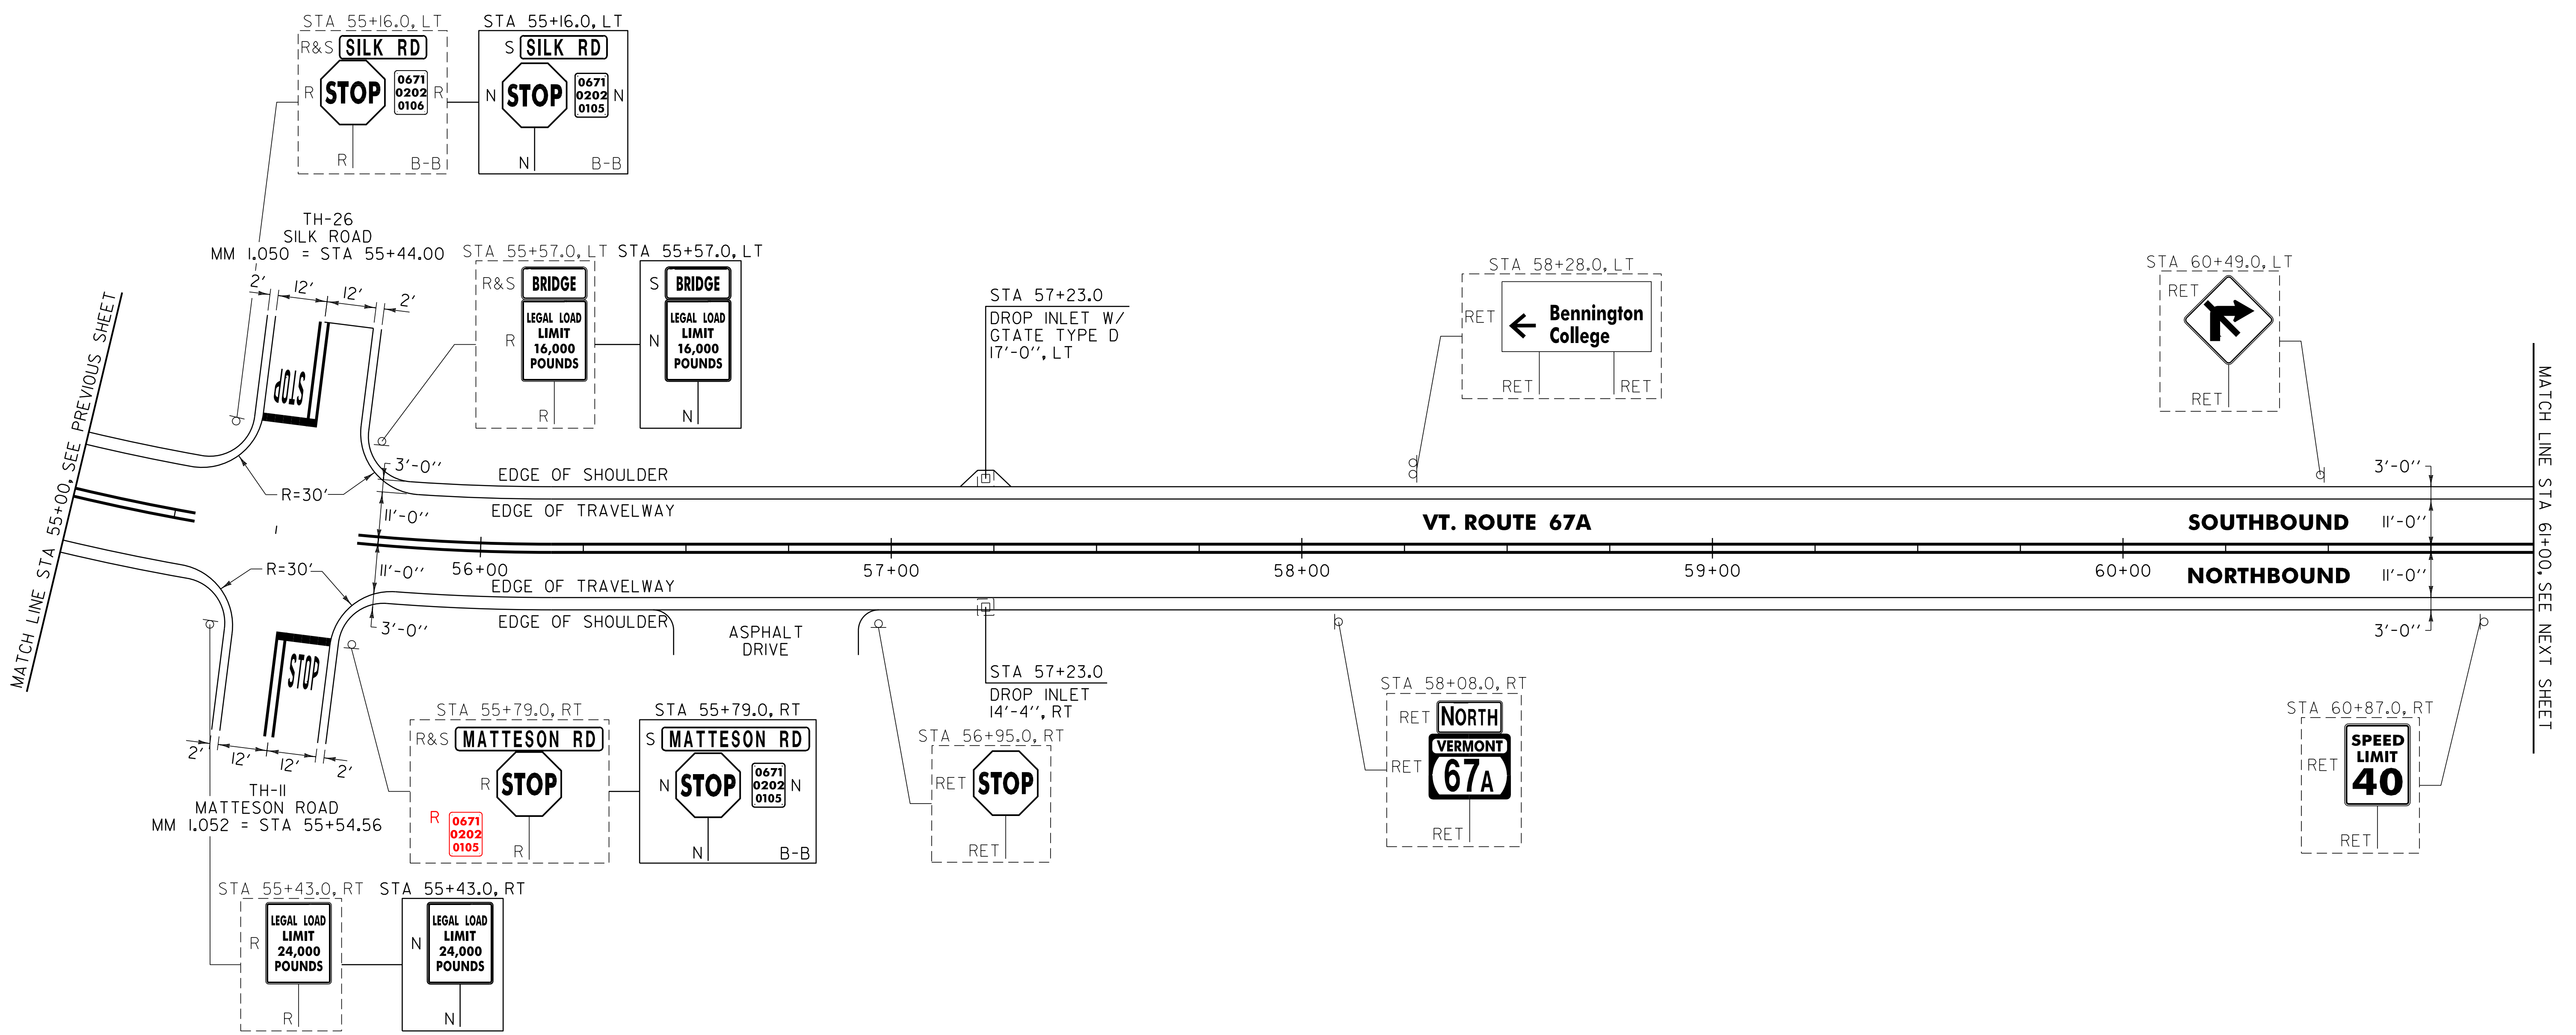

604.412, 604.415, 604.418 REHAB. DROP INLETS,  
 CATCH BASINS, OR MANHOLES CLASS I, II, OR III (SEE NOTE 2)  
 VT. ROUTE 67A:  
 STA 57+23.0 LT NO WORK  
 STA 57+23.0 RT

NOTE:  
 I. COLD PLANING AND PAVING LIMIT ON ALL TOWN HIGHWAYS  
 SHALL BE MEASURED 25 FT BACK FROM VT. ROUTE 67A  
 EDGE OF SHOULDER UNLESS DENOTED OTHERWISE ON THE  
 PLANS OR AS DIRECTED BY THE RESIDENT ENGINEER.

SIGN LEGEND  
 R = REMOVE  
 S = SALVAGE  
 N = NEW  
 RET = RETAIN  
 B-B = BACK TO BACK  
 EXISTING = - - - - -  
 NEW = \_\_\_\_\_

<b>NOT TO SCALE</b>	
<b>PROJECT LAYOUT SHEET #12</b>	PROJECT NAME: BENNINGTON
	PROJECT NUMBER: STP 2626(1)
	FILE NAME: p06b220.dgn
	PLOT DATE: 07-MAY-2012 14:2
	PROJECT LEADER: D.E.G.
	DESIGNED BY: M.J.L.
	DWG. NO. p06b220112.i
	CHECKED BY: D.E.G.
	SHEET 30 OF 69