

646.402 DURABLE 4 INCH WHITE LINE, THERMOPLASTIC  
 (ALL LINES WILL INCLUDE EDGE LINE BREAKS AND RADIUS FOR TOWN HIGHWAYS)  
 VT. ROUTE 67A:  
 STA 72+00.00 - STA 77+50.00 EDGE LINE LT/RT

646.602 TEMPORARY 4 INCH WHITE LINE, PAINT  
 (ALL LINES WILL INCLUDE EDGE LINE BREAKS AND RADIUS FOR TOWN HIGHWAYS)  
 VT. ROUTE 67A:  
 STA 72+00.00 - STA 77+50.00 EDGE LINE LT/RT

646.482 DURABLE 24 INCH STOP BAR, THERMOPLASTIC  
 VT. ROUTE 67A:  
 STA 77+08.80 LT, TH-19

646.682 TEMPORARY 24 INCH STOP BAR, PAINT  
 VT. ROUTE 67A:  
 STA 77+08.80 LT, TH-19

675.50 REMOVING SIGNS  
 AS SHOWN - 3


646.412 DURABLE 4 INCH YELLOW LINE, THERMOPLASTIC  
 (ALL LINES WILL INCLUDE C/L BREAKS FOR TOWN HIGHWAYS) S=SOLID, D=DASHED  
 VT. ROUTE 67A:  
 STA 72+00.00 - STA 77+50.00 LT CL RT  
 S - S  
 STA 77+08.80 DOUBLE SOLID LT, TH-19

646.612 TEMPORARY 4 INCH YELLOW LINE, PAINT  
 (ALL LINES WILL INCLUDE C/L BREAKS FOR TOWN HIGHWAYS) S=SOLID, D=DASHED  
 VT. ROUTE 67A:  
 STA 72+00.00 - STA 77+50.00 LT CL RT  
 S - S  
 STA 77+08.80 DOUBLE SOLID LT, TH-19

646.492 DURABLE LETTER OR SYMBOL, THERMOPLASTIC  
 VT. ROUTE 67A:  
 STA 77+08.80 LT, TH-19, "S,T,O,P" (4 EA)

646.692 TEMPORARY LETTER OR SYMBOL, PAINT  
 VT. ROUTE 67A:  
 STA 77+08.80 LT, TH-19, "S,T,O,P" (8 EA)

675.60 ERECTING SALVAGED SIGNS  
 AS SHOWN - 1

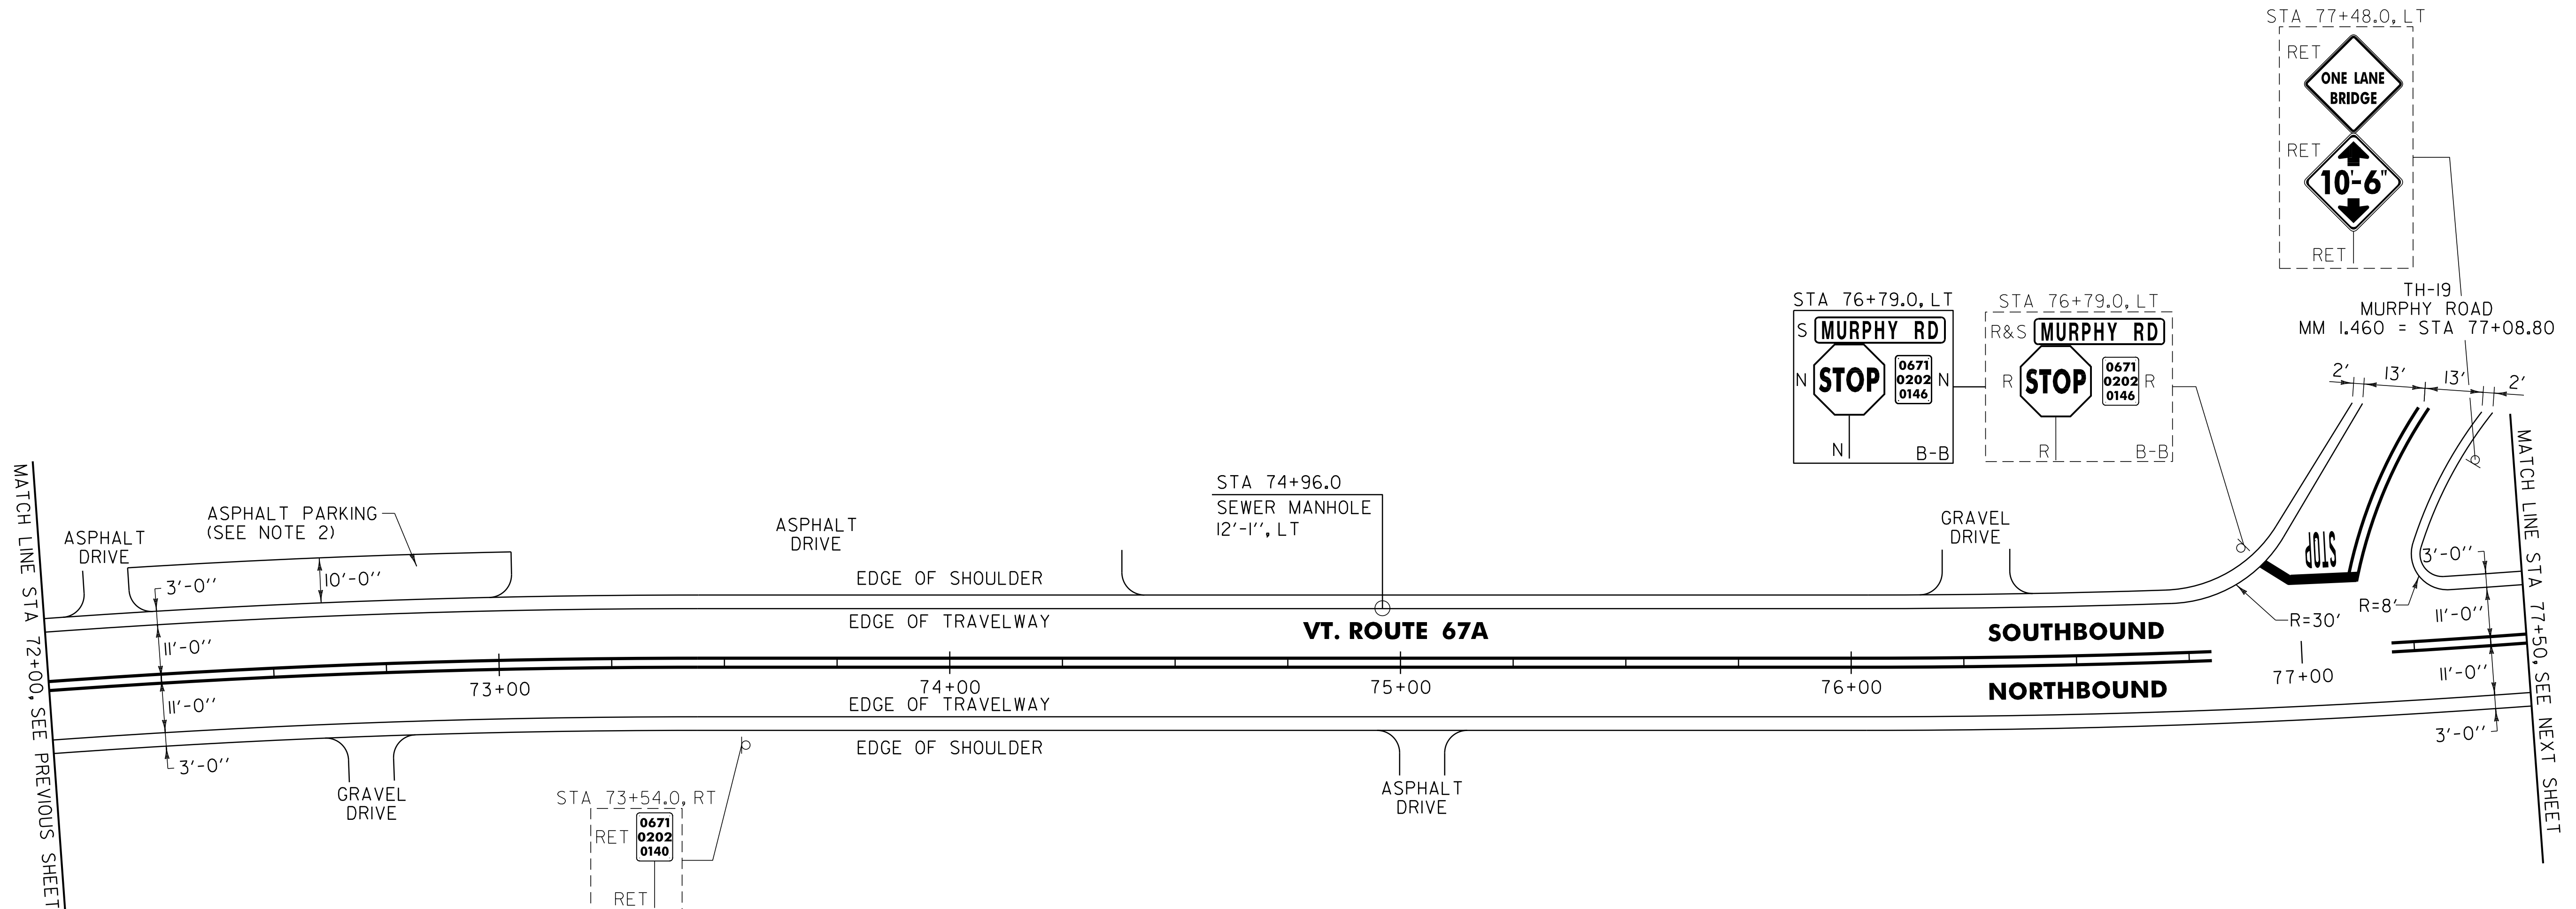

NOTES:

- COLD PLANING AND PAVING LIMIT ON ALL TOWN HIGHWAYS SHALL BE MEASURED 25 FT BACK FROM VT. ROUTE 67A EDGE OF SHOULDER UNLESS DENOTED OTHERWISE ON THE PLANS OR AS DIRECTED BY THE RESIDENT ENGINEER.
- PROVIDE A 5 FT WIDE, 1 1/2 " TYPE IVS APRON FOR THE EXISTING "ASPHALT PARKING AREA". ANY REQUIRED EXCAVATION SHALL BE PERFORMED AS DIRECTED BY THE RESIDENT ENGINEER AND PAID FOR UNDER ITEM 608.25 ALL PURPOSE EXCAVATOR RENTAL, TYPE I.

SIGN LEGEND  
 R = REMOVE  
 S = SALVAGE  
 N = NEW  
 RET = RETAIN  
 B-B = BACK TO BACK  
 EXISTING = - - - - -  
 NEW = \_\_\_\_\_

NOT TO SCALE

<b>PROJECT LAYOUT SHEET #15</b>	PROJECT NAME: BENNINGTON	PLOT DATE: 07-MAY-2012 14:2
	PROJECT NUMBER: STP 2626(1)	DRAWN BY: C.A.K.
	FILE NAME: p06b220.dgn	CHECKED BY: D.E.G.
	PROJECT LEADER: D.E.G. DESIGNED BY: M.J.L. DWG. NO. p06b220115.i	SHEET 33 OF 69

~~604.42 CHANGING ELEVATION OF SEWER MANHOLES  
 VT. ROUTE 67A:  
 STA 74+96.0 LT~~      • SEE NOTE, SHEET 19