

646.402 DURABLE 4 INCH WHITE LINE, THERMOPLASTIC
 (ALL LINES WILL INCLUDE EDGE LINE BREAKS AND
 RADIUS FOR TOWN HIGHWAYS)
 VT. ROUTE 67A:
 STA 88+50.00 - STA 94+00.00 EDGE LINE LT/RT


646.602 TEMPORARY 4 INCH WHITE LINE, PAINT
 (ALL LINES WILL INCLUDE EDGE LINE BREAKS AND
 RADIUS FOR TOWN HIGHWAYS)
 VT. ROUTE 67A:
 STA 88+50.00 - STA 94+00.00 EDGE LINE LT/RT

646.412 DURABLE 4 INCH YELLOW LINE, THERMOPLASTIC
 (ALL LINES WILL INCLUDE C/L BREAKS FOR
 TOWN HIGHWAYS) S=SOLID, D=DASHED
 VT. ROUTE 67A: LT C RT
 STA 88+50.00 - STA 94+00.00 S - S

646.612 TEMPORARY 4 INCH YELLOW LINE, PAINT
 (ALL LINES WILL INCLUDE C/L BREAKS FOR
 TOWN HIGHWAYS) S=SOLID, D=DASHED
 VT. ROUTE 67A: LT C RT
 STA 88+50.00 - STA 94+00.00 S - S

MATCH LINE STA 88+50. SEE PREVIOUS SHEET

MATCH LINE STA 94+00. SEE NEXT SHEET

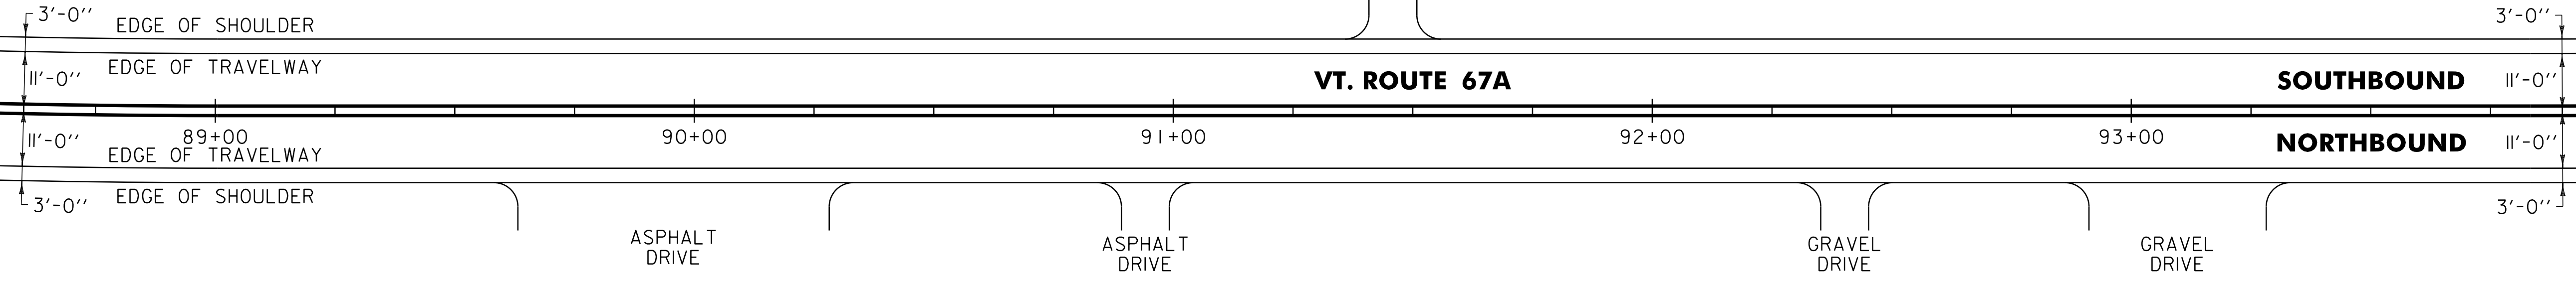

NOT TO SCALE

PROJECT LAYOUT SHEET #18	PROJECT NAME: BENNINGTON	
	PROJECT NUMBER: STP 2626(1)	
	FILE NAME: p06b220.dgn	PLOT DATE: 07-MAY-2012 14:2
	PROJECT LEADER: D.E.G.	DRAWN BY: C.A.K.
	DESIGNED BY: M.J.L.	CHECKED BY: D.E.G.
	DWG. NO. p06b220118.i	SHEET 36 OF 69