

646.402 DURABLE 4 INCH WHITE LINE, THERMOPLASTIC
 (ALL LINES WILL INCLUDE EDGE LINE BREAKS AND
 RADIUS FOR TOWN HIGHWAYS)
 VT. ROUTE 67A:
 STA 110+50.00 - STA 112+46.40 EDGE LINE LT/RT

646.602 TEMPORARY 4 INCH WHITE LINE, PAINT
 (ALL LINES WILL INCLUDE EDGE LINE BREAKS AND
 RADIUS FOR TOWN HIGHWAYS)
 VT. ROUTE 67A:
 STA 110+50.00 - STA 112+46.40 EDGE LINE LT/RT

646.482 DURABLE 24 INCH STOP BAR, THERMOPLASTIC
 VT. ROUTE 67A:
 STA 111+19.68 RT, SCAREY LANE

646.682 TEMPORARY 24 INCH STOP BAR, PAINT
 VT. ROUTE 67A:
 STA 111+19.68 RT, SCAREY LANE

675.50 REMOVING SIGNS
 AS SHOWN - 2 3


646.412 DURABLE 4 INCH YELLOW LINE, THERMOPLASTIC
 (ALL LINES WILL INCLUDE C/L BREAKS FOR
 TOWN HIGHWAYS) S=SOLID, D=DASHED
 VT. ROUTE 67A: LT C RT
 STA 110+50.00 - STA 112+46.40 S - S
 STA 111+19.68 DOUBLE SOLID RT, SCAREY LANE

646.612 TEMPORARY 4 INCH YELLOW LINE, PAINT
 (ALL LINES WILL INCLUDE C/L BREAKS FOR
 TOWN HIGHWAYS) S=SOLID, D=DASHED
 VT. ROUTE 67A: LT C RT
 STA 110+50.00 - STA 112+46.40 S - S
 STA 111+19.68 DOUBLE SOLID RT, SCAREY LANE

646.492 DURABLE LETTER OR SYMBOL, THERMOPLASTIC
 VT. ROUTE 67A:
 STA 111+19.68 RT, SCAREY LANE, "S,T,O,P" (4 EA)

646.692 TEMPORARY LETTER OR SYMBOL, PAINT
 VT. ROUTE 67A:
 STA 111+19.68 RT, SCAREY LANE, "S,T,O,P" (8 EA)

675.60 ERECTING SALVAGED SIGNS
 AS SHOWN - 1

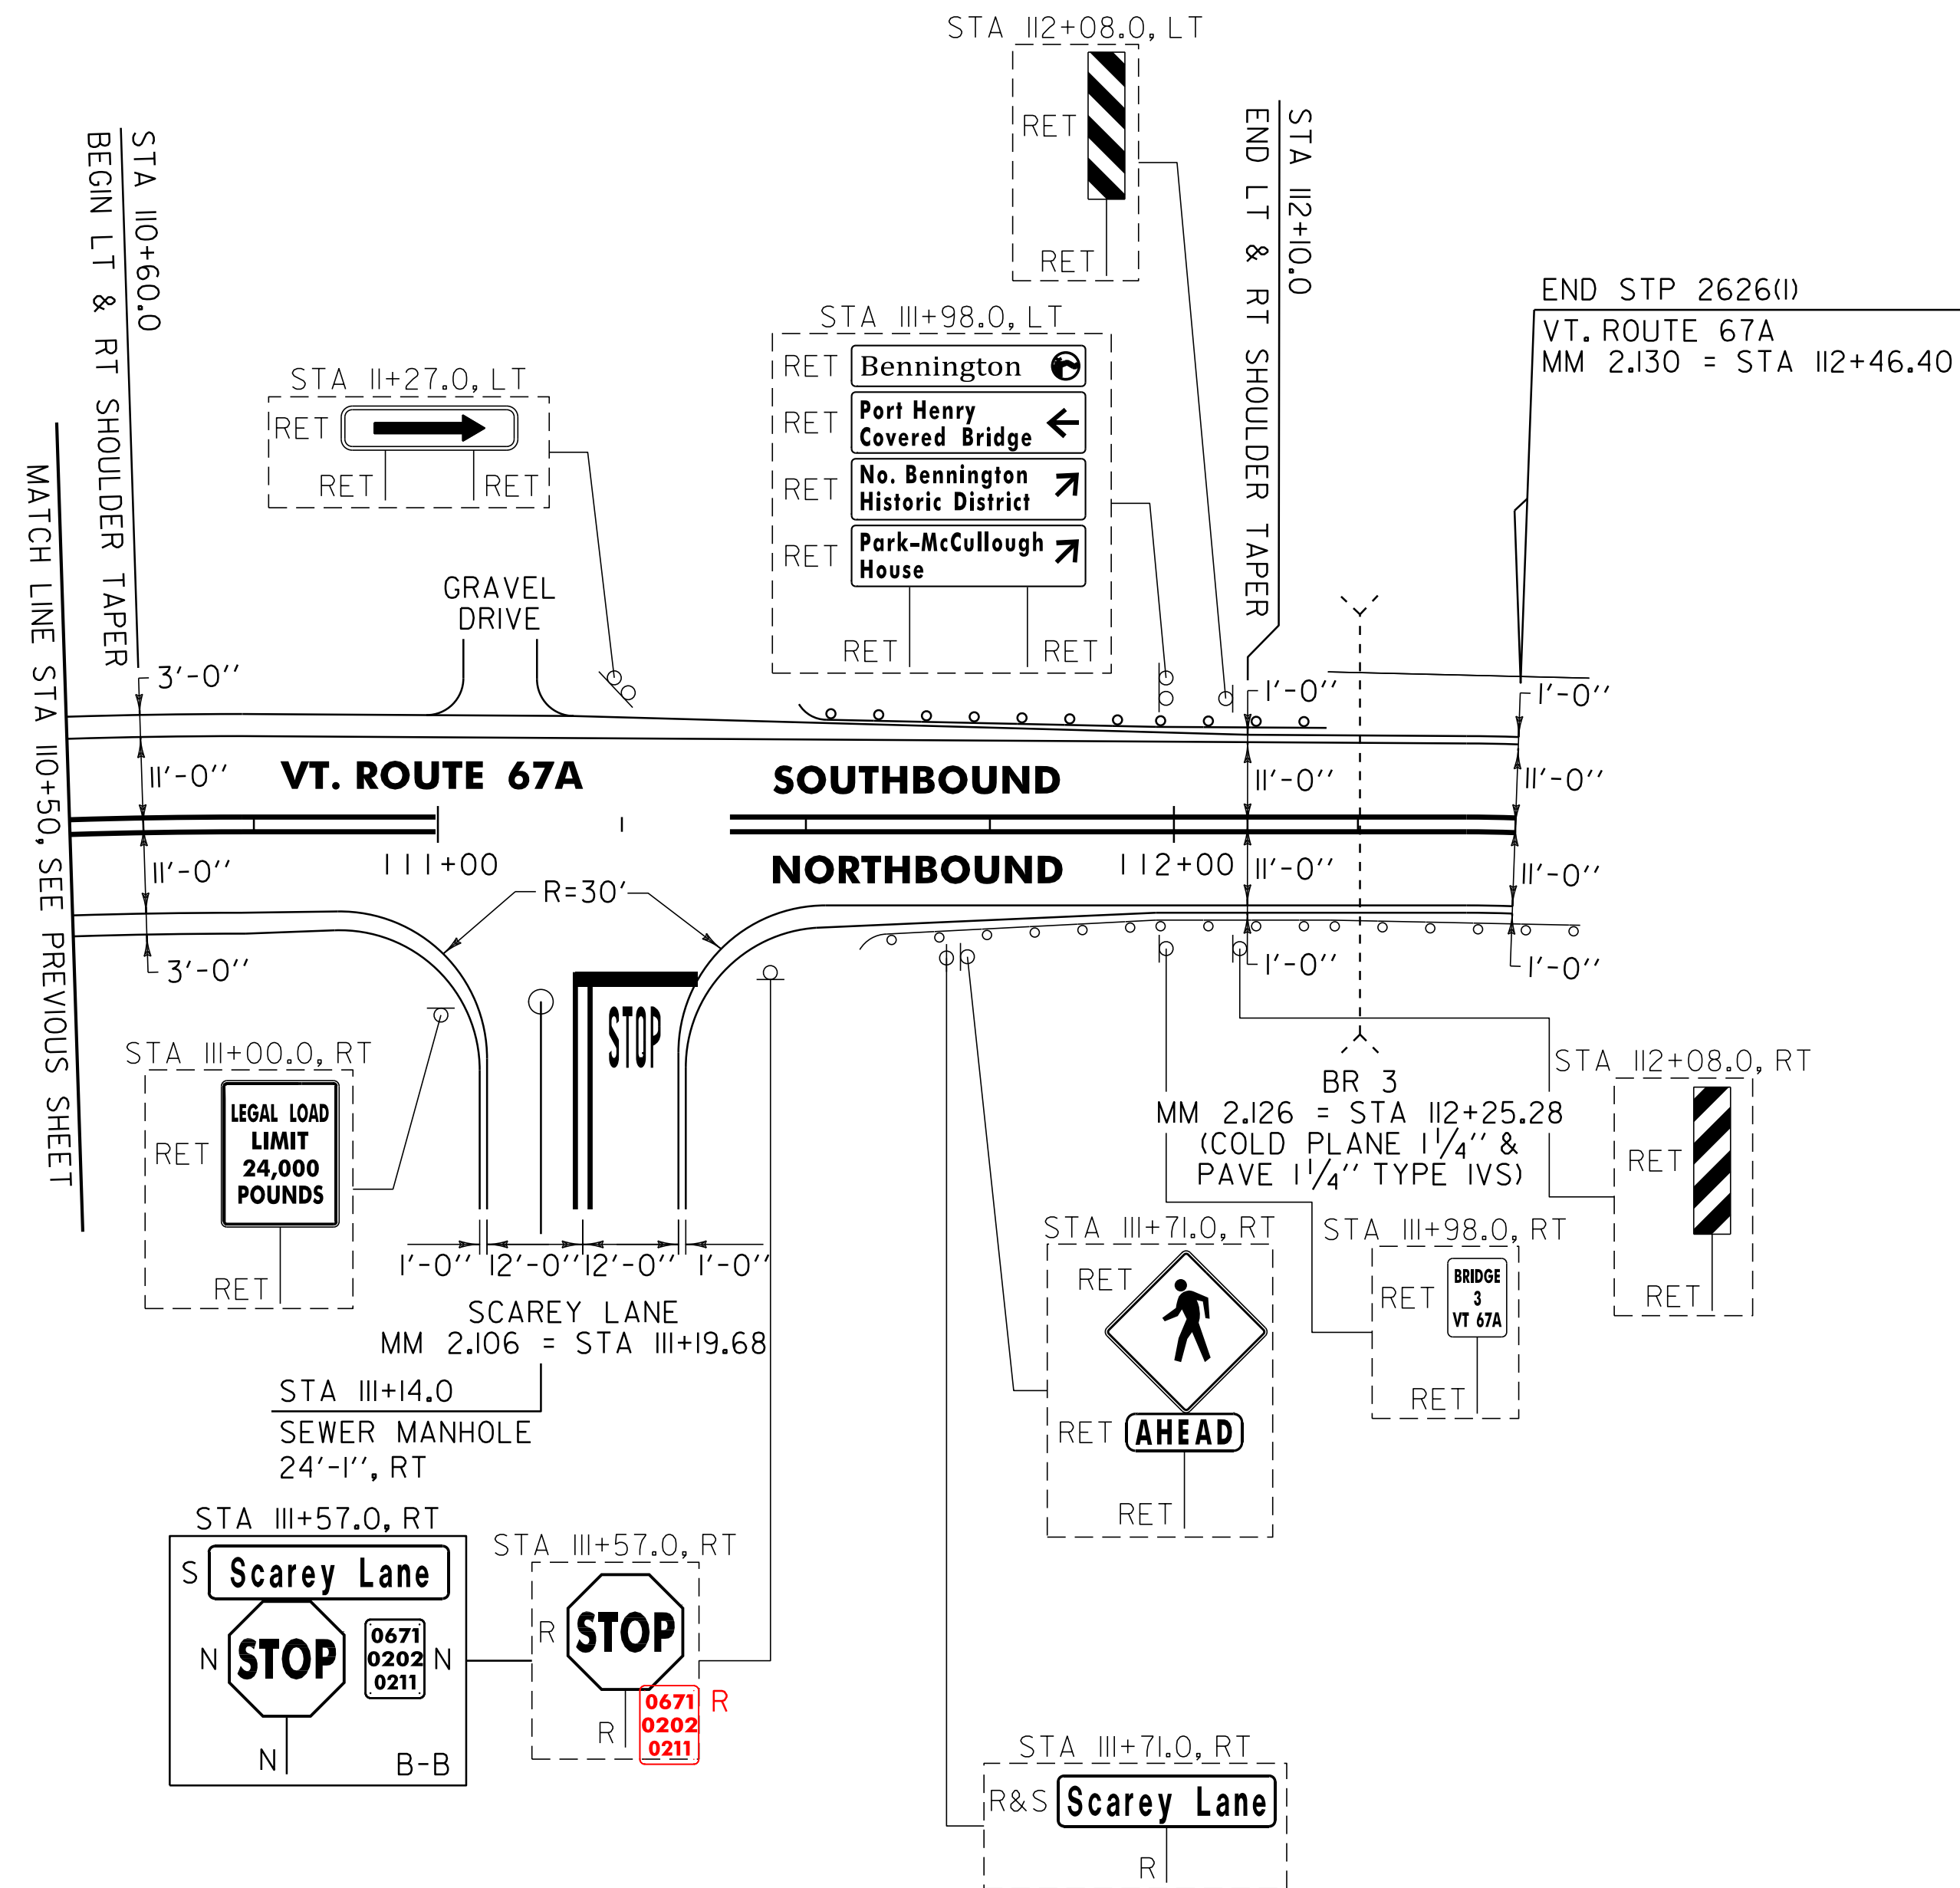

604.42 CHANGING ELEVATION OF SEWER MANHOLES
 VT. ROUTE 67A:
 STA 111+14.0 RT • SEE NOTE,
 SHEET 19

NOTES:

- COLD PLANING AND PAVING LIMIT ON ALL TOWN HIGHWAYS SHALL BE MEASURED 25 FT BACK FROM VT. ROUTE 67A EDGE OF SHOULDER UNLESS DENOTED OTHERWISE ON THE PLANS OR AS DIRECTED BY THE RESIDENT ENGINEER.
- SEE SHEETS 49 & 50 FOR BR 3 DETAILS.

SIGN LEGEND

R = REMOVE
 S = SALVAGE
 N = NEW
 RET = RETAIN
 B-B = BACK TO BACK
 EXISTING = - - - - -
 NEW = _____

NOT TO SCALE

PROJECT LAYOUT SHEET #22	PROJECT NAME: BENNINGTON	PLOT DATE: 07-MAY-2012 14:2
	PROJECT NUMBER: STP 2626(1)	DRAWN BY: C.A.K.
	FILE NAME: p06b220.dgn	CHECKED BY: D.E.G.
	PROJECT LEADER: D.E.G.	SHEET 40 OF 69
	DESIGNED BY: M.J.L.	
	DWG. NO. p06b220122.i	