

646.402 DURABLE 4 INCH WHITE LINE, THERMOPLASTIC
 (ALL LINES WILL INCLUDE EDGE LINE BREAKS AND RADIUS FOR TOWN HIGHWAYS)
 VT. ROUTE 67:
 STA 16+00.00 - STA 21+00.00 EDGE LINE LT/RT

646.412 DURABLE 4 INCH YELLOW LINE, THERMOPLASTIC
 (ALL LINES WILL INCLUDE C/L BREAKS FOR TOWN HIGHWAYS) S=SOLID, D=DASHED
 VT. ROUTE 67:
 STA 16+00.00 - STA 21+00.00 LT C RT
 S - S


646.602 TEMPORARY 4 INCH WHITE LINE, PAINT
 (ALL LINES WILL INCLUDE EDGE LINE BREAKS AND RADIUS FOR TOWN HIGHWAYS)
 VT. ROUTE 67:
 STA 16+00.00 - STA 21+00.00 EDGE LINE LT/RT

646.612 TEMPORARY 4 INCH YELLOW LINE, PAINT
 (ALL LINES WILL INCLUDE C/L BREAKS FOR TOWN HIGHWAYS) S=SOLID, D=DASHED
 VT. ROUTE 67:
 STA 16+00.00 - STA 21+00.00 LT C RT
 S - S

646.502 DURABLE CROSSWALK MARKING, THERMOPLASTIC
 VT. ROUTE 67:
 STA 19+99.00 LT/RT
 STA 20+16.96 RT, SCHOOL STREET

675.50 REMOVING SIGNS AS SHOWN - #12

646.702 TEMPORARY CROSSWALK MARKING, PAINT
 VT. ROUTE 67:
 STA 19+99.00 LT/RT
 STA 20+16.96 RT, SCHOOL STREET

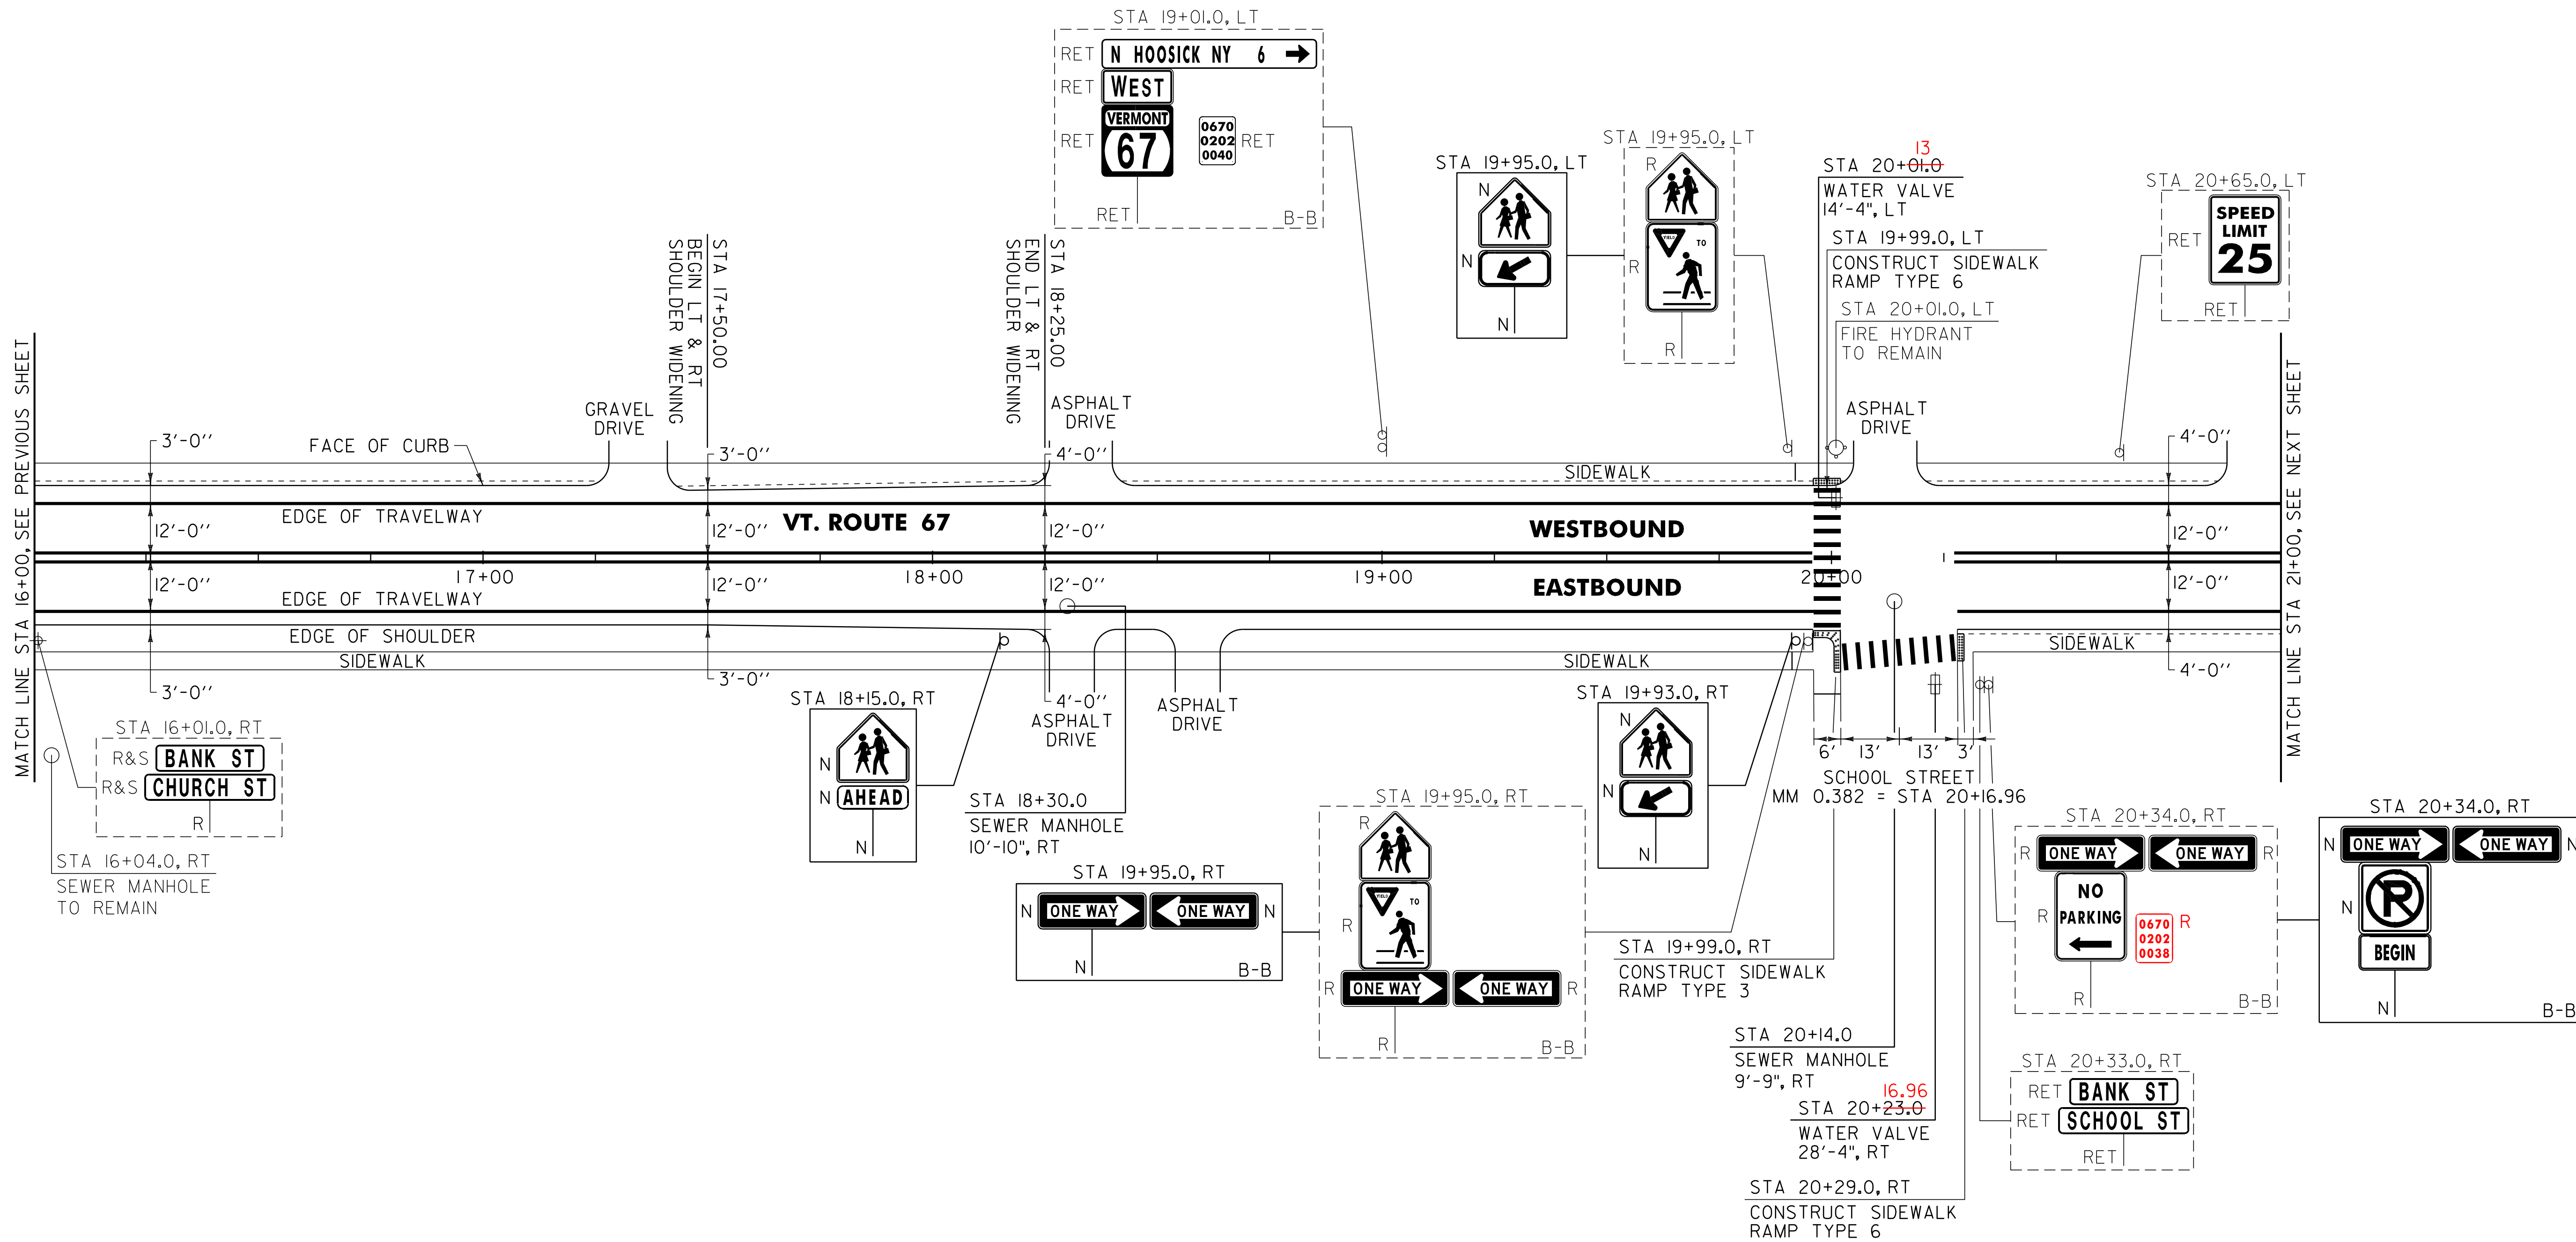

~~604.42 CHANGING ELEVATION OF SEWER MANHOLES
 VT. ROUTE 67:
 STA 18+30.0 RT
 STA 20+14.0 RT~~
 SEE NOTE, SHEET 19

629.20 ADJUST ELEVATION OF VALVE BOX
 VT. ROUTE 67:
 STA 20+01.0 LT 20+13 LT
 STA 20+23.0 RT 20+16.96 RT

NOTE:

I. COLD PLANING AND PAVING LIMIT ON ALL TOWN HIGHWAYS SHALL BE MEASURED 25 FT BACK FROM VT. ROUTE 67 EDGE OF SHOULDER UNLESS DENOTED OTHERWISE ON THE PLANS OR AS DIRECTED BY THE RESIDENT ENGINEER.

SIGN LEGEND
 R = REMOVE
 S = SALVAGE
 N = NEW
 RET = RETAIN
 B-B = BACK TO BACK
 EXISTING =
 NEW =

NOT TO SCALE

PROJECT LAYOUT SHEET #3	PROJECT NAME: BENNINGTON (NORTH BENNINGTON) CLASS I	FILE NAME: p06b212.dgn	PLOT DATE: 07-MAY-2012 14:2
	PROJECT NUMBER: STP 2622(1)	PROJECT LEADER: D.E.G.	DRAWN BY: C.A.K.
		DESIGNED BY: M.J.M.	CHECKED BY: R.A.B.
		DWG. NO. p06b21213.i	SHEET 59 OF 69