

646.400 DURABLE 4 INCH WHITE LINE
 (ALL LINES WILL INCLUDE EDGE LINE BREAKS AND RADIUS FOR TOWN HIGHWAYS)
 VT. ROUTE 67:
 STA 21+25.00 - STA 24+25.00 EDGE LINE LT/RT

646.600 TEMPORARY 4 INCH WHITE LINE
 (ALL LINES WILL INCLUDE EDGE LINE BREAKS AND RADIUS FOR TOWN HIGHWAYS)
 VT. ROUTE 67:
 STA 21+25.00 - STA 24+25.00 EDGE LINE LT/RT

646.410 DURABLE 4 INCH YELLOW LINE
 (ALL LINES WILL INCLUDE C/L BREAKS FOR TOWN HIGHWAYS) S=SOLID, D=DASHED
 VT. ROUTE 67:
 STA 21+25.00 - STA 22+30.00 S - S
 STA 23+90.00 - STA 24+25.00 S - S
 STA 22+30.00 - STA 23+15.00 DOUBLE SOLID MEDIAN EDGE LINE LT
 STA 23+15.00 - STA 23+82.00 DOTTED LANE LINE LT

646.610 TEMPORARY 4 INCH YELLOW LINE
 (ALL LINES WILL INCLUDE C/L BREAKS FOR TOWN HIGHWAYS) S=SOLID, D=DASHED
 VT. ROUTE 67:
 STA 21+25.00 - STA 22+30.00 S - S
 STA 23+90.00 - STA 24+25.00 S - S
 STA 22+30.00 - STA 23+15.00 DOUBLE SOLID MEDIAN EDGE LINE LT
 STA 23+15.00 - STA 23+82.00 DOTTED LANE LINE LT

646.402 DURABLE 4 INCH WHITE LINE, THERMOPLASTIC
 (ALL LINES WILL INCLUDE EDGE LINE BREAKS AND RADIUS FOR TOWN HIGHWAYS)
 VT. ROUTE 67:
 STA 21+00.00 - STA 21+25.00 EDGE LINE LT/RT
 STA 24+25.00 - STA 25+00.00 EDGE LINE LT/RT

646.602 TEMPORARY 4 INCH WHITE LINE, PAINT
 (ALL LINES WILL INCLUDE EDGE LINE BREAKS AND RADIUS FOR TOWN HIGHWAYS)
 VT. ROUTE 67:
 STA 21+00.00 - STA 21+25.00 EDGE LINE LT/RT
 STA 24+25.00 - STA 25+00.00 EDGE LINE LT/RT

646.412 DURABLE 4 INCH YELLOW LINE, THERMOPLASTIC
 (ALL LINES WILL INCLUDE C/L BREAKS FOR TOWN HIGHWAYS) S=SOLID, D=DASHED
 VT. ROUTE 67:
 STA 21+00.00 - STA 21+25.00 S - S
 STA 24+25.00 - STA 25+00.00 S - S

646.612 TEMPORARY 4 INCH YELLOW LINE, PAINT
 (ALL LINES WILL INCLUDE C/L BREAKS FOR TOWN HIGHWAYS) S=SOLID, D=DASHED
 VT. ROUTE 67:
 STA 21+00.00 - STA 21+25.00 S - S
 STA 24+25.00 - STA 25+00.00 S - S

646.450 DURABLE 8 INCH YELLOW LINE
 VT. ROUTE 67:
 STA 22+25.00 - STA 23+83.00 LT, SHOULDER HATCHING
 STA 22+65.00 - STA 23+30.00 RT, SHOULDER HATCHING

646.450 DURABLE 8 INCH YELLOW LINE
 VT. ROUTE 67:
 STA 22+30.00 - STA 23+15.00 LT, MEDIAN HATCHING

646.480 DURABLE 24 INCH STOP BAR
 VT. ROUTE 67:
 STA 23+39.04 RT, HOUGHTON STREET

646.680 TEMPORARY 24 INCH STOP BAR
 VT. ROUTE 67:
 STA 23+39.04 RT, HOUGHTON STREET

646.490 DURABLE LETTER OR SYMBOL
 VT. ROUTE 67:
 STA 23+10.00 RT, YIELD MARKINGS (8 EA)
 STA 23+39.04 RT, HOUGHTON STREET, "S,T,O,P" (4 EA)

646.690 TEMPORARY LETTER OR SYMBOL
 VT. ROUTE 67:
 STA 23+10.00 RT, YIELD MARKINGS (16 EA)
 STA 23+39.04 RT, HOUGHTON STREET, "S,T,O,P" (8 EA)

646.492 DURABLE LETTER OR SYMBOL, THERMOPLASTIC
 VT. ROUTE 67:
 STA 24+54.00 RT, HANDICAP SYMBOL (1 EA)



646.692 TEMPORARY LETTER OR SYMBOL, PAINT
 VT. ROUTE 67:
 STA 24+54.00 RT, HANDICAP SYMBOL (2 EA)

646.500 DURABLE CROSSWALK MARKING
 VT. ROUTE 67:
 STA 23+39.04 RT, HOUGHTON STREET
 STA 23+86.00 LT/RT

646.700 TEMPORARY CROSSWALK MARKING
 VT. ROUTE 67:
 STA 23+39.04 RT, HOUGHTON STREET
 STA 23+86.00 LT/RT

675.50 REMOVING SIGNS
 AS SHOWN - 12-10

675.60 ERECTING SALVAGED SIGNS
 AS SHOWN - 2

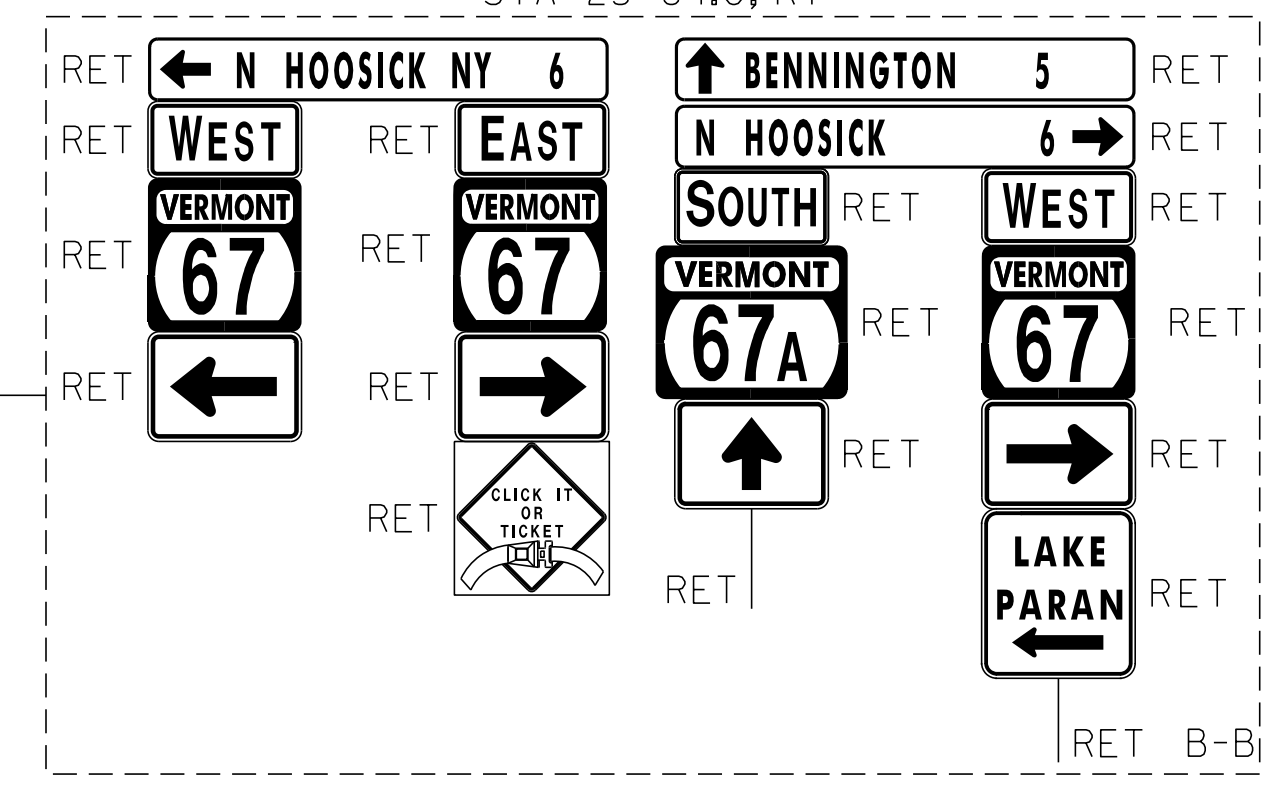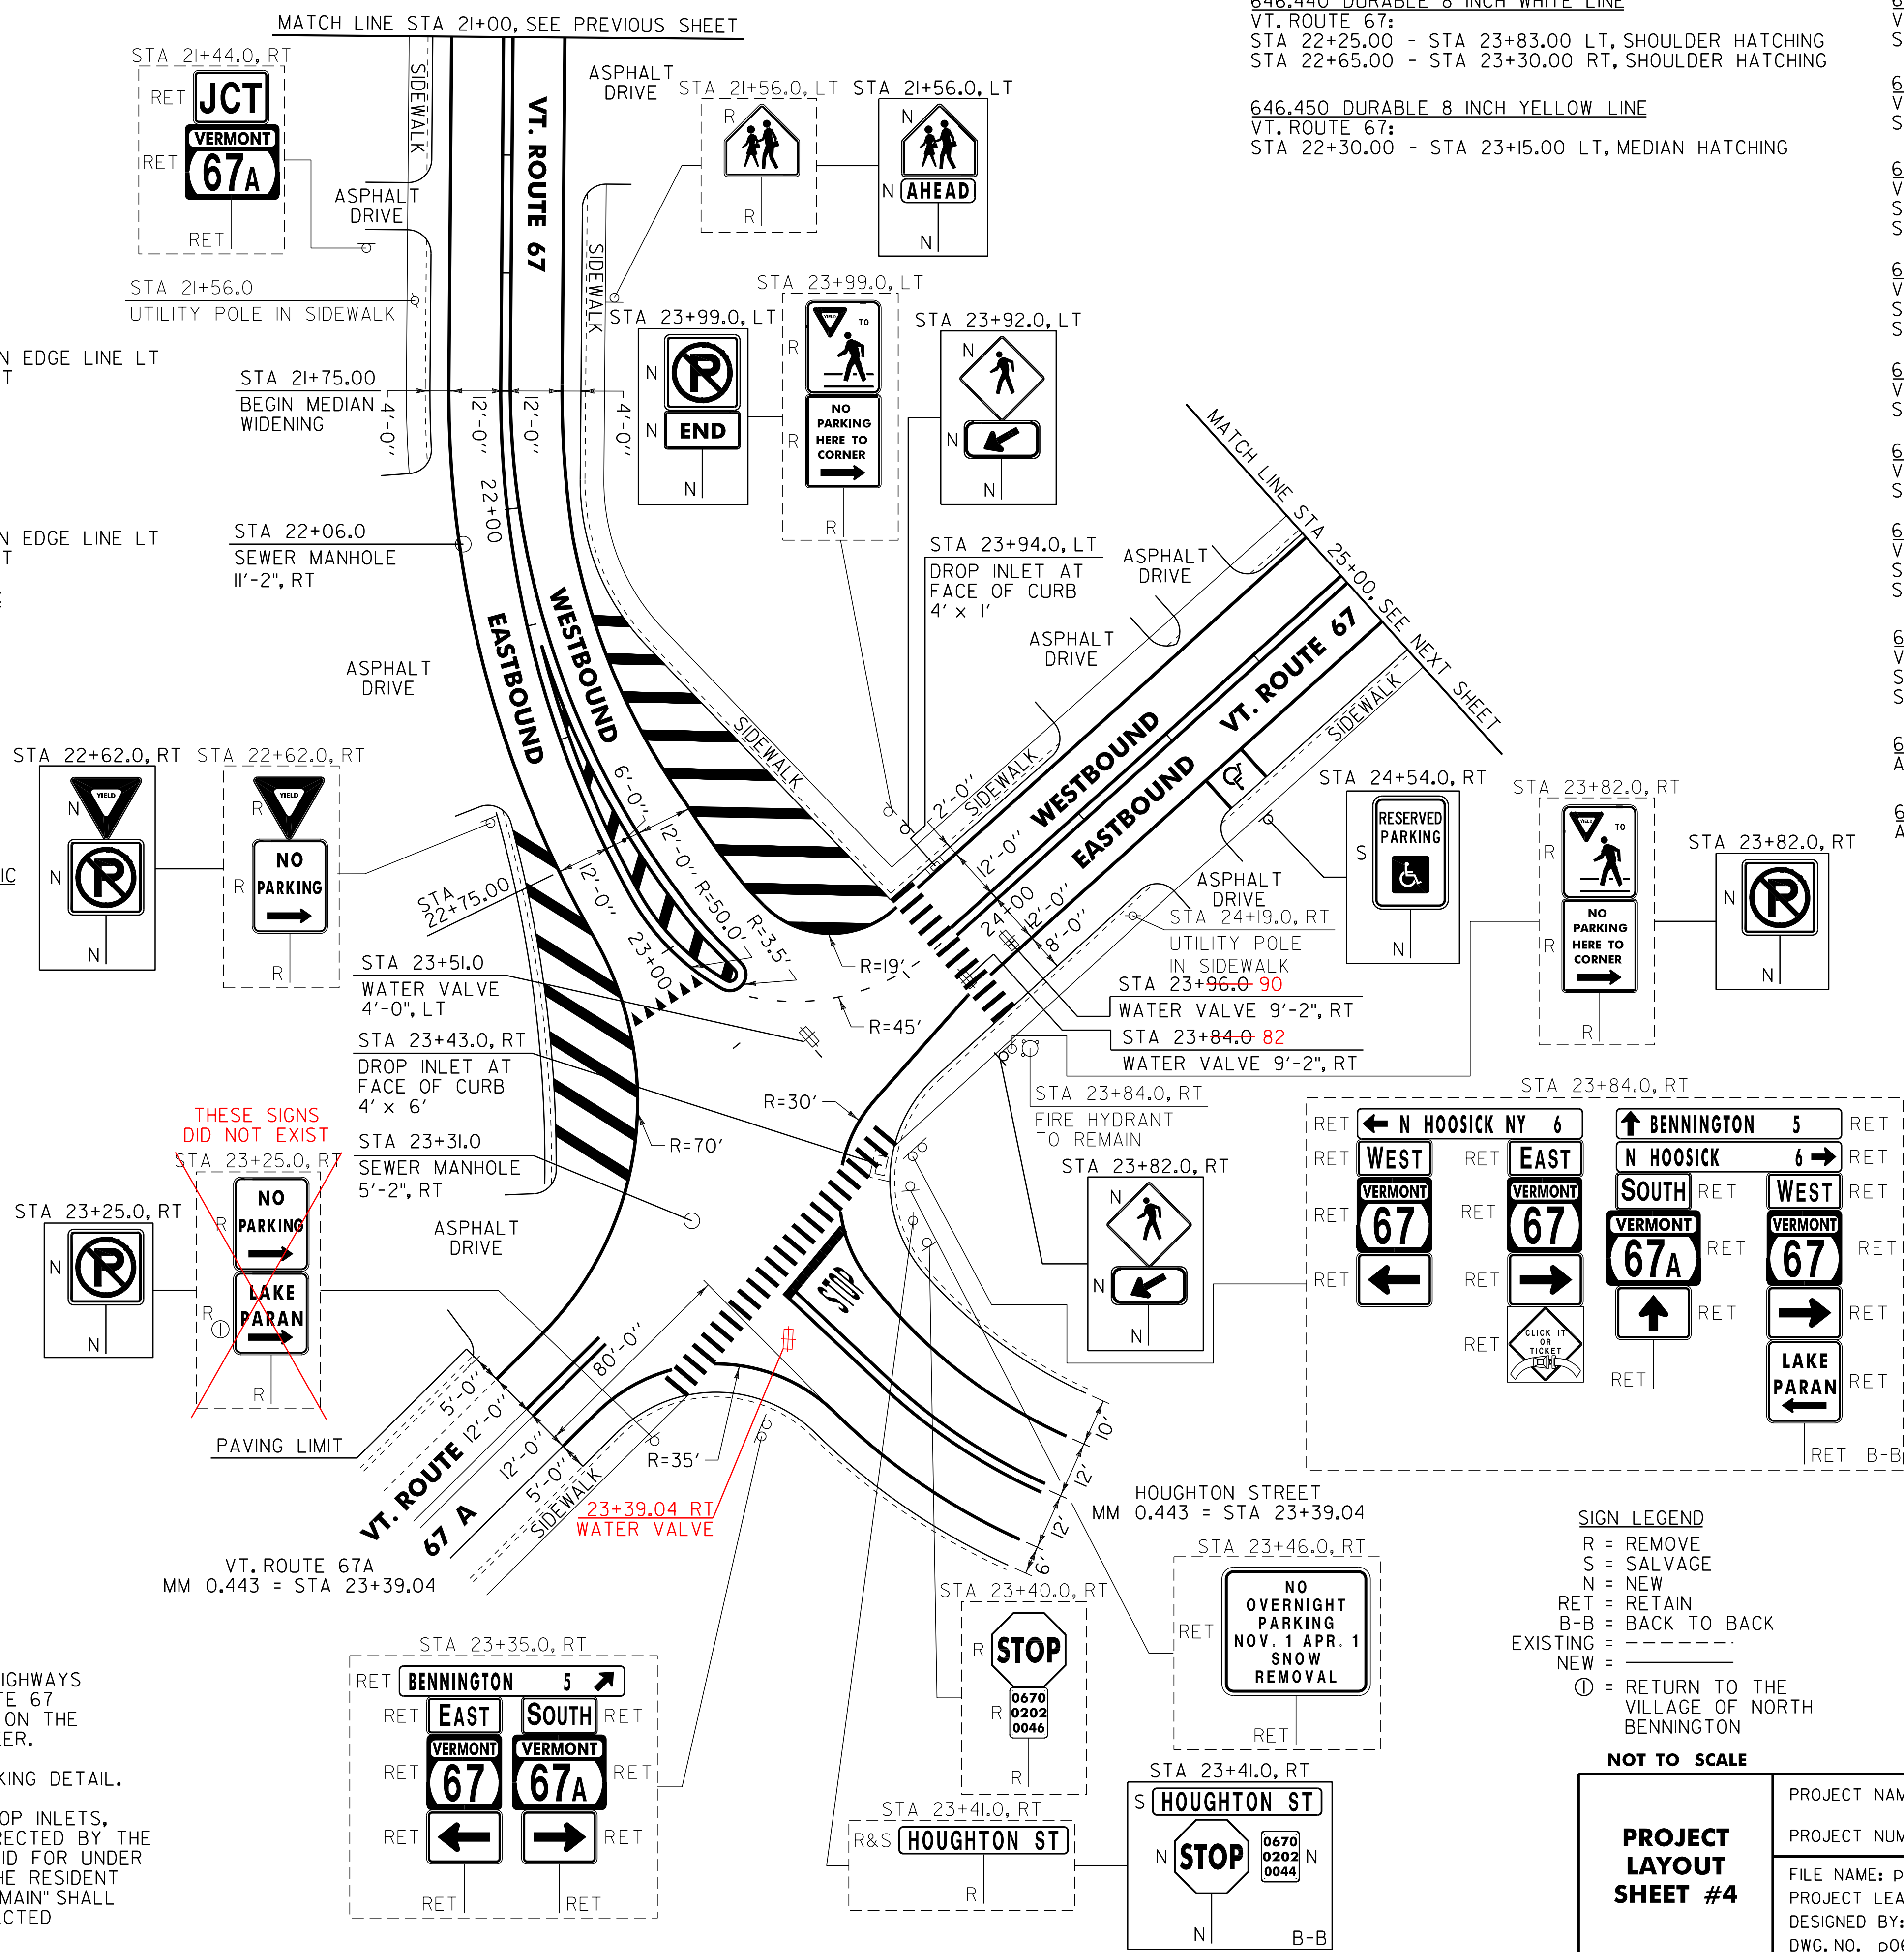

SIGN LEGEND
 R = REMOVE
 S = SALVAGE
 N = NEW
 RET = RETAIN
 B-B = BACK TO BACK
 EXISTING = - - - - -
 NEW = _____
 ⊙ = RETURN TO THE VILLAGE OF NORTH BENNINGTON

NOT TO SCALE

~~604.412, 604.415 OR 604.418 REHAB. DROP INLETS, CATCH BASINS OR MANHOLES (SEE NOTE 3)~~
 VT. ROUTE 67:
 STA 23+43.0 RT
 STA 23+94.0 LT

~~604.42 CHANGING ELEVATION OF SEWER MANHOLES~~
 VT. ROUTE 67:
 STA 22+06.0 RT * SEE NOTE, SHEET 19
 STA 23+31.0 RT

~~629.20 ADJUST ELEVATION OF VALVE BOX~~
 VT. ROUTE 67:
 STA 23+51.0 LT 23+39.04 RT
 STA 23+84.0 RT 23+82 RT
 STA 23+96.0 RT 23+90 RT

NOTES:

- COLD PLANING AND PAVING LIMIT ON ALL TOWN HIGHWAYS SHALL BE MEASURED 25 FT BACK FROM VT. ROUTE 67 EDGE OF SHOULDER UNLESS DENOTED OTHERWISE ON THE PLANS OR AS DIRECTED BY THE RESIDENT ENGINEER.
- SEE SHEET 8 FOR FIRE HYDRANT PAVEMENT MARKING DETAIL.
- THE CONTRACTOR SHALL REHAB. THE EXISTING DROP INLETS, CATCH BASINS OR MANHOLES TO A DEPTH AS DIRECTED BY THE RESIDENT ENGINEER. ALL REHAB. WORK WILL BE PAID FOR UNDER THE APPLICABLE REHAB. ITEM AS DIRECTED BY THE RESIDENT ENGINEER. ALL EXISTING UTILITIES MARKED "TO REMAIN" SHALL NOT BE ALTERED OR REHABILITATED UNLESS DIRECTED OTHERWISE BY THE RESIDENT ENGINEER.

PROJECT LAYOUT SHEET #4	PROJECT NAME: BENNINGTON (NORTH BENNINGTON) CLASS I
	PROJECT NUMBER: STP 2622(1)
	FILE NAME: p06b212.dgn PROJECT LEADER: D.E.G. DESIGNED BY: M.J.M. DWG. NO. p06b21214.i