

646.402 DURABLE 4 INCH WHITE LINE, THERMOPLASTIC  
 (ALL LINES WILL INCLUDE EDGE LINE BREAKS AND RADIUS FOR TOWN HIGHWAYS)  
 VT. ROUTE 67:  
 STA 30+00.00 - STA 30+42.00 EDGE LINE LT/RT  
 STA 30+86.00 - STA 35+05.92 EDGE LINE LT/RT

646.412 DURABLE 4 INCH YELLOW LINE, THERMOPLASTIC  
 (ALL LINES WILL INCLUDE C/L BREAKS FOR TOWN HIGHWAYS) S=SOLID, D=DASHED  
 VT. ROUTE 67:  
 STA 30+00.00 - STA 30+42.00 S - S  
 STA 30+86.00 - STA 35+05.92 S - S


646.602 TEMPORARY 4 INCH WHITE LINE, PAINT  
 (ALL LINES WILL INCLUDE EDGE LINE BREAKS AND RADIUS FOR TOWN HIGHWAYS)  
 VT. ROUTE 67:  
 STA 30+00.00 - STA 30+42.00 EDGE LINE LT/RT  
 STA 30+86.00 - STA 35+05.92 EDGE LINE LT/RT

646.612 TEMPORARY 4 INCH YELLOW LINE, PAINT  
 (ALL LINES WILL INCLUDE C/L BREAKS FOR TOWN HIGHWAYS) S=SOLID, D=DASHED  
 VT. ROUTE 67:  
 STA 30+00.00 - STA 30+42.00 S - S  
 STA 30+86.00 - STA 35+05.92 S - S

646.512 DURABLE RAILROAD CROSSING SYMBOL, THERMOPLASTIC  
 VT. ROUTE 67:  
 STA 33+10.0 LT (1EA)

646.712 TEMPORARY RAILROAD CROSSING SYMBOL, PAINT  
 VT. ROUTE 67:  
 STA 33+10.0 LT (2 EA)

675.50 REMOVING SIGNS  
 AS SHOWN - 4-6

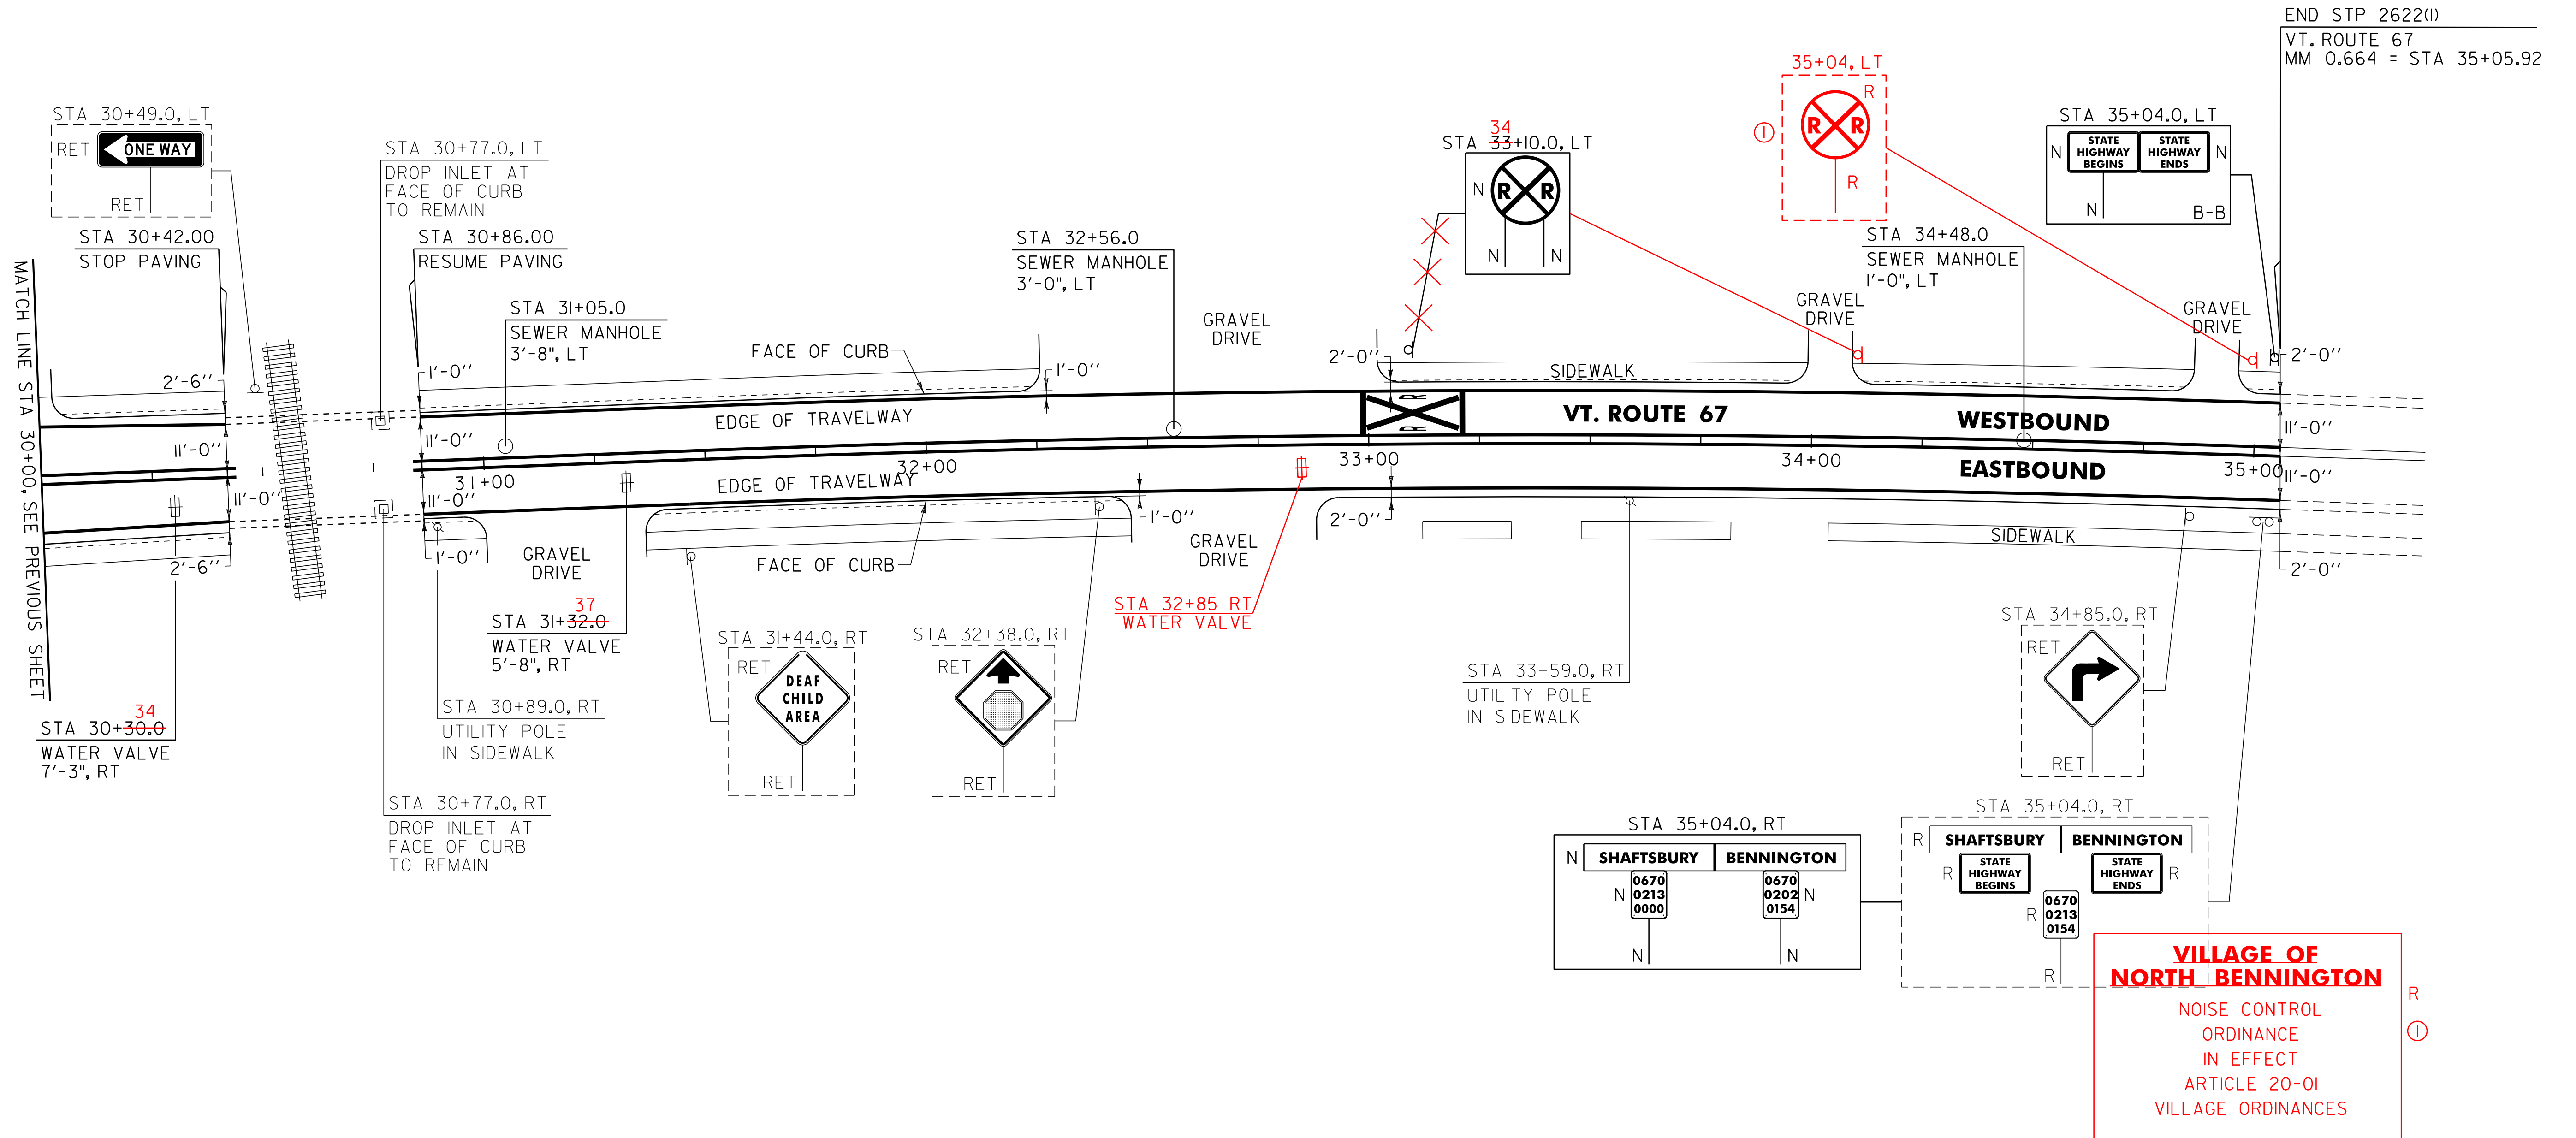

~~604.42 CHANGING ELEVATION OF SEWER MANHOLES~~  
 VT. ROUTE 67:  
~~STA 31+05.0 LT~~     • SEE NOTE, SHEET 19  
~~STA 32+56.0 LT~~  
~~STA 34+48.0 LT~~

629.20 ADJUST ELEVATION OF VALVE BOX  
 VT. ROUTE 67:  
~~STA 30+30.0 RT~~ 30+34 RT     32+85 RT  
~~STA 31+32.0 RT~~ 31+37 RT

**SIGN LEGEND**  
 R = REMOVE  
 S = SALVAGE  
 N = NEW  
 RET = RETAIN  
 B-B = BACK TO BACK  
 EXISTING = \_\_\_\_\_  
 NEW = \_\_\_\_\_

NOT TO SCALE

**PROJECT SHEET #6**

PROJECT NAME: BENNINGTON (NORTH BENNINGTON) CLASS I  
 PROJECT NUMBER: STP 2622(II)  
 FILE NAME: p06b212.dgn  
 PROJECT LEADER: D.E.G.  
 DESIGNED BY: M.J.M.  
 DWG. NO. p06b21216.i  
 PLOT DATE: 07-MAY-2012 14:2  
 DRAWN BY: C.A.K.  
 CHECKED BY: R.A.B.  
 SHEET 62 OF 69

① = RETURN TO THE VILLAGE OF NORTH BENNINGTON